
← 52' →

Acknowledgment of Plans Submittal ONLY
Date 6-15-14
Date 8/15/14

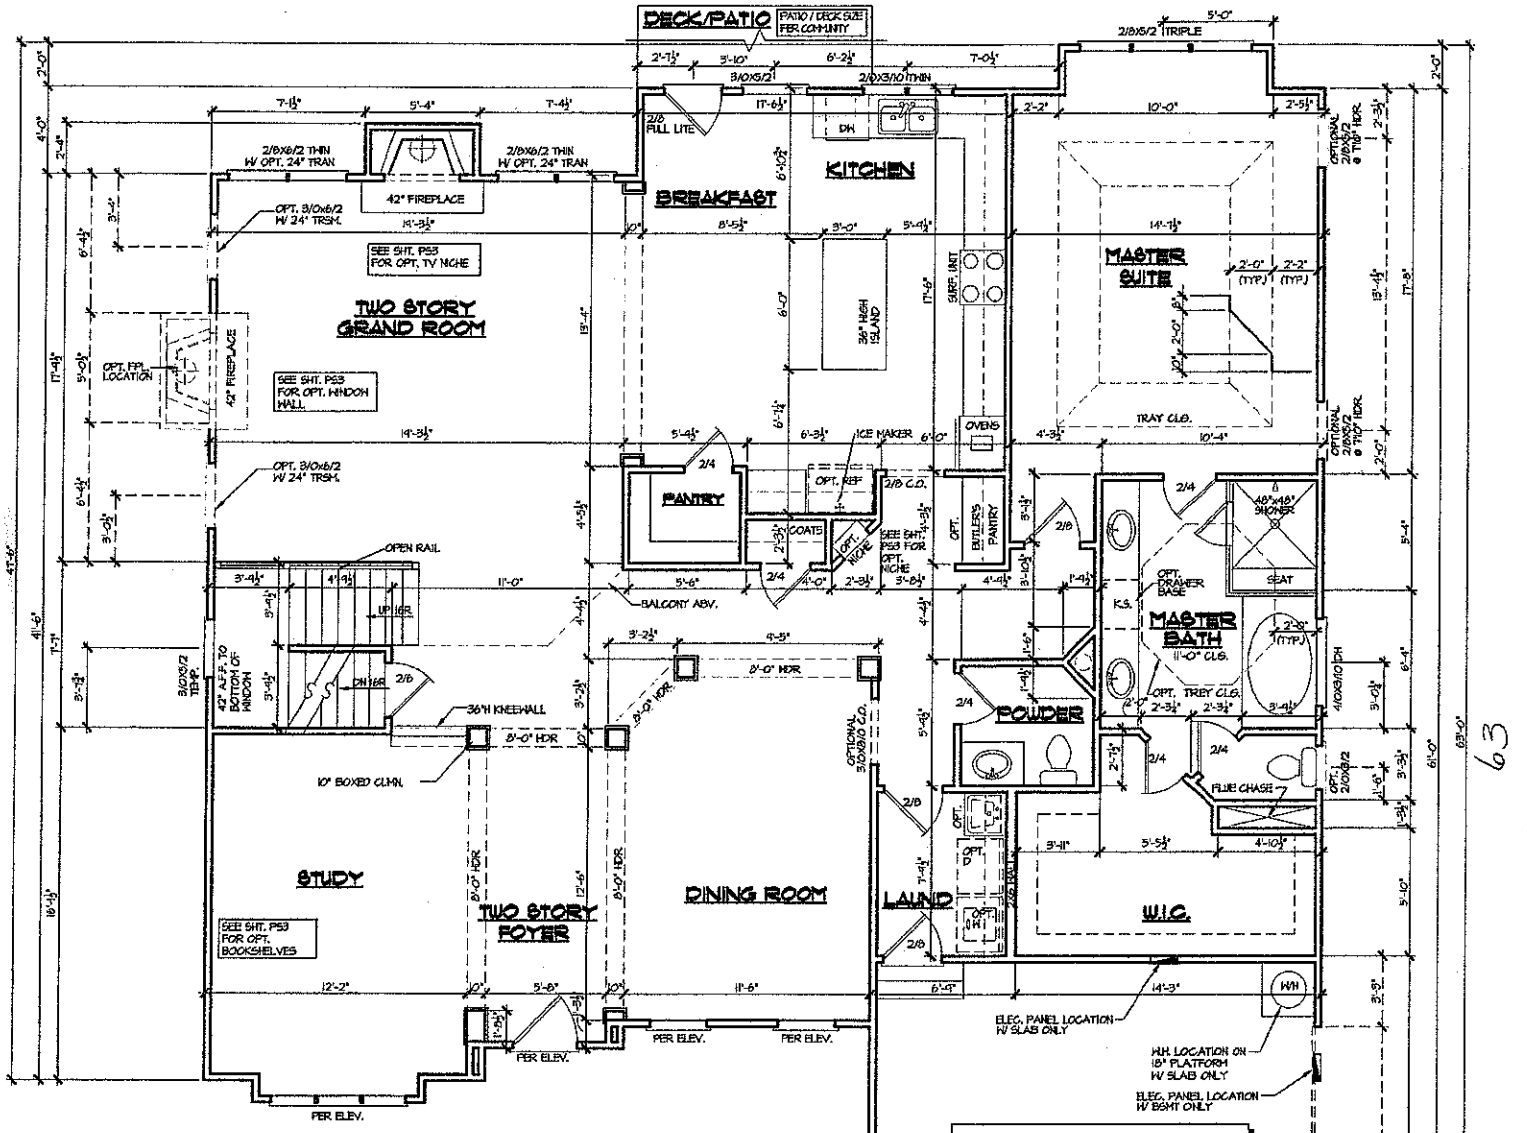

SQUARE FOOTAGE

FIRST FLOOR	2162 S.F.
SECOND FLOOR	1018 S.F.
TOTAL	3180 S.F.
BONUS ROOM	408 S.F.
GARAGE	434 S.F.

NOTE:
SEE FACADE PLAN ON SHEET A4.1 FOR PLAN AND PORCH DIMENSIONS, WINDOW AND DOOR SIZES AND LOCATION.

ALTERNATE FIRST FLOOR PLAN

SCALE: 1/4" = 1'-0"

PEACHTREE RESIDENTIAL PROPERTIES
The Builder Who Listens
7880 McGinnis Ferry Rd. • Suwanee, Georgia 30174
Voice (770) 622-2622 • Fax (770) 622-9171

This drawing is the property of Peachtree Residential Properties and may not be copied or reproduced without the written permission of Peachtree Residential Properties.


Drawn By: J.S
Date: 08/02/05
Plan No:

Revision:
09/29/06 J.S
10/06/06 J.S
04162D-3451

Model Name: ALEXANDRIA

Sheet Title: PLAN SPECIFIC OPTIONS

SHEET NO. PS4

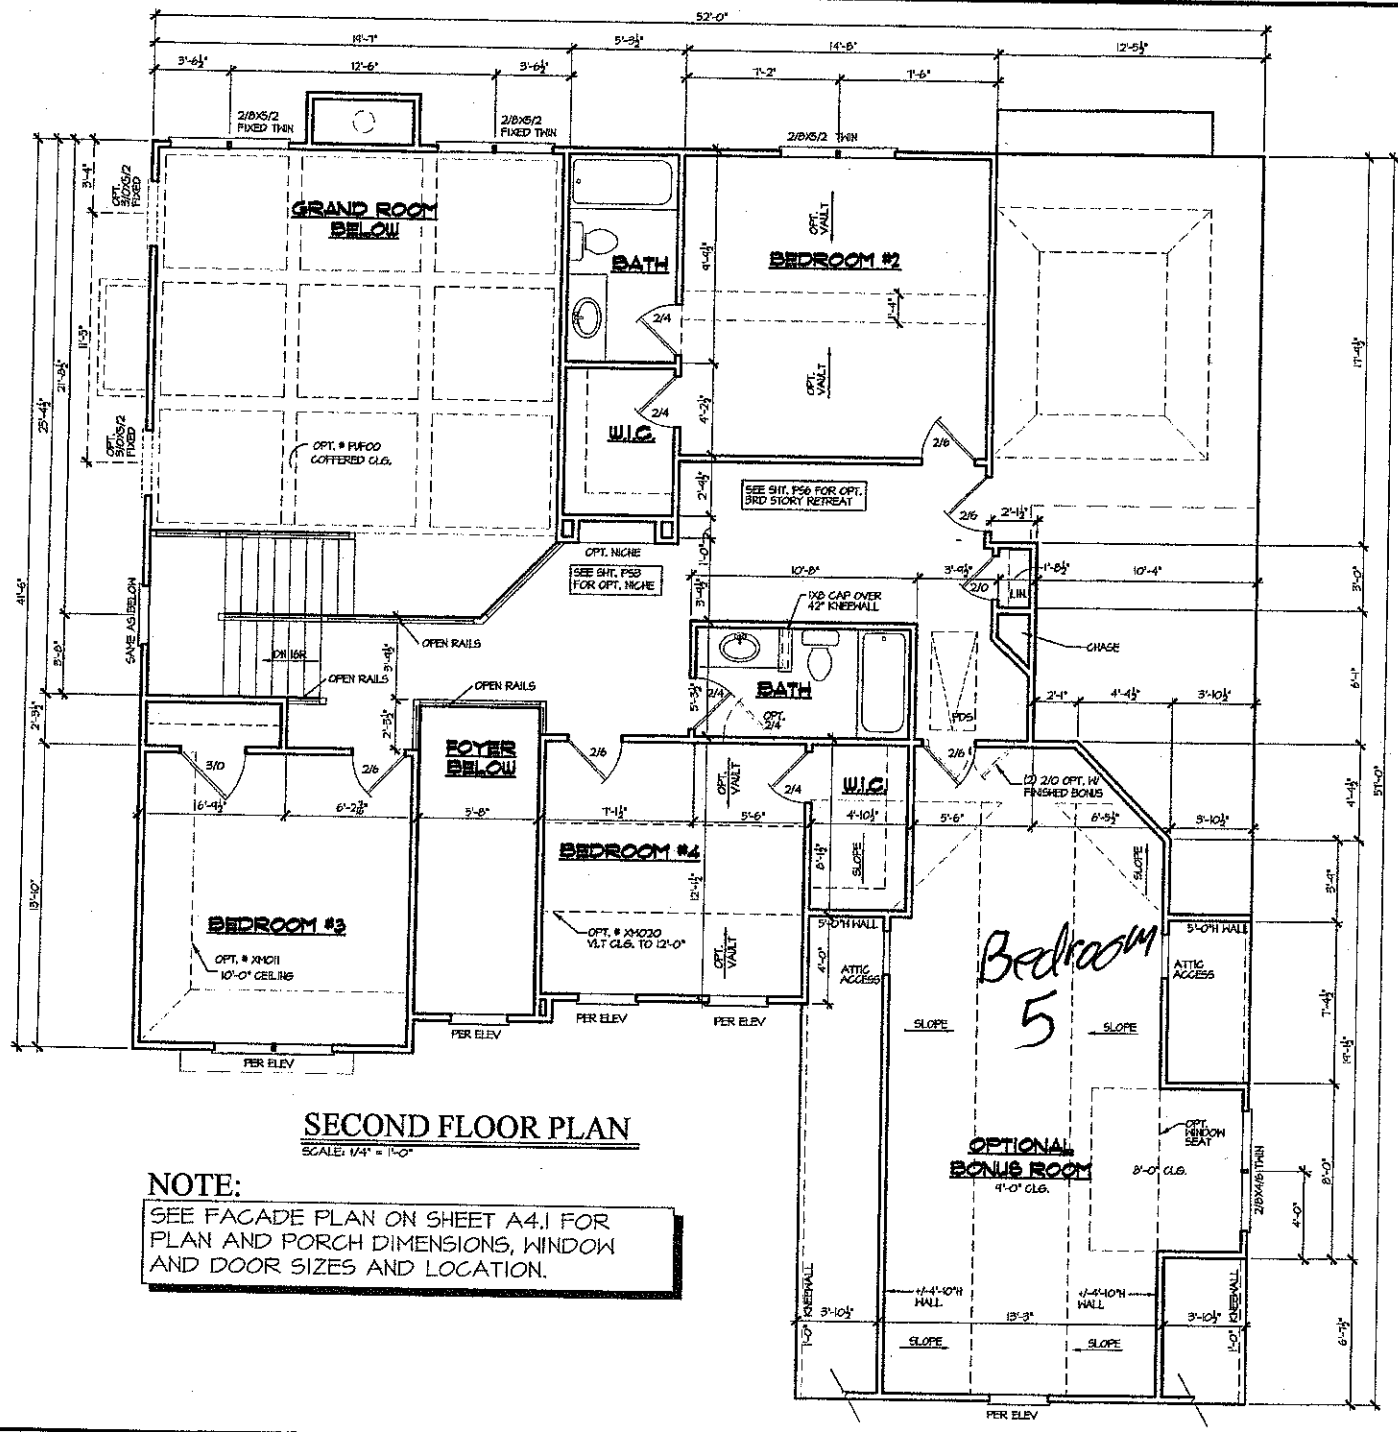

SECOND FLOOR PLAN

SCALE: 1/4" = 1'-0"

NOTE:

SEE FACADE PLAN ON SHEET A4.1 FOR PLAN AND PORCH DIMENSIONS, WINDOW AND DOOR SIZES AND LOCATION.

As-Constructed
Plans Submitted ONLY
Date 8-15-14

PEACHTREE RESIDENTIAL PROPERTIES
The Builder Who Listens
7980 McGinnis Ferry Rd. Suwanee, Georgia 30174
Voice (770) 622-2822 • Fax (770) 622-9171


This drawing is the property of Peachtree Residential Properties and may not be copied or reproduced without the written permission of Peachtree Residential Properties.

Drawn By: RKB
Date: 10/11/03
Plan No:

Revision: 07/14/06 JLS C41608-3451


Model Name: ALEXANDRIA
Sheet Title: SECOND FLOOR PLAN

SHEET NO. A3.2

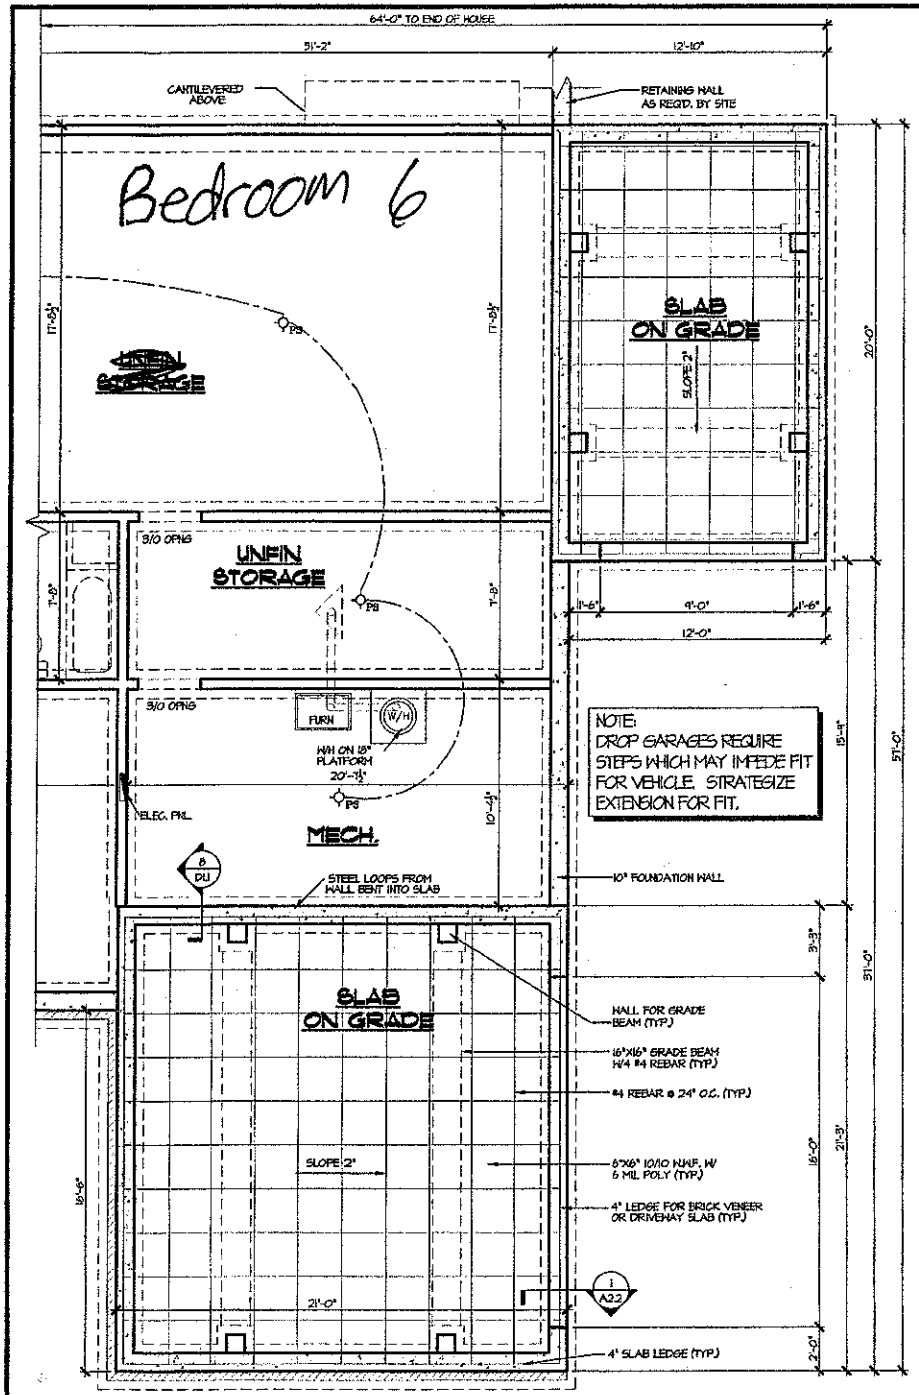

OPT. TANDEM GARAGE BASEMENT PLAN

SCALE: 1/4" = 1'-0"

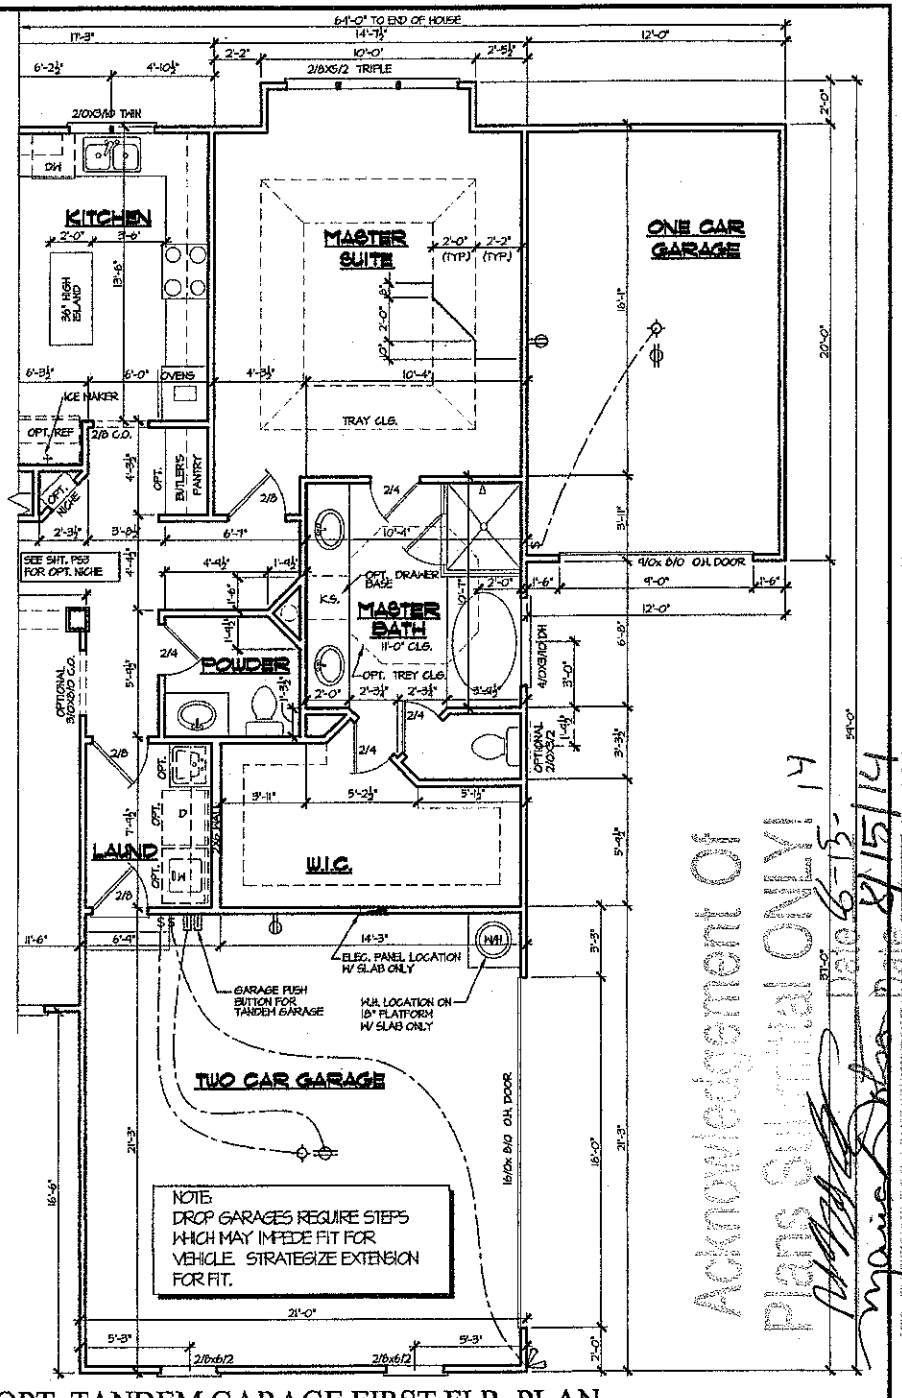

OPT. TANDEM GARAGE FIRST FLR. PLAN

SCALE: 1/4" = 1'-0"

Acknowledgment of Plans Initial ONLY

Page 6-13-14

8/15/14

PEACHTREE RESIDENTIAL PROPERTIES

The Builder Who Listens

7380 McGinnis Ferry Rd. Suwanee, Georgia 30174

Voice (770) 622-8922 • Fax (770) 622-8971

This drawing is the property of Peachtree Residential Properties and may not be copied or reproduced without the written permission of Peachtree Residential Properties.

Drawn By: JLS

Date: 10/06/06

Plan No:

041606-3451

Revision:

Model Name: ALEXANDRIA

Sheet Title: PLAN SPECIFIC OPTIONS

SHEET NO. PS7