IREDELL COUNTY HEALTH DEPARTMENT

STATESVILLE 704-878-5305 MOORESVILLE 704-664-5281

IMPROVEMENT PERMIT / CERTIFICATE OF COMPLETION / OPERATION PERMIT / EXISTING SYSTEM INSPECTION

PROPERTY DESCRIPTION NO. 18825 DATE Aug 17 '94 TAX MAP NO. 2623B47 463611 2023 Watershed: ☐ Yes ☐ No

OWNER OR CONTRACTOR Robert Ingraham Homes PHONE: Business 391-3715 Home

ADDRESS

LOCATION 1100 TL 1113 TR Cove Creek Rd. TL Wynwept TR Wynwood on Right

SUBDIVISION North Shore BLOCK / SECTION II LOT 47 LOT AREA SITE CLASS PSept. 1996 DESIGN FLOW 480gpd L.T.A.R. <3

Septic Tank: 1000 Gallons; STB 744 Kellinger Date 3-8-95

Pump Tank: 1000 Gallons; PT 27 Kellinger Date 3-5-95

Pump Make: Gobbs Model EP0411A Serial No. B9506357

Nitrification Field: No Fields 1 Square Feet 1600 Linear Feet 534

No Lines 7 Trench Width 36" Max Trench Bottom Depth 36" Gravel Depth 12"

☑ New System ☐ Repair System Type: I, II, III, IV, V, VI

System Description: pump-conv. pressure man

Repair System Description: SAME or LPPBPS

Maintenance Agreement Required: ☐ Yes ☑ No

☑ House/Mod. Home No. Bedrooms 4

☐ Mobile Home No. Bathrooms 2½

☐ Business No. Employees

☐ Other


☐ Slab ☑ Crawl Space ☐ Basement w/plumbing ☐ Basement wo/plumbing

Water Supply: ☐ Individual ☑ Community ☐ Public

Comments: Septic System installer to see me for details regarding pressure manifold prior to system construction. Intervals to follow contours.

Comments: Tanks OK, Infiltration Laterals (400' - 520')

INITIAL SITE SKETCH

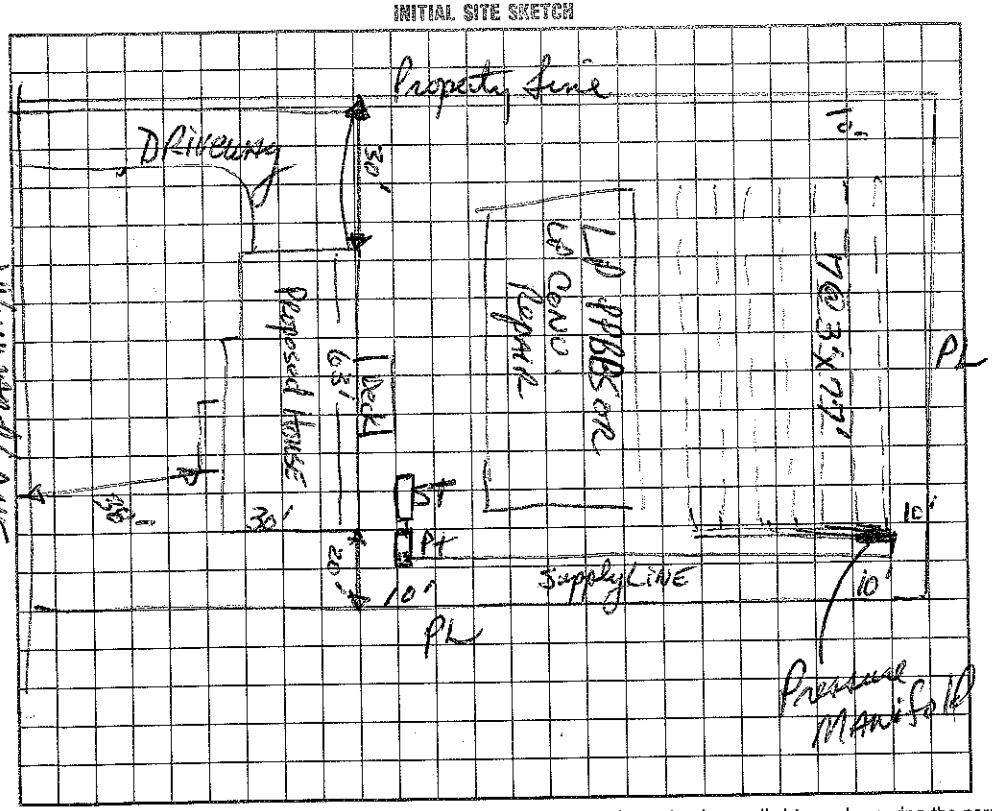

AS BUILT SKETCH

I understand that this permit can be suspended or revoked if any false information is supplied toward securing the permit/any unauthorized changes are made to the site/any unauthorized changes are made in the installation of the system. Improvement Permit is valid for 60 months from date of issuance.

Signed:

Improvement Permit by: Jason R Johnson IRS date 8/17/94

Existing System Inspection by: date

Installed by: Ken Painter / Cronhouse Grading

Certificate of Completion by: date

Operation Permit by: Jason R Johnson IRS date 6-9-95

HEALTH DEPT. COPY: WHITE INSPECTION COPY (FINAL): GREEN OWNER COPY (FINAL): YELLOW INSPECTION COPY (INITIAL): PINK OWNER COPY (INITIAL): GOLD