IREDELL COUNTY HEALTH DEPARTMENT

Statesville Office (704) 878-5305 Mooresville Office (704) 660-3625 PERMIT # 206494

IMPROVEMENT PERMIT / AUTHORIZATION TO CONSTRUCT / OPERATION PERMIT / EXISTING SYSTEM

PIN # 4636112329

APPLICANT: Designers Choice, Thomas Biggs APPLICANT ADDRESS: PO Box 12533 Charlotte NC 28220-2533

SITE ADDRESS: 167 Wynward Lane Mooresville NC 28210 PHONE: (704) 540-2228 ALT. PHONE:

SITE DIRECTIONS: Go Brawley Sch Rd TL on side of Pines Rd TR on 2nd Cove Creek Rd TL on Wynswept TR on Wynward lot at end

SUBDIVISION: North Shore SECTION: 2 LOT # 44 LOT AREA: .62 DESIGN FLOW: 480 L.T.A.R.: .35

Septic Tank existing 1000 (gal) STB Date
Pump Tank (gal) PT Date
Pump Make Model Serial #
Nitrification Fields 1 # Lines 4 existing Linear Ft: 493
Trench Width Max. Trench Bottom Depth Gravel Depth


☐ New System ☐ Repair ☐ Expansion System Type: I (II) III IV V VI
System Description: 25% reduction chamber
Repair System Description:
Maintenance Agreement Required: ☐ YES ☑ NO
☑ GRAVITY ☐ PRESSURE

☑ Residence No. Bedrooms 4
☐ Business No. Persons
☐ Other No. Employees
☐ Slab ☑ Crawl Space
☐ Basement w/plumbing ☐ Basement w/o plumbing


Water Supply: ☐ Private ☐ Public ☑ Community

Comments / Conditions: Carport was already built when field visit was made on

INITIAL SITE SKETCH

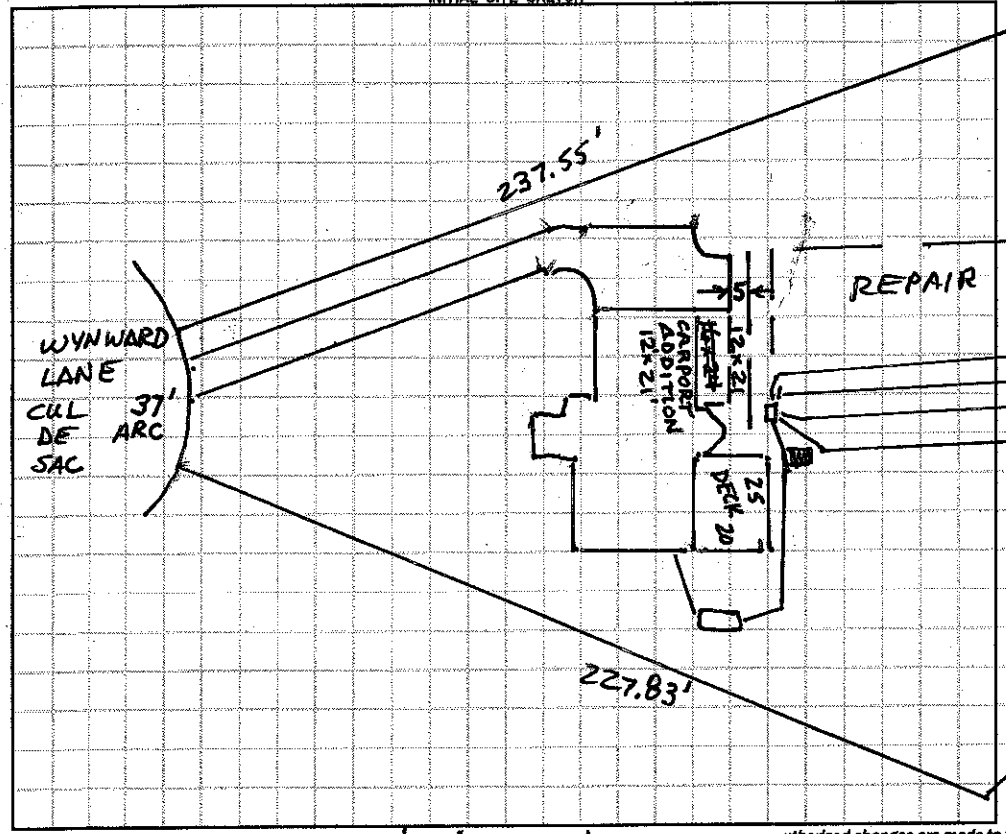

AS BUILT SKETCH

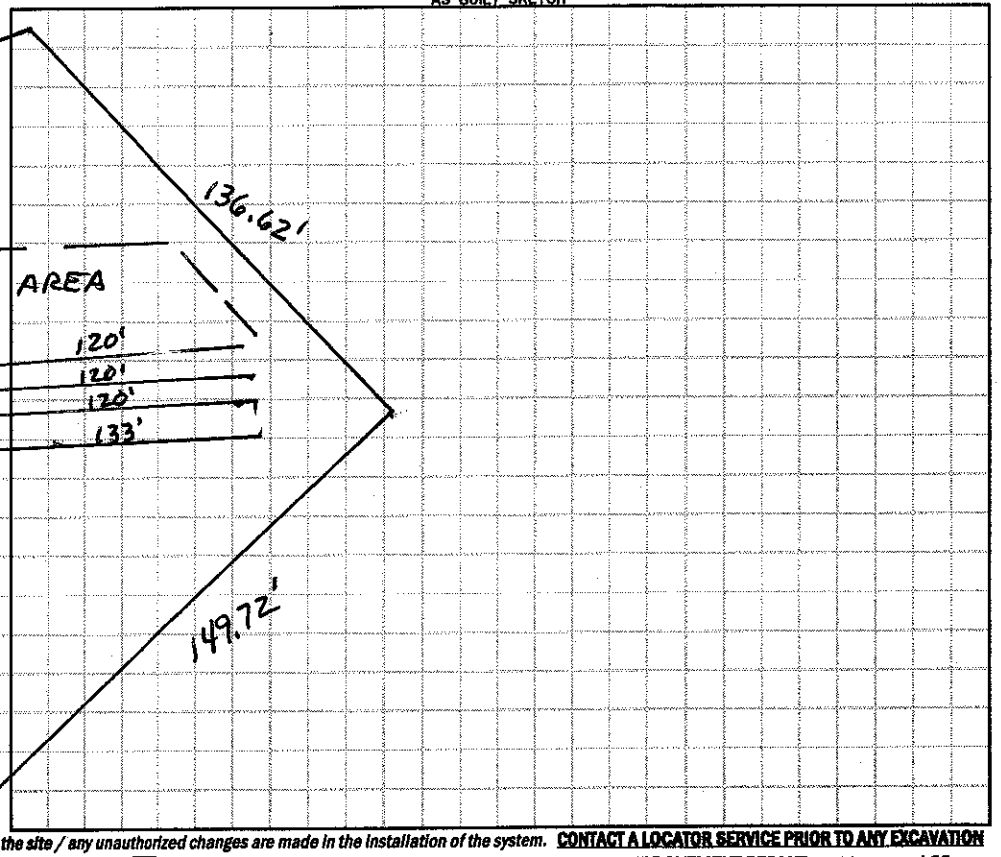

Pr [Location of the proposed 12'x21' carport addition does not appear to impact the existing on-site septic
O system or well.**NOTE:
In Richard Farris REHS Date: 11/26/14
ICHD-Environmental Health Division
Al #206494

uthorized changes are made to the site / any unauthorized changes are made in the installation of the system. **CONTACT A LOCATOR SERVICE PRIOR TO ANY EXCAVATION**

***MIT with site plan** valid for 60 mos.* ☐ **AUTHORIZATION TO CONSTRUCT** *valid for period equal to IMPROVEMENT PERMIT--not to exceed 60 mo.*

Date: Installed by:

Date: OPERATION PERMIT by: Date:

Date: Existing System Inspected by: Date:

Health Dept. Copy - WHITE Applicant (Final Approval) - YELLOW Applicant (Conditional Approval) - PINK