Site Address: 225 Cove Creek Loop, Mrsvl.

IREDELL COUNTY HEALTH DEPARTMENT

STATESVILLE 704-878-5305 MOORESVILLE 704-664-5281

IMPROVEMENT PERMIT / AUTHORIZATION TO CONSTRUCT / OPERATION PERMIT / EXISTING SYSTEM INSPECTION

PERMIT# 138057 21249 PIN# ~~4636 12 0237.052~~ 4636-11-2707 DATE March 26, 07

OWNER OR APPLICANT Chesapeake Pointe LLC PHONE: Business _____ Home _____

ADDRESS 7380 McGinnis Ferry Rd., Suwanee, GA. 30024

LOCATION Brawley Sch Rd. TR side of Pines TR Cove Creek on Right near/at end

SUBDIVISION Chesapeake Pointe BLOCK / SECTION 3 LOT 52/52A LOT AREA 1.2Ac+, 397m SFE SITE CLASS. PS SFE DESIGN FLOW 460gpd L.T.A.R. .3 SFE 52A

Septic Tank: 1000 Gallons; STB 794 Date 9-30-15

Pump Tank: 1000 Gallons; PT 27 Date 11-11-15

Pump Make: Liberty Model _____ Serial No. _____

Nitrification Field: No Fields 1 Square Feet 1206 Linear Feet 402

No Lines 3@134' Trench Width 36" Max Trench Bottom Depth 36" Gravel Depth N/A

☒ New System ☐ Repair ☐ Expansion System Type: I II (III-B) IV V VI

System Description: pm 25% Reduction

Repair System Description: SAME

Maintenance Agreement Required: ☐ Yes ☒ No

☒ House/Mod. Home ☐ Mobile Home ☐ Business ☐ Other

No. Bedrooms 4 No. Persons ___ No. Employees ___

Water Supply: ☐ Individual ☒ Public ☒ Community

☐ Gravity ☒ Pressure ☐ Slab ☐ Crawl Space ☒ Basement w/plumbing ☐ Basement wo/plumbing

Comments:/Conditions:

Show off any old burns in septic field easement 52A (drainfield area)

Comments:/Conditions: CHECKED DRAIN FIELD 12-16-15 BA

CHECKED TANKS 12-21-15 BA

INITIAL SITE SKETCH

SEE PLAN from SAME

☒ Off-site pump system w/ drainfield across street.

AS BUILT SKETCH

3-24-16

Alarm OK

Floats 12" differential w/ ± 6-7' of leads

2" of Pressure Head set @ Pressure manifold box - SF

3/4 HP Liberty Effluent Pump


Permit can be suspended or revoked if any false information is supplied toward securing the permit/any unauthorized changes are made to the site/any unauthorized changes are made in the installation of the system. Improvement Permit with plat valid without expiration ☐ Improvement Permit with site plan valid for sixty months ☒ Authorization to Construct is valid for a period equal to that of Improvement Permit – not to exceed sixty months.

Signed: Karen D. Wallace date 7-27-07 Installed by: ABERNATHY

Improvement Permit by: _____ date 3-26-07 Operation Permit by: Thomas Shuck date 3-24-2016

Authorization to Construct by: _____ APPROVED JUL 30 2015 Existing System Inspection by: _____ date _____

HEALTH DEPT. COPY: WHITE OWNER COPY (FINAL): YELLOW OWNER COPY (INITIAL): PINK

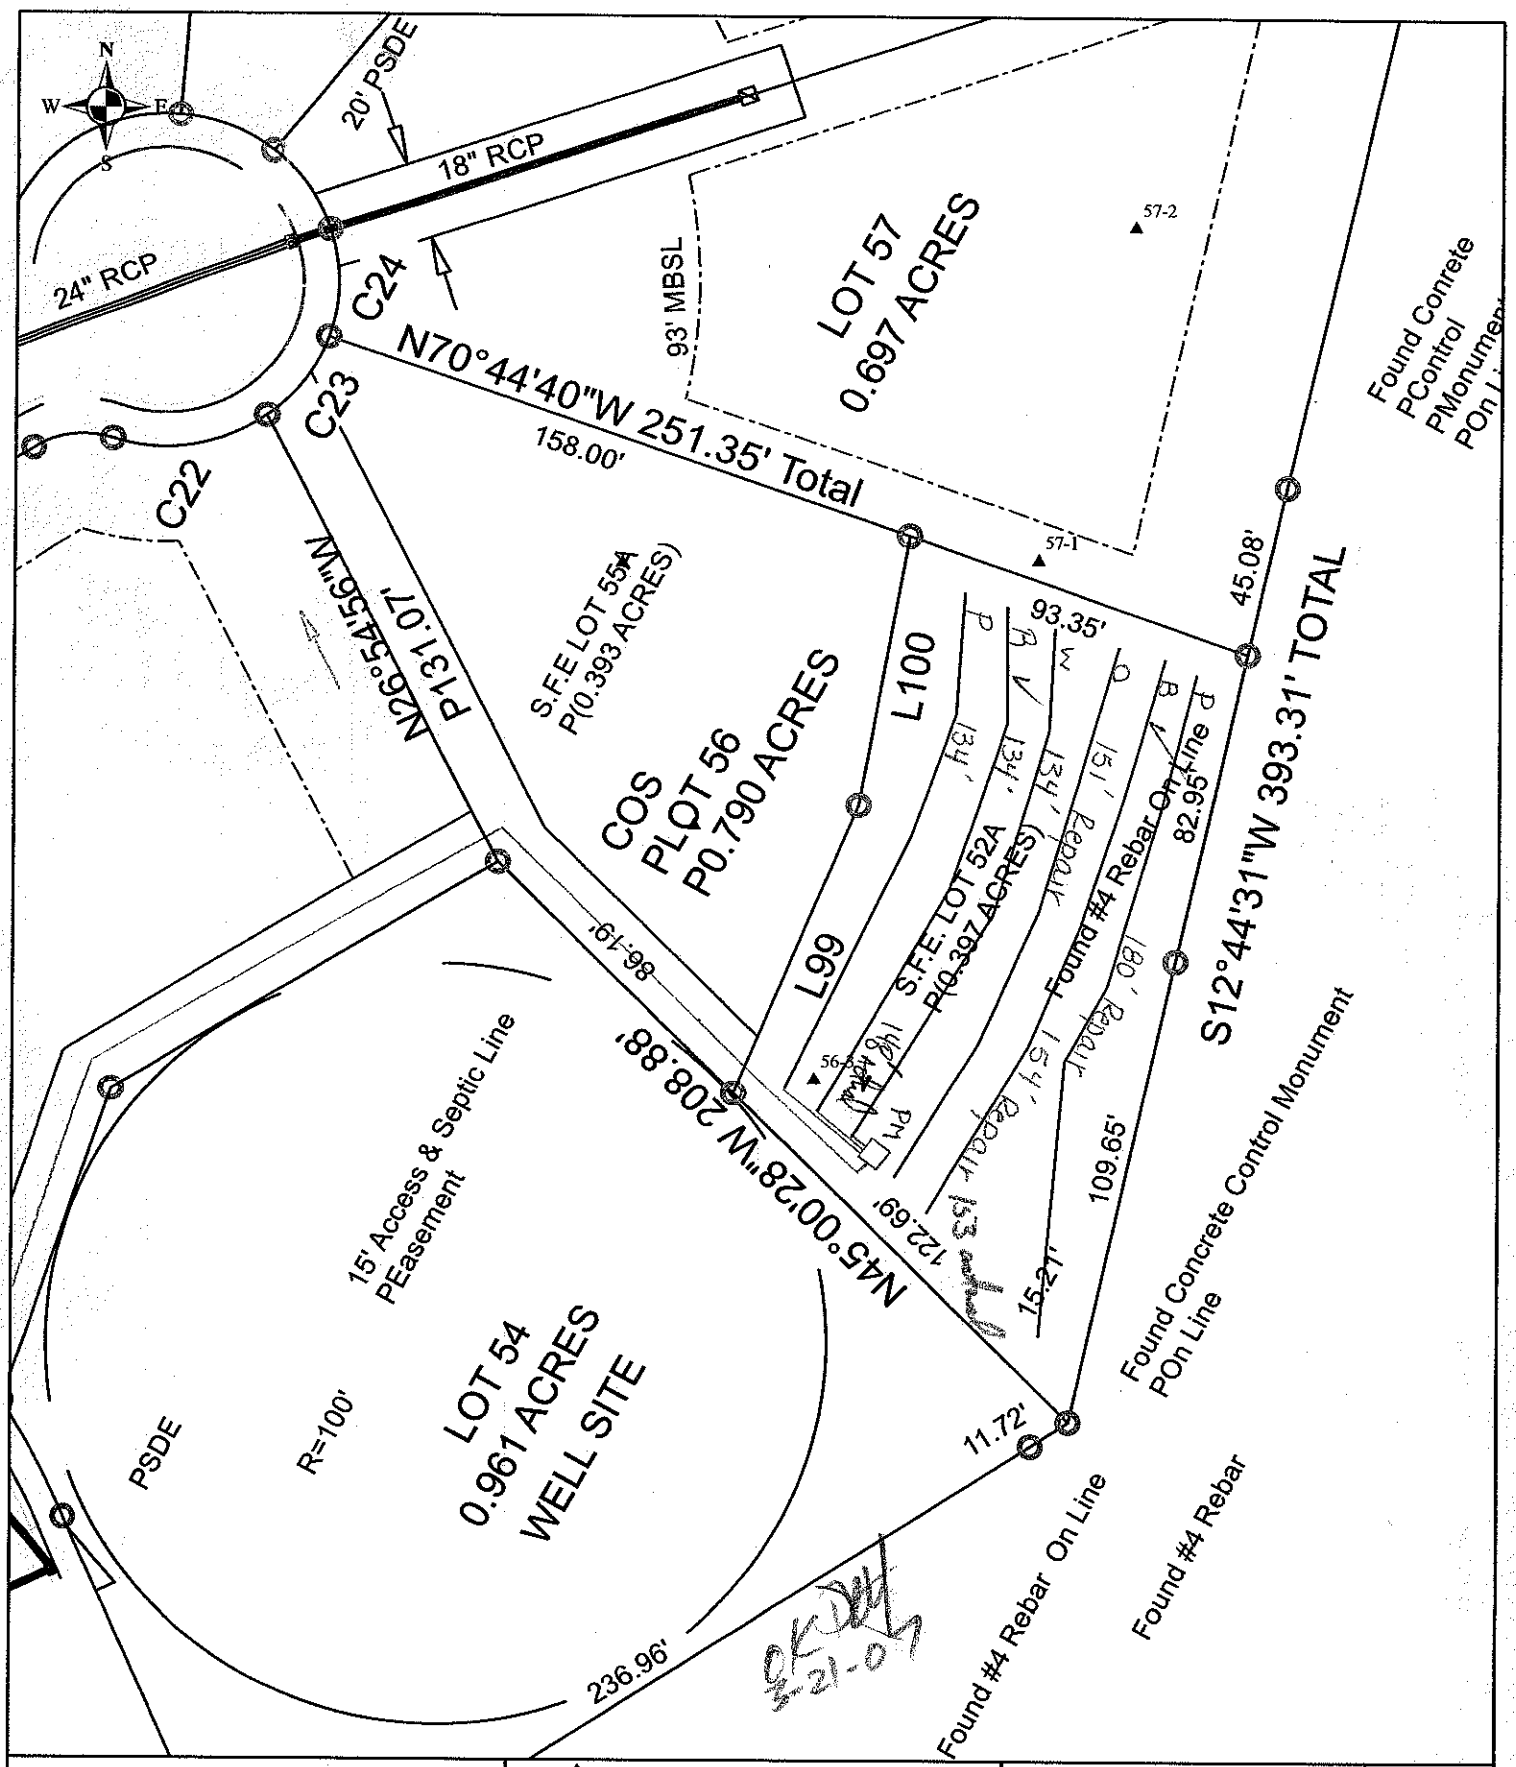

Scale: 1 inch equals 50 feet	S&ME	S.F.E. Lot 52A Chesapeke Point	FIGURE
Drawn by: JBP		Detailed, Scaled Site Plan	1
Reviewed by: KS		Iredell County, NC	
Date: December, 2006	ENVIRONMENTAL SERVICES • ENGINEERING • TESTING	S&ME Project #1588-04-011	