IREDELL COUNTY HEALTH DEPARTMENT

STATESVILLE 704-878-5305 MOORESVILLE 704-664-5281

IMPROVEMENT PERMIT / CERTIFICATE OF COMPLETION / OPERATION PERMIT / EXISTING SYSTEM INSPECTION

PROPERTY DESCRIPTION NO. 21106 DATE May 22, '95 TAX MAP NO. 2623B54 4636 11 4064 Watershed: ☑ Yes ☐ No WSIV

OWNER OR CONTRACTOR Robert Ingraham Homes PHONE: Business _____ Home _____

ADDRESS 2900 B I85 Service Rd Charlotte

LOCATION Brawley Sch Rd TL 1113 TR Cove Creek TL Wynswept 2nd on Right

SUBDIVISION North Shore BLOCK / SECTION 2, pls 1 LOT 54 LOT AREA 1.6 Ac SITE CLASS. PS on 956 DESIGN FLOW 480 gpd L.T.A.R. e3

Septic Tank: 1000 Gallons; STB 794 Bedinger Date 5-21-95

Pump Tank: 1600 Gallons; PT 27 Bedinger Date 5-14-95

Pump Make: _____ Model _____ Serial No. _____

Nitrification Field: No Fields 1 Square Feet 1200 Linear Feet 400

No Lines 4 Trench Width 36" Max Trench Bottom Depth 36" Gravel Depth NA

☑ New System ☐ Repair System Type: I, II, ☑ III, IV, V, VI

System Description: pumped Infiltrator

Repair System Description: same

Maintenance Agreement Required: ☐ Yes ☑ No

☑ House/Mod. Home No. Bedrooms 4

☐ Mobile Home No. Bathrooms 2.5

☐ Business No. Employees _____

☐ Other _____

☐ Slab ☑ Crawl Space ☐ Basement w/plumbing ☐ Basement wo/plumbing


Water Supply: ☐ Individual ☑ Community ☐ Public

Comments: 4 Inf 3ch 80 pressure manifold - See me for details DKH


Comments:

1" = 40

INITIAL SITE SKETCH

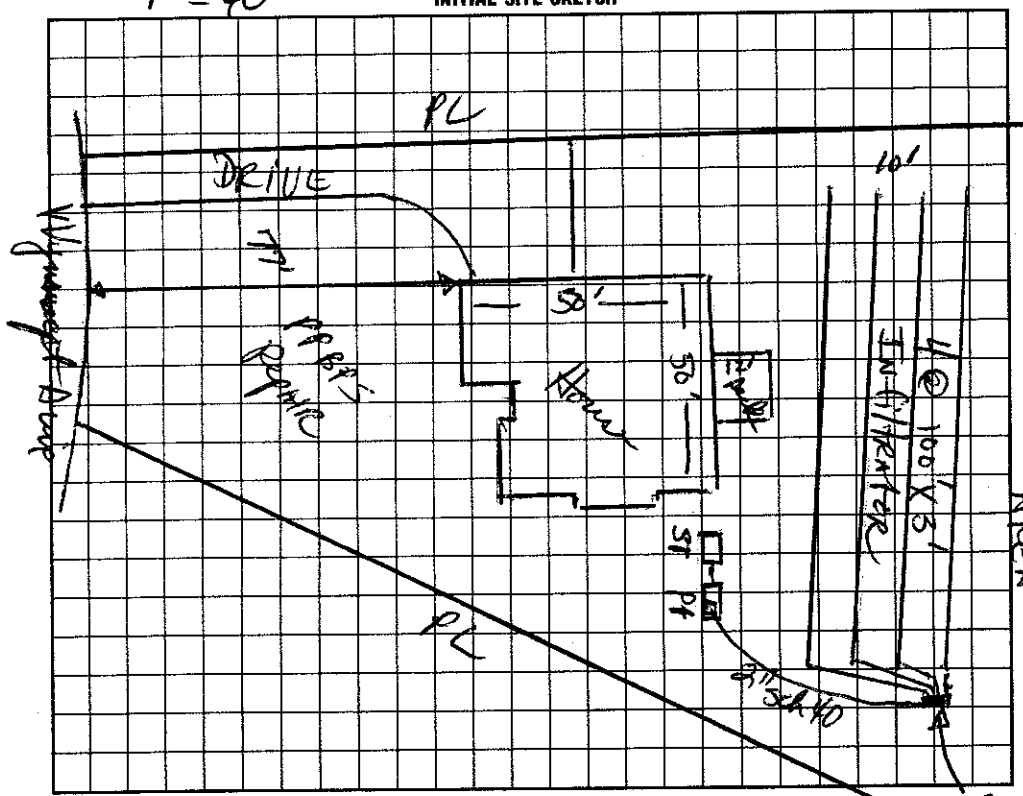

AS BUILT SKETCH

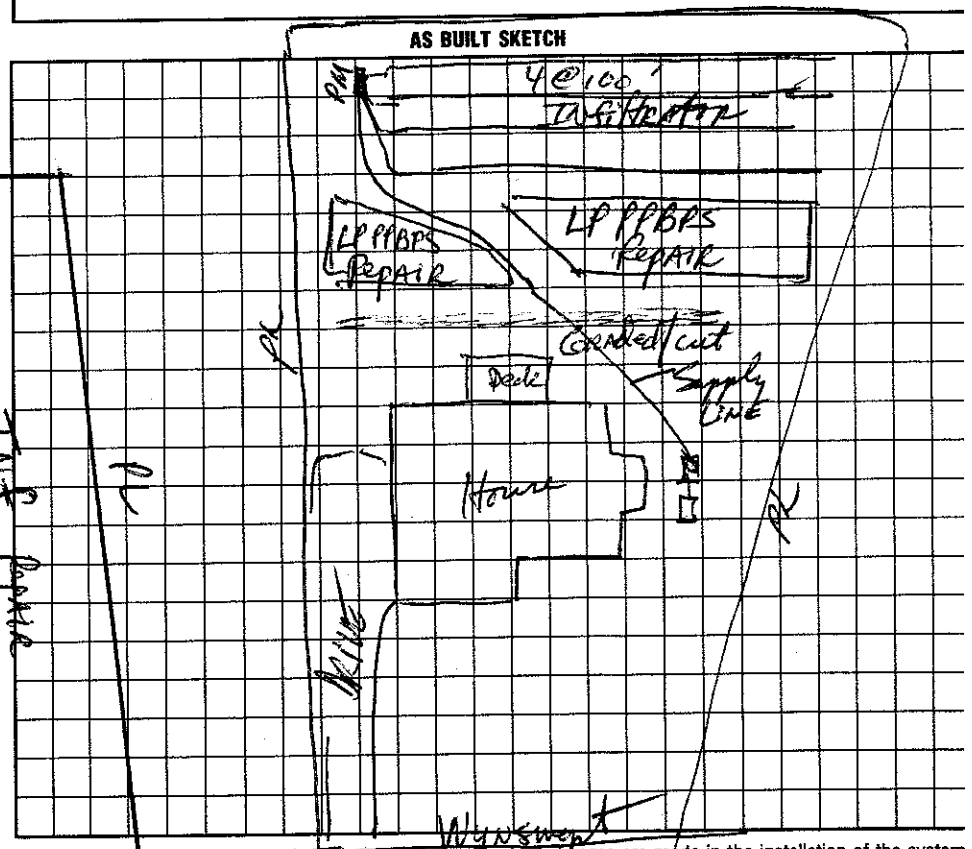

I understand that this permit can be suspended or revoked if any false information is supplied toward securing the permit/any unauthorized changes are made to the site/any unauthorized changes are made in the installation of the system Improvement Permit is valid for 60 months from date of issuance.

Signed: _____ Installed by: Ironhorse - Ken Painter

Improvement Permit by: Parker K Howard, RS date 5-22-95

Existing System Inspection by: _____ date _____

Certificate of Completion by: _____ date _____

Operation Permit by: P K Howard RS date 10-3-95

HEALTH DEPT. COPY: WHITE INSPECTION COPY (FINAL): GREEN OWNER COPY (FINAL): YELLOW INSPECTION COPY (INITIAL): PINK OWNER COPY (INITIAL): GOLD