IREDELL COUNTY HEALTH DEPARTMENT

STATESVILLE 704-878-5305 MOORESVILLE 704-664-528?

IMPROVEMENT PERMIT / AUTHORIZATION TO CONSTRUCT / OPERATION PERMIT / EXISTING SYSTEM INSPECTION

PERMIT# 25324 PIN# 26 23 358 4636-11-4396

OWNER OR CONTRACTOR Dickinson Custom Builders (JEFF KIEFFER) PHONE: Business ________ DATE 4/22/99

ADDRESS PO Box 2428 Cornelius NC. 28031 Home 892-6090

LOCATION Cove Creek Rd - Brawley Sch Rd - Isle of Pines - TR Cove Creek, 4th on (L) past Wynswept

SUBDIVISION NORTH SHORE BLOCK / SECTION 3 LOT 58 LOT AREA .53 AC SITE CLASS. PS DESIGN FLOW 480 L.T.A.R. .3

Septic Tank: 1000 Gallons; STB 312 Date 8/23/99

Pump Tank: ________ Gallons; PT ________ Date ________

Pump Make: ________ Model 900 Serial No. 300

Nitrification Field: No Fields 1 Square Feet ~~1200~~ * Linear Feet ~~400~~ *

No Lines 4 Trench Width 36" Max Trench Bottom Depth 36" Gravel Depth SAND

☒ New System ☐ Repair System Type: I, II, (III), IV, V, VI

System Description: GRAV - TYPE 3 (MODIFIED)

Repair System Description: FRONT YARD - PRESSURE PANEL

Maintenance Agreement Required: ☐ Yes ☐ No

☒ House/Mod. Home ☐ Mobile Home ☐ Business ☐ Other ________

No. Bedrooms 3 No. Bathrooms 3 No. Employees ________


☐ Slab ☒ Crawl Space ☐ Basement w/plumbing ☐ Basement wo/plumbing

Water Supply: ☐ Individual ☐ Public ☒ Community


Comments:/Conditions: * 25% reduction calculated install amount shown on this Permit
10/18/99 Plans reviewed - house is 3 BDRM. may use 3 lines at 100' x 3' CH. PLASTIC OR H.D.I. - AWS

Comments:/Conditions:

INITIAL SITE SKETCH

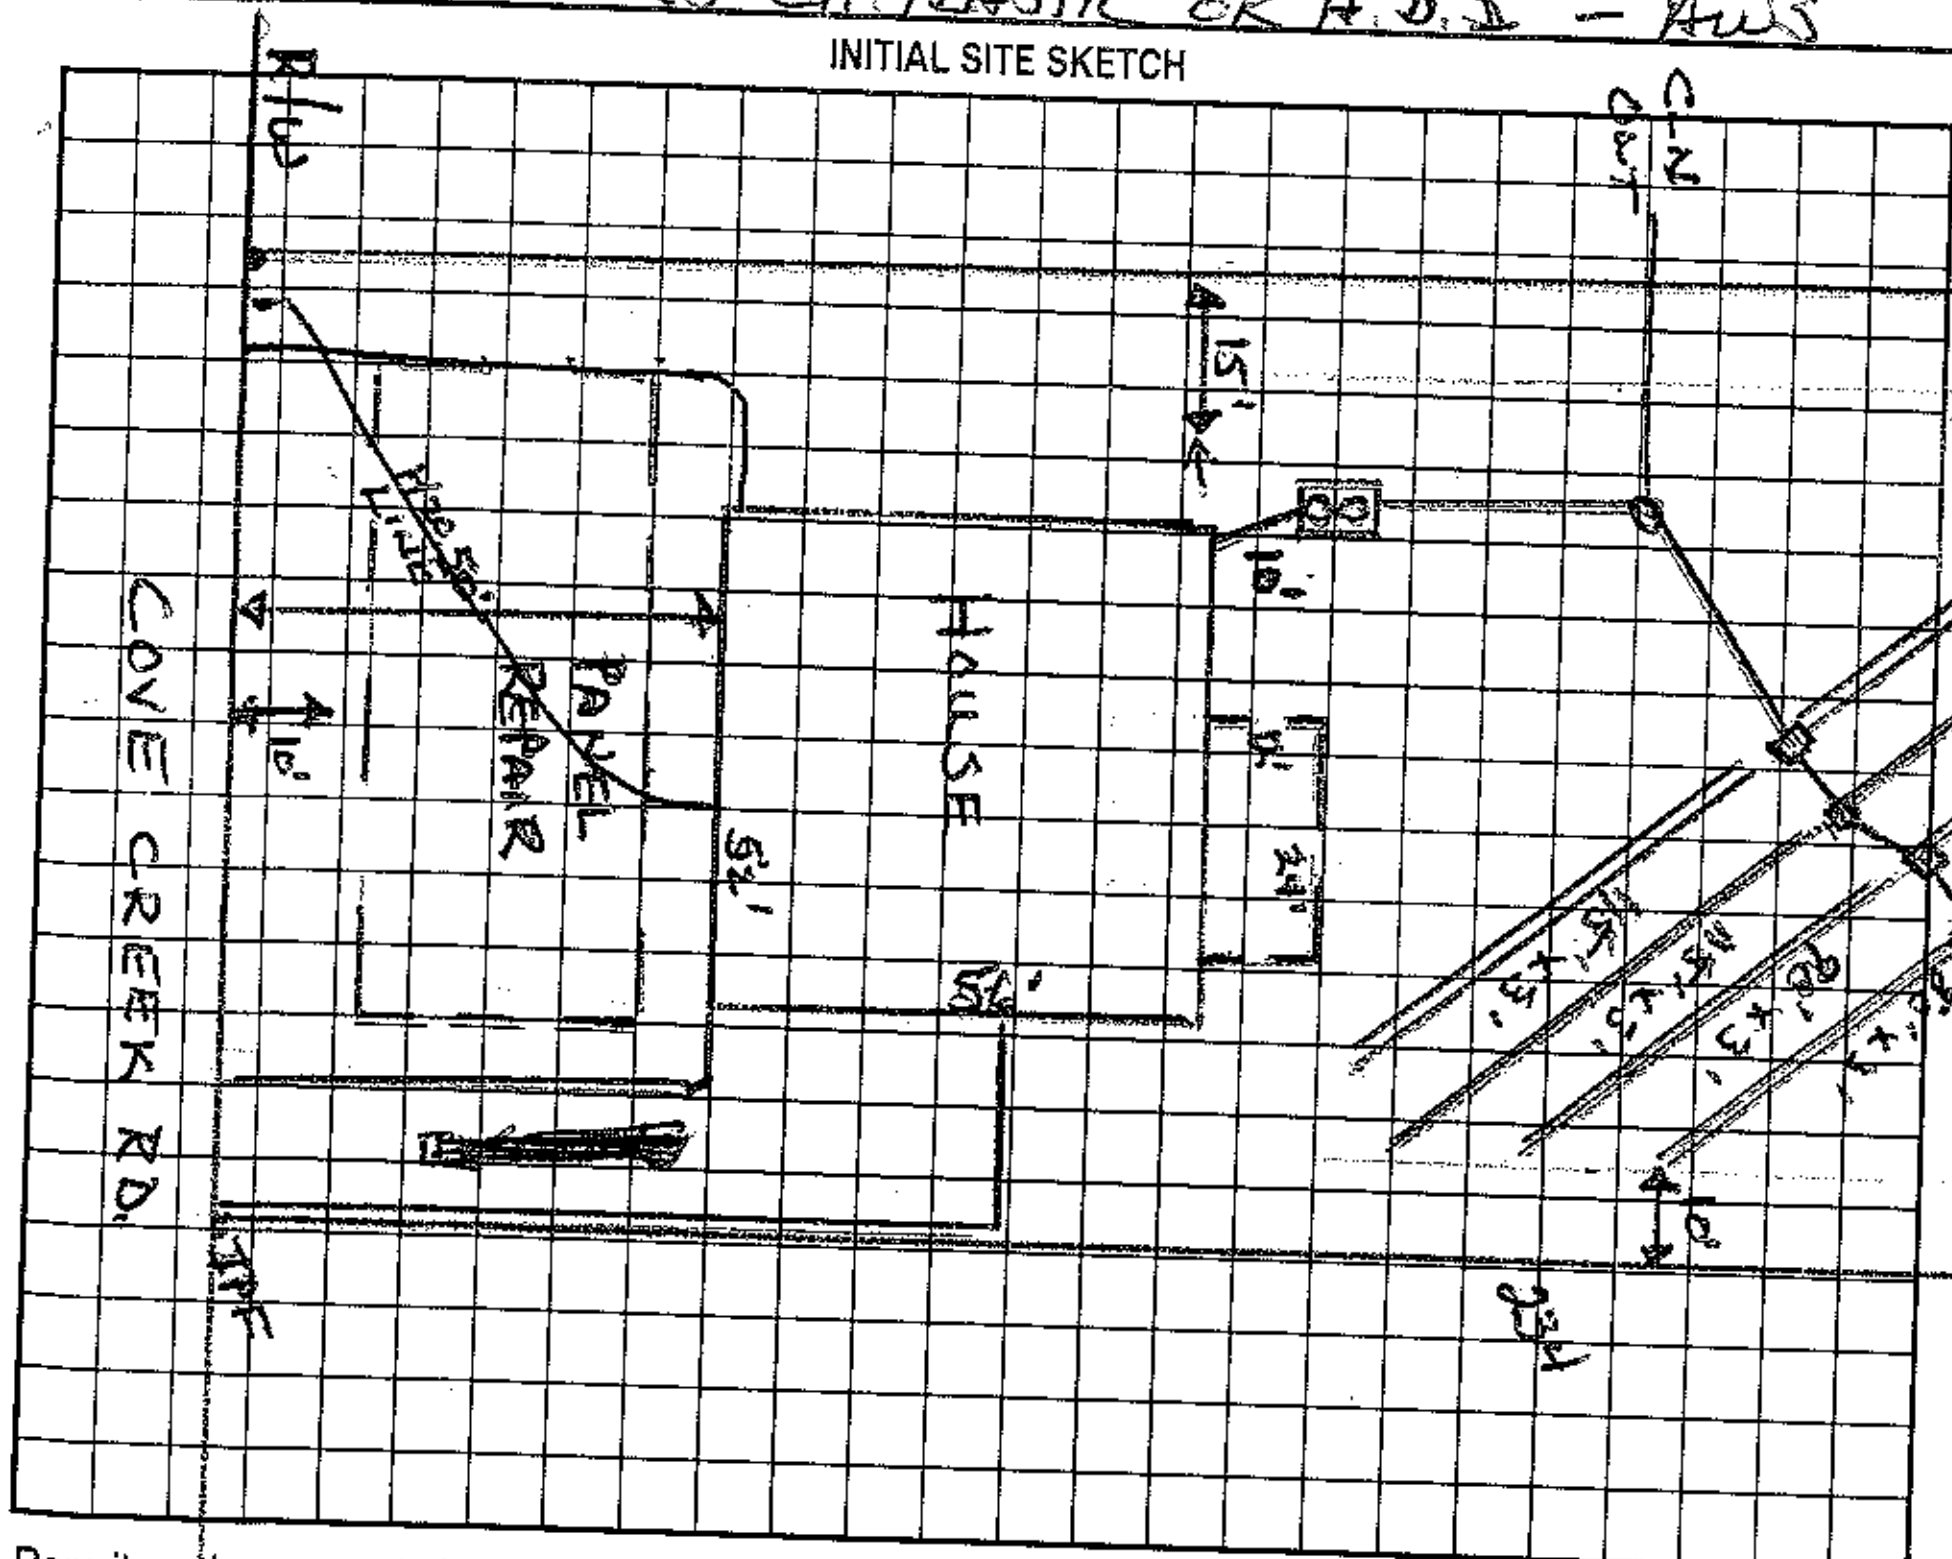

AS BUILT SKETCH

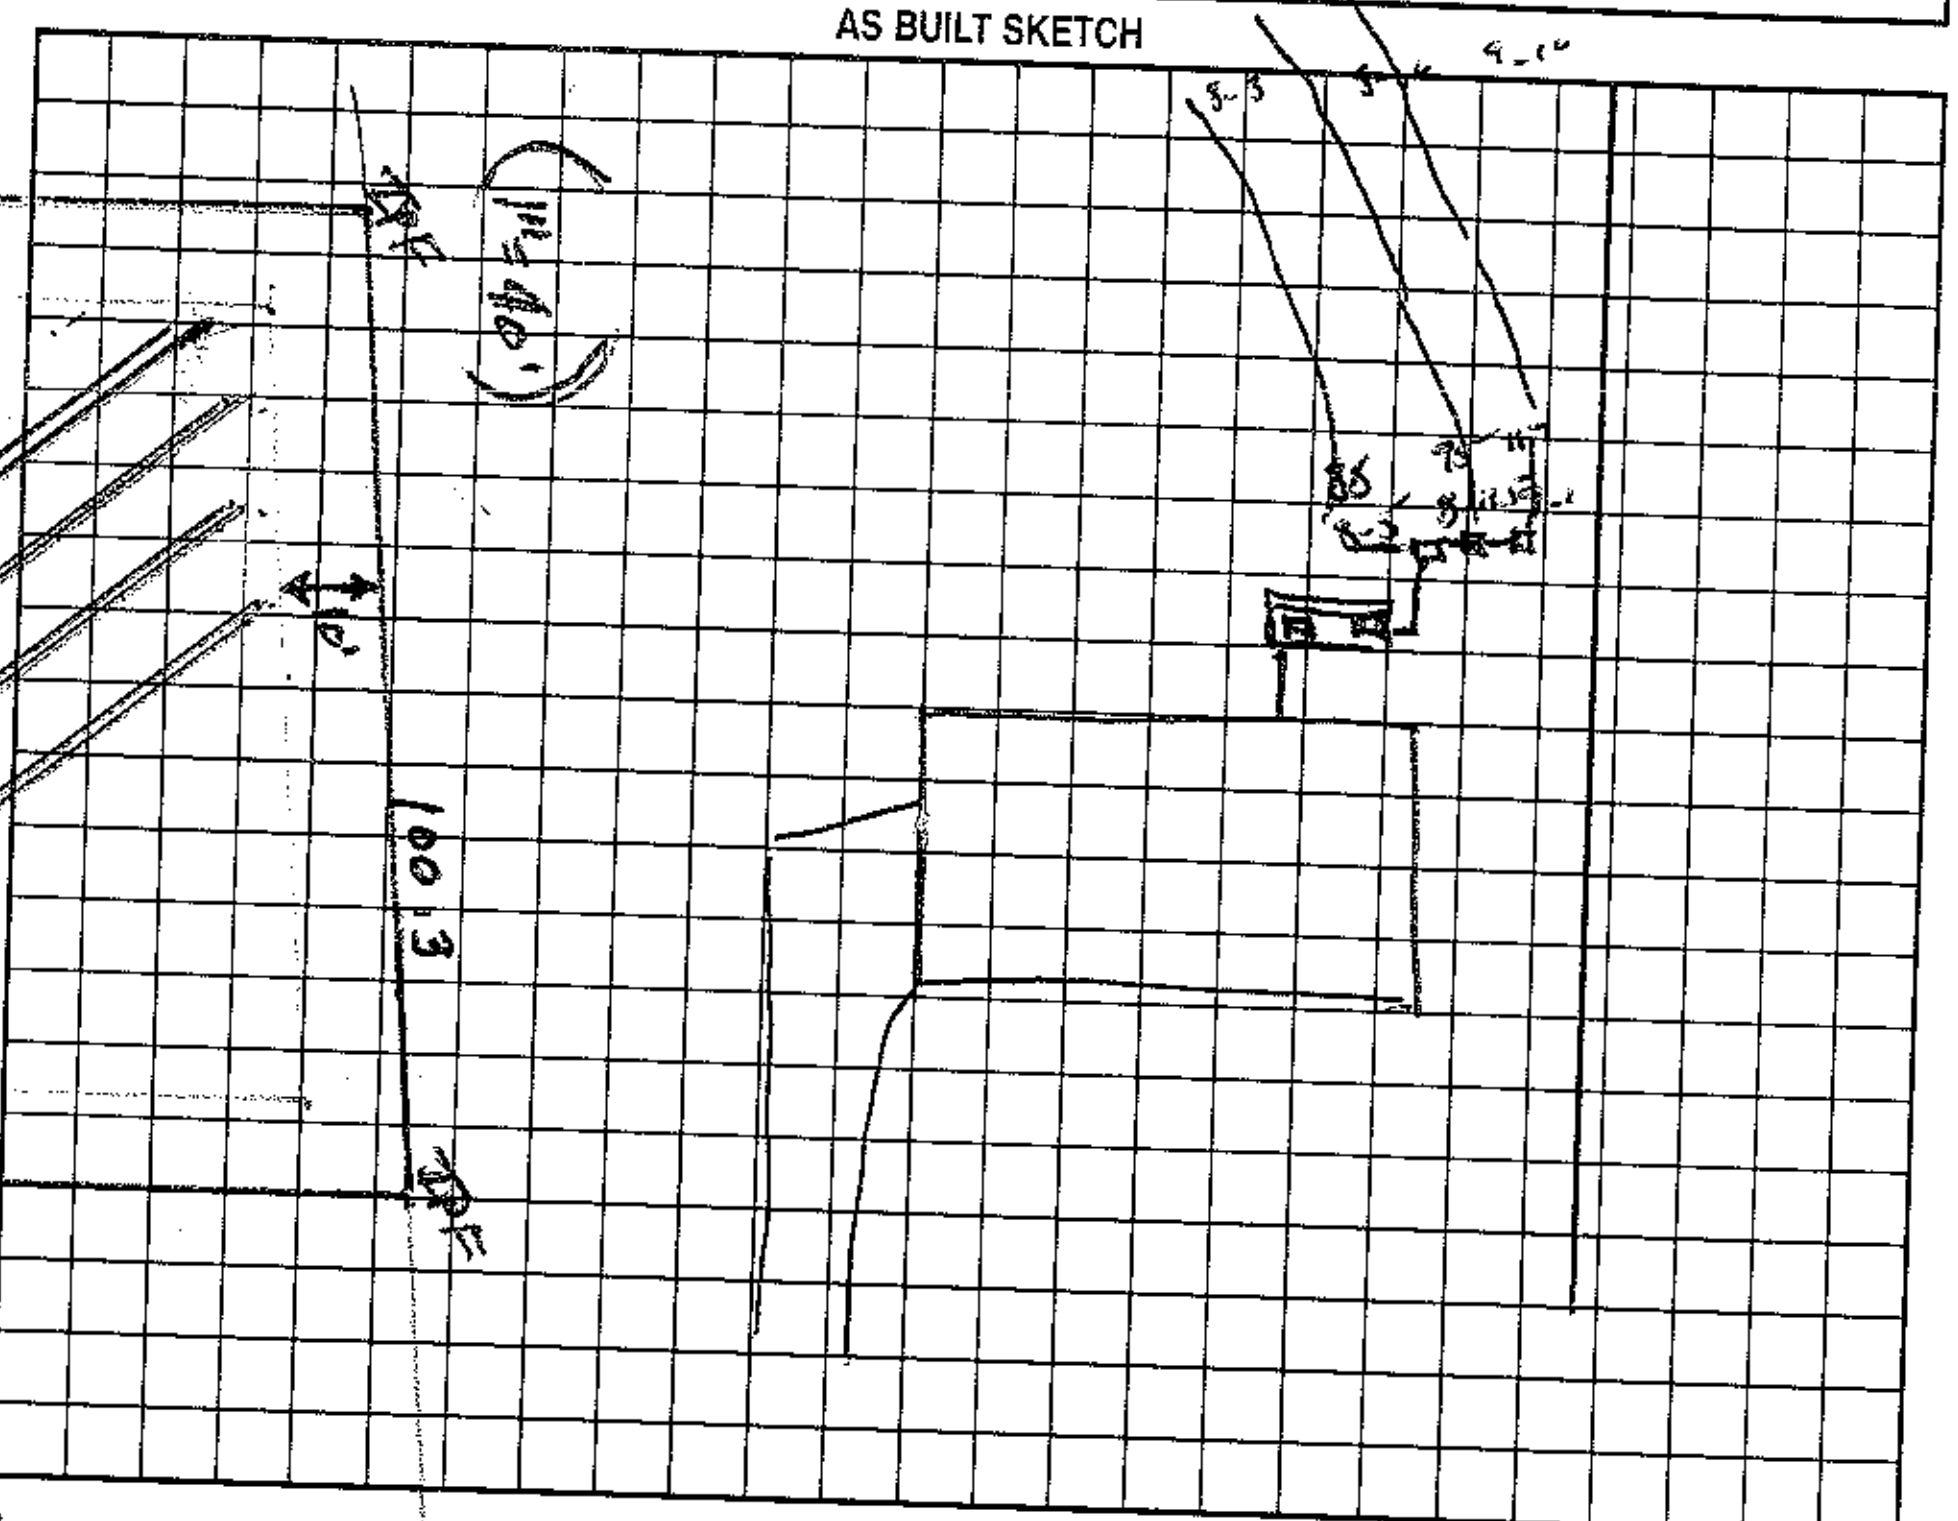

Permit can be suspended or revoked if any false information is supplied toward securing the permit/any unauthorized changes are made to the site/any unauthorized changes are made in the installation of the system. Improvement Permit with plat valid without expiration. Improvement Permit with site plan valid for sixty months. Authorization to Construct is valid for a period equal to that of Improvement Permit – not to exceed sixty months.

Signed: * Rolanda R. Dickinson date 5.12.99

Improvement Permit by: Wesley Sparks R.S. date 4/22/99

Authorization to Construct by: Wesley Sparks R.S. date 4/22/99

Installed by: Ready Eudy

Operation Permit by: Wesley Sparks R.S. date 11/8/99

Existing System Inspection by: ________ date ________

HEALTH DEPT. COPY: WHITE OWNER COPY (FINAL): YELLOW OWNER COPY (INITIAL): PINK