IREDELL COUNTY HEALTH DEPARTMENT

to Construct 4636 114445

SVILLE 704-878-5305 MOORESVILLE 704-664-5281

IMPROVEMENT PERMIT / ~~CERTIFICATE OF C~~ ...TION / OPERATION PERMIT / EXISTING SYSTEM INSPECTION

PROPERTY DESCRIPTION NO. 22825 DATE 11-1/96 TAX MAP NO. 2G 23 B 59 Watershed: [X] Yes [ ] No

OWNER OR CONTRACTOR Robert Ingram Homes PHONE: Business 391-3715 Home

ADDRESS 2900 I 85 South Rd. Chas. NC. 28208

LOCATION Isle of Pines Rd. TR Cove Creek 6th lot on [E] past Wynscott Ln.

SUBDIVISION North Shore BLOCK / SECTION II LOT 59 LOT AREA .58 SITE CLASS. PS DESIGN FLOW 480 L.T.A.R. .35

Septic Tank: 1000 Gallons; STB 794 Date 2/16/96

Pump Tank: Gallons; PT Date

Pump Make: Model Serial No.

Nitrification Field: No Fields 1 Square Feet 1391 Linear Feet 342*

No Lines 3 Trench Width 36" Max Trench Bottom Depth 36" Gravel Depth 6" Sand

[X] New System [ ] Repair System Type: I, II, III, IV, V, VI

System Description: Gravity elimination

Repair System Description: Same

Maintenance Agreement Required: [ ] Yes [X] No

[X] House/Mod. Home No. Bedrooms 4

[ ] Mobile Home No. Bathrooms 3

[ ] Business No. Employees

[ ] Other


[ ] Slab [X] Crawl Space [ ] Basement w/plumbing [ ] Basement wo/plumbing

Water Supply: [ ] Individual [X] Community [ ] Public


Comments: 25% reduction for elimination use

Comments:

INITIAL SITE SKETCH

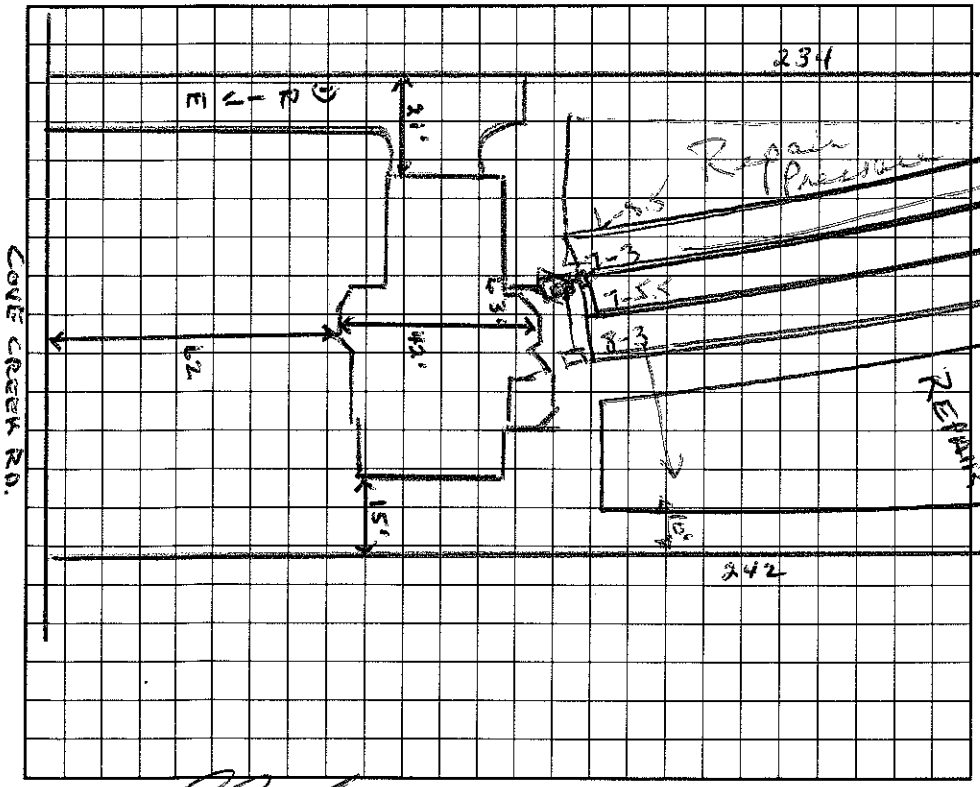

AS BUILT SKETCH

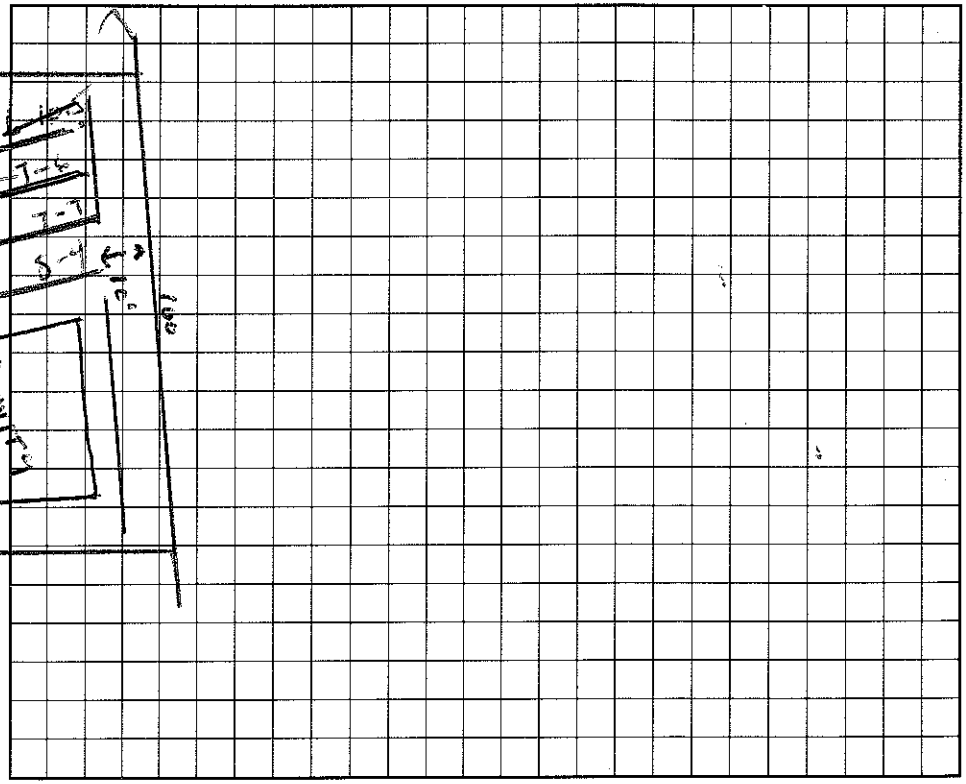

I understand that this permit can be suspended or revoked if any false information is supplied toward securing the permit/any unauthorized changes are made to the site/any unauthorized changes are made in the installation of the system.

Signed:

Improvement Permit by: Wesley Sparks R.S. date 1/3/96

~~Existing System Inspection by:~~ Wesley Sparks R.S. date 1/3/96

Installed by: Olan Homes Grading

Certificate of Completion by: date

Operation Permit by: Wesley Sparks R.S. date 4/11/96

HEALTH DEPT. COPY: WHITE INSPECTION COPY (FINAL): GREEN OWNER COPY (FINAL): YELLOW INSPECTION COPY (INITIAL): PINK OWNER COPY (INITIAL): GOLD