IREDELL COUNTY HEALTH DEPARTMENT

Authorization to Construct (2:30) R65

STATESVILLE 704-878-5305 MOORESVILLE 704-664-5281

IMPROVEMENT PERMIT / ~~CERTIFICATE OF COMPLETION~~ / OPERATION PERMIT / EXISTING SYSTEM INSPECTION

PROPERTY DESCRIPTION NO. Repair DATE 4/28/97 TAX MAP NO. 2623 B 60 Watershed: ☒ Yes ☐ No

OWNER OR CONTRACTOR Robert Ingram Homes PHONE: Business 391-3715 ~~Home~~ 4636-11-4504

ADDRESS 2900 B I 85 Service Rd. Charlotte, NC. 28208

LOCATION Brawley Sch. Rd. to Isle of Pines TR Cove Creek, 6th lot on (L) past Waynescroft Dr.

SUBDIVISION North Shore BLOCK / SECTION II LOT 60 LOT AREA .61 SITE CLASS. PS DESIGN FLOW 480 L.T.A.R. .3

Septic Tank: Existing Gallons; STB ______ Date ______
Pump Tank: ______ Gallons; PT ______ Date ______
Pump Make: ______ Model ______ Serial No. ______
Nitrification Field: No Fields 1 Square Feet 798 Linear Feet 266
No Lines 2 Trench Width 36" Max Trench Bottom Depth 36" Gravel Depth SAND.

☐ New System ☒ Repair System Type: I, II, (III), IV, V, VI
System Description: CH PLASTIC
Repair System Description: PREFAB.
Maintenance Agreement Required: ☐ Yes ☒ No

☒ House/Mod. Home No. Bedrooms 4
☐ Mobile Home No. Bathrooms 4
☐ Business No. Employees ______
☐ Other ______

☐ Slab ☐ Crawl Space ☒ Basement w/plumbing ☐ Basement wo/plumbing


Water Supply:
☐ Individual
☒ Community
☐ Public

Comments: (1) Subsurface intercept drain needed immediately to cut off drainage from gutters and yard areas. (2) Gutter downspouts from garage side of house need to be piped off also.

Comments:

INITIAL SITE SKETCH

AS BUILT SKETCH

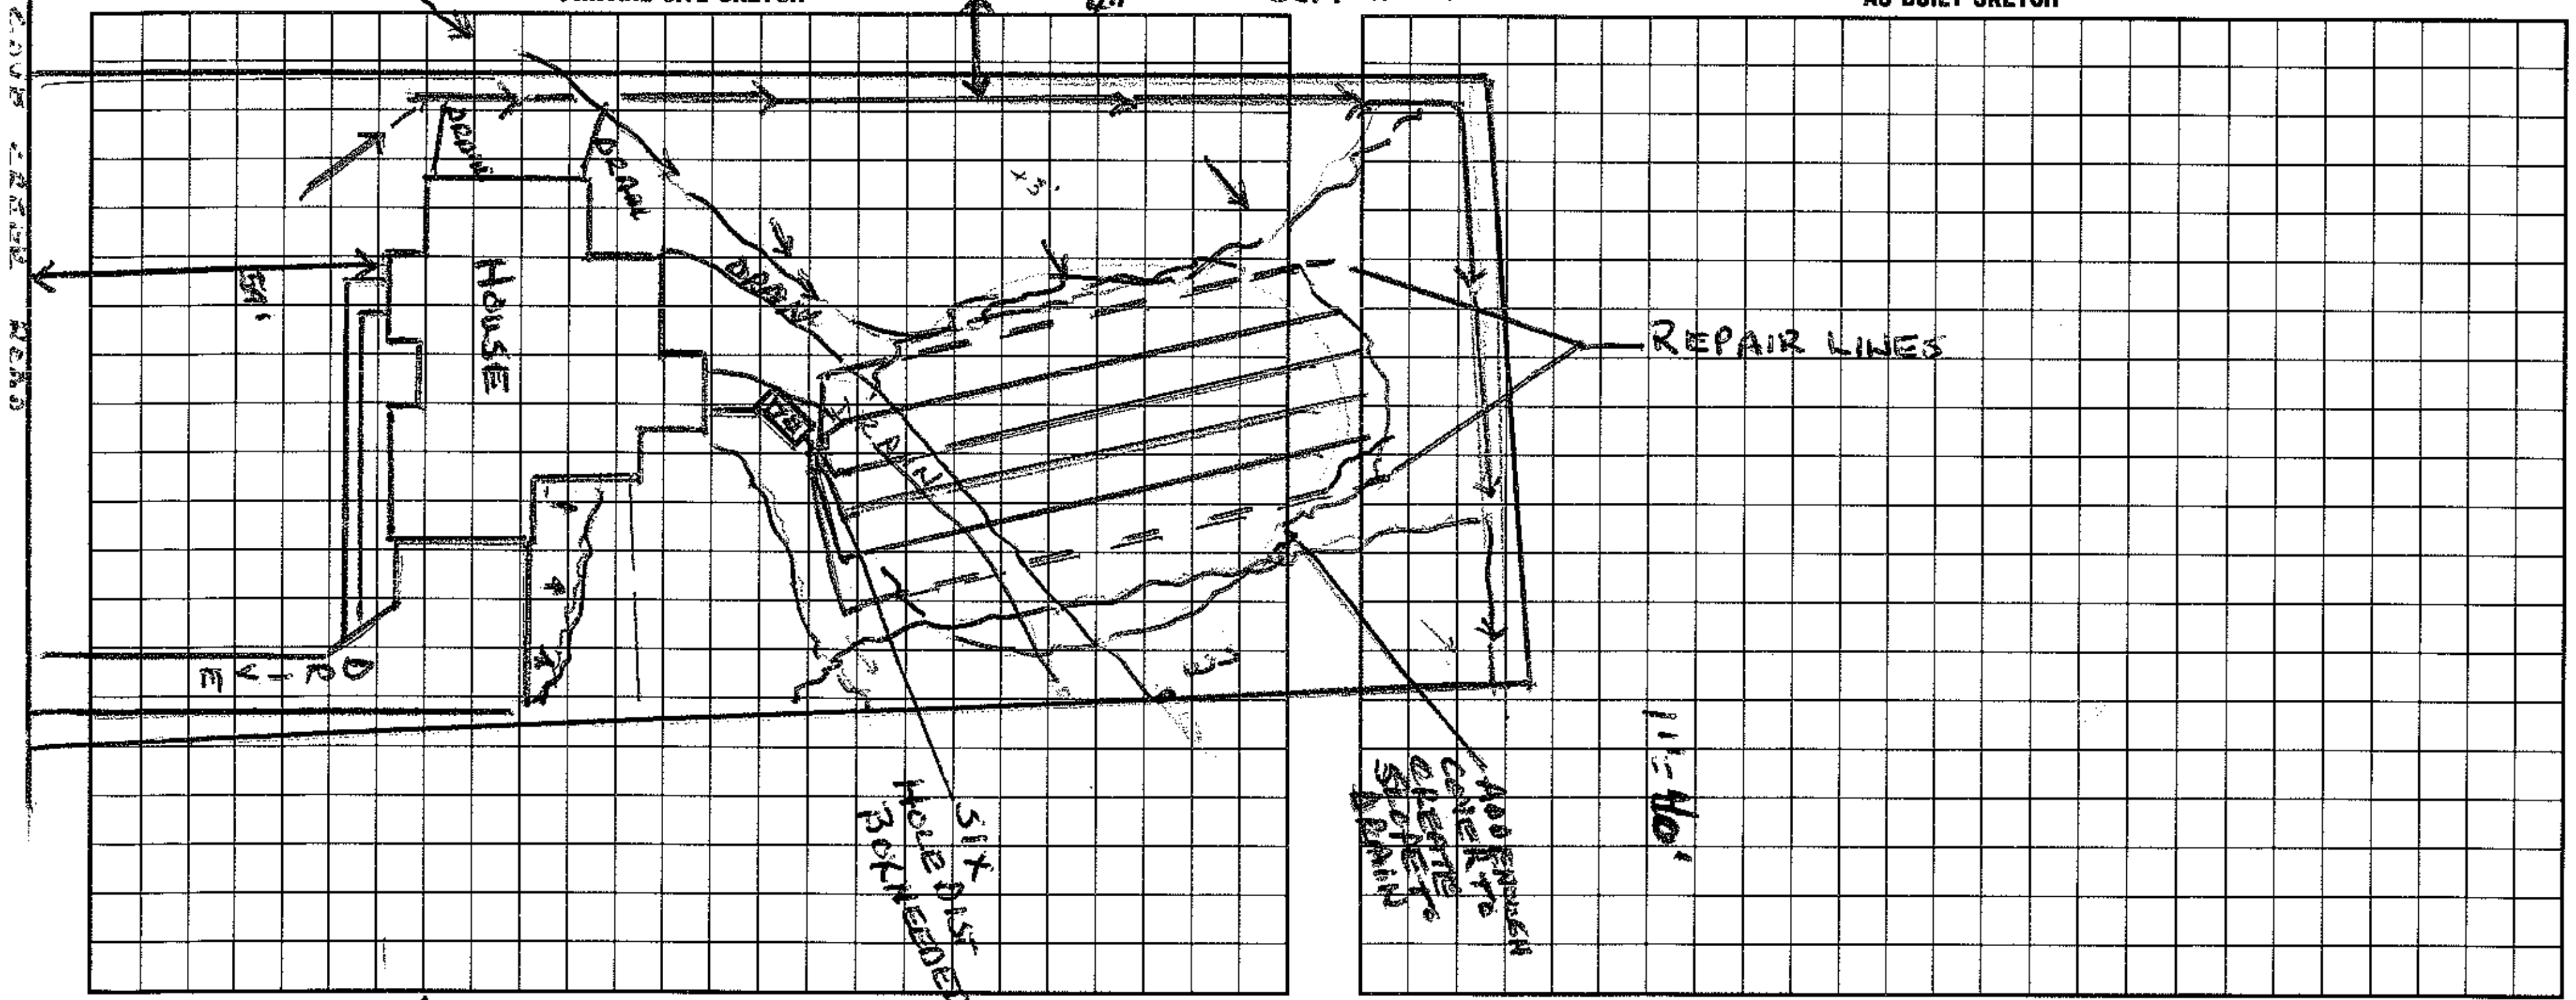

I understand that this permit can be suspended or revoked if any false information is supplied toward securing the permit/any unauthorized changes are made to the site/any unauthorized changes are made in the installation of the system. Improvement Permit is valid for 60 months from date of issuance.

Signed: * [signature] 5/7/97

Improvement Permit by: Wesley Sparks R.S. date 4/23/97

Existing System Inspection by: Authorization to Construct Wesley Sparks R.S. date 4/28/97

Installed by: T W Ammons

Certificate of Completion by: Wesley Sparks R.S. date 5/27/98

Operation Permit by: Wesley Sparks R.S. date 5/27/98

HEALTH DEPT. COPY: WHITE INSPECTION COPY (FINAL): GREEN OWNER COPY (FINAL): YELLOW INSPECTION COPY (INITIAL): PINK OWNER COPY (INITIAL): GOLD

IREDELL COUNTY HEALTH DEPARTMENT

Authorization to Construct

STATESVILLE 704-878-5305 MOORESVILLE 704-664-5281

IMPROVEMENT PERMIT / ~~CERTIFICATE OF COMPLETION~~ / OPERATION PERMIT / EXISTING SYSTEM INSPECTION

PROPERTY DESCRIPTION NO. 22826 DATE 1/11/96 TAX MAP NO. 2G 23 B 60 Watershed: [X] Yes [ ] No

OWNER OR CONTRACTOR R.I. Homes PHONE: Business 391-3715 Home

ADDRESS 2900-B I 85 Service Rd. Charlotte N.C. 28208

LOCATION 1100, TL 1113 TR Cove Creek 6th lot on (E) past Wynsenpt Dr.

SUBDIVISION North Shore BLOCK / SECTION II LOT 60 LOT AREA .61 SITE CLASS. PS DESIGN FLOW 480 L.T.A.R. .3

Septic Tank: 1000 Gallons; STB 794 Date 12/1/95

Pump Tank: _____ Gallons; PT _____ Date _____

Pump Make: _____ Model _____ Serial No. _____

Nitrification Field: No Fields 1 Square Feet 1600 Linear Feet ~~400~~ (533)

No Lines ~~4~~ Trench Width 36" Max Trench Bottom Depth 36" Gravel Depth SAND

[X] New System [ ] Repair System Type: I, II, (III), IV, V, VI

System Description: GRAVITY - INFILTRATOR

Repair System Description: SAME

Maintenance Agreement Required: ~~Yes~~ ~~No~~ S 42.5.

[X] House/Mod. Home No. Bedrooms 4

[ ] Mobile Home No. Bathrooms 4

[ ] Business No. Employees

[ ] Other


[ ] Slab [X] Crawl Space [ ] Basement w/plumbing [ ] Basement wo/plumbing

Water Supply: [ ] Individual [X] Community [ ] Public


Comments: ~~*~~ 25% reduction for gravity infiltrator and required to backfill to top of louvers on each panel.

Comments:

INITIAL SITE SKETCH

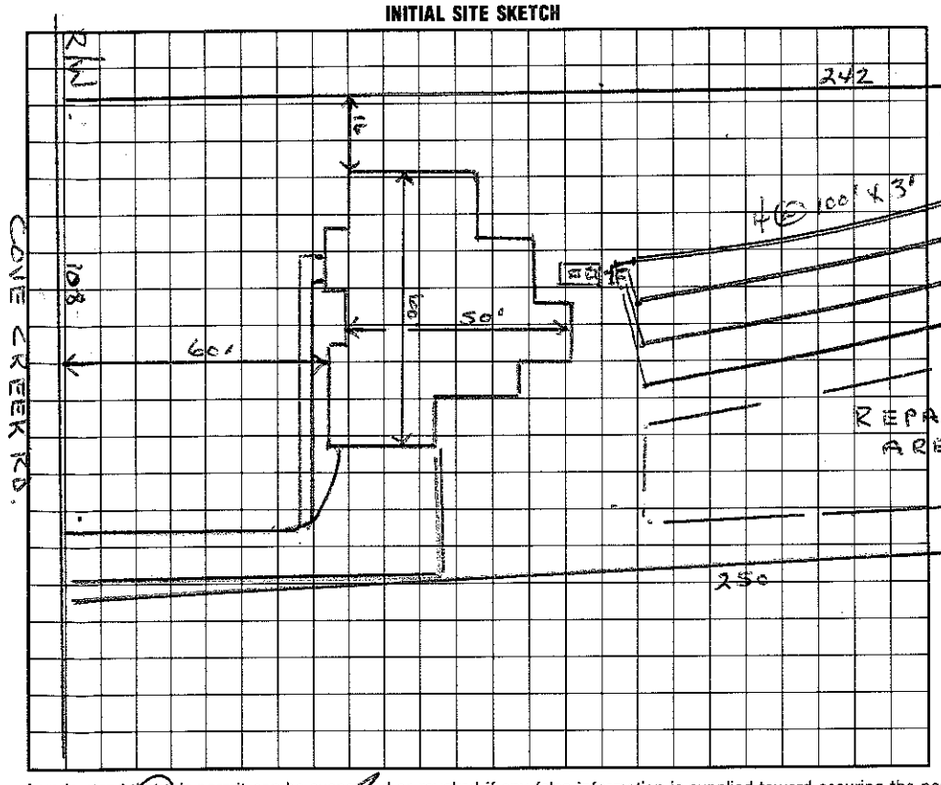

AS BUILT SKETCH

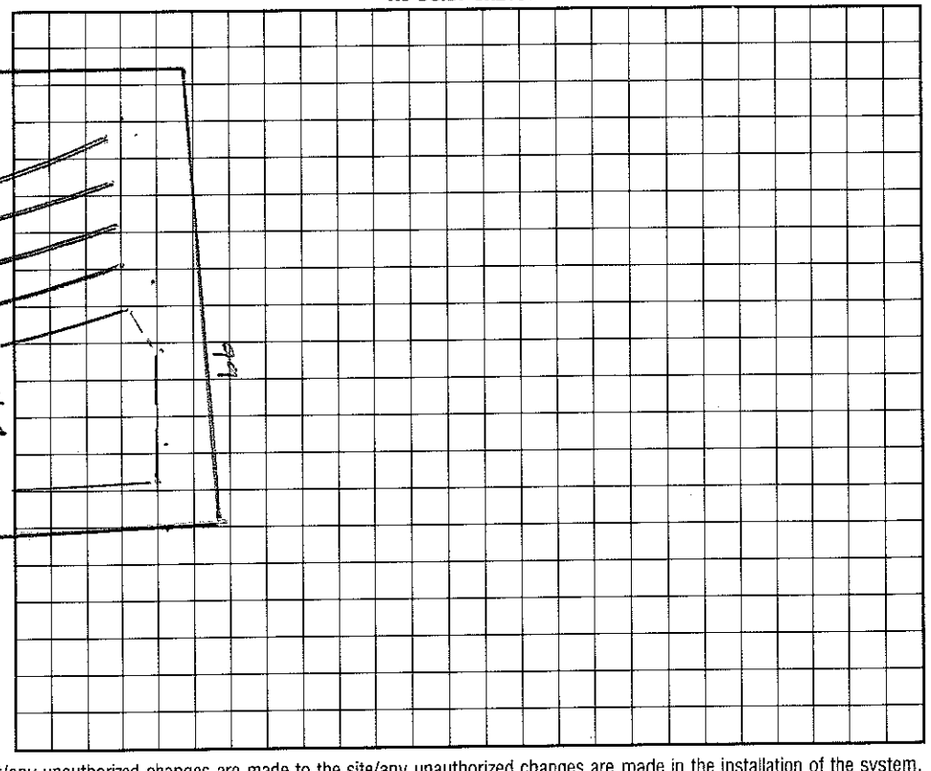

I understand that this permit can be suspended or revoked if any false information is supplied toward securing the permit/any unauthorized changes are made to the site/any unauthorized changes are made in the installation of the system.

Signed: Roger Lovegrove

Improvement Permit by: Wesley Sparks R.S. date 1/11/96

~~System Inspection by:~~ Authorized Wesley Sparks R.S. date 1/11/96

Installed by: Don Horne

Certificate of Completion by: _____ date _____

Operation Permit by: Wesley Sparks RS date 6/26/96

HEALTH DEPT. COPY: WHITE INSPECTION COPY (FINAL): GREEN OWNER COPY (FINAL): YELLOW INSPECTION COPY (INITIAL): PINK OWNER COPY (INITIAL): GOLD