IREDELL COUNTY HEALTH DEPARTMENT

Statesville Office (704) 878-5305 Mooresville Office (704) 660-3625

IMPROVEMENT PERMIT / AUTHORIZATION TO CONSTRUCT / OPERATION PERMIT / EXISTING SYSTEM

16:30

PERMIT # ST Repair

APPLICANT: Anne Goldin APPLICANT ADDRESS: 199 Cove Creek Lp Mooresville, NC PHONE: 704 402 5708 ALT. PHONE:

PIN # 4636 11 4504

SITE ADDRESS: 199 Cove Creek Lp Mooresville, NC 28117

SITE DIRECTIONS: Brawley School Rd TL Isle of Pines TR Cove Creek Lp (2nd) 6th lot on left past Wynsweep

SUBDIVISION: Northshore SECTION: II LOT # 60 LOT AREA: .61 Ac. DESIGN FLOW: 480gpd L.T.A.R.: .3

Septic Tank 1000 (gal) STB IW1500 Date Plastic ☐ New System ☒ Repair ☐ Expansion System Type: I II (III) IV V VI

Pump Tank (gal) PT Infiltrate Date

Pump Make Model Serial #

Nitrification Fields 1 # Lines 10 Linear Ft:

Trench Width 36" Max. Trench Bottom Depth 36" Gravel Depth N/A

System Description: Gravity — Plastic Chambers

Repair System Description: PPBPS

Maintenance Agreement Required: ☐ YES ☒ NO

☒ GRAVITY ☐ PRESSURE

☒ Residence ☐ Business ☐ Other ☐ Slab ☐ Basement w/plumbing

No. Bedrooms 4 No. Persons No. Employees ☐ Crawl Space

Water Supply: ☐ Private ☐ Public ☒ Community ☐ Basement w/o plumbing


Comments / Conditions: ☒ Replacing Septic Tank (ST) only. Installing New ST next to existing ST "Properly Abandon" old ST

OK to use Plastic "Approved" Septic tank

2/21/13 Installed Infiltrate Plastic Tank

Abandoned Exist. ST in place

INITIAL SITE SKETCH

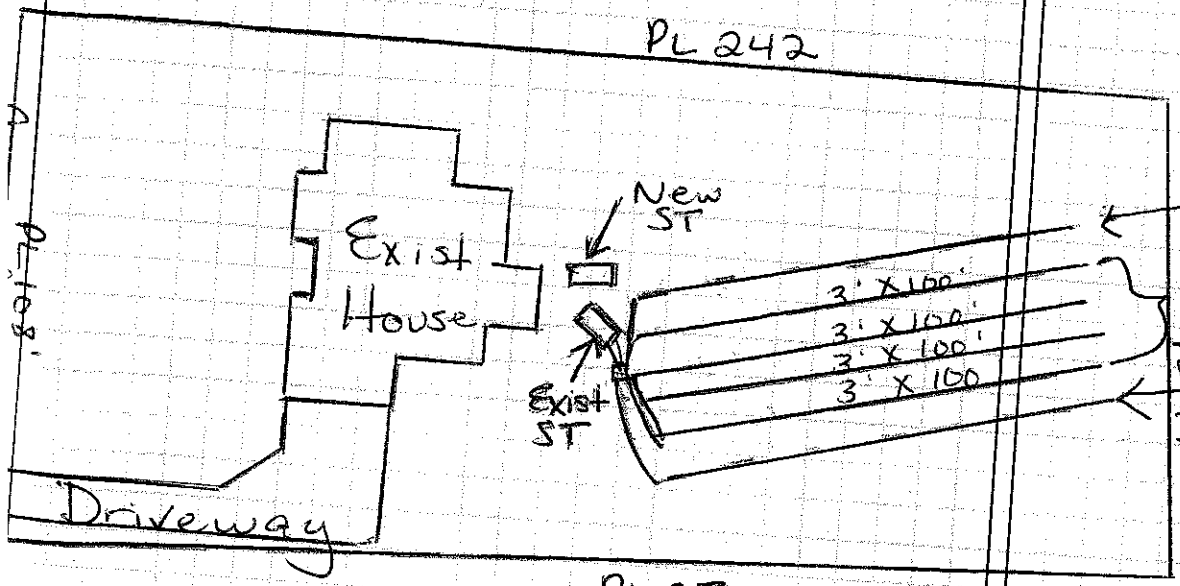

AS BUILT SKETCH

Permit can be suspended or revoked if any false information is supplied toward securing the permit / any unauthorized changes are made to the site / any unauthorized changes are made in the installation of the system. CONTACT A LOCATOR SERVICE PRIOR TO ANY EXCAVATION

☐ IMPROVEMENT PERMIT *with plat* valid without expiration. ☐ IMPROVEMENT PERMIT *with site plan* valid for 60 mos. ☐ AUTHORIZATION TO CONSTRUCT valid for period equal to IMPROVEMENT PERMIT--not to exceed 60 mo.

Owner / Applicant Signature: X Anne Goldin Date: 1/31/13 Installed by: R & H

IMPROVEMENT PERMIT by: Mariah H. Dotson RS Date: 1/30/13 OPERATION PERMIT by: Mariah H. Dotson RS

AUTHORIZATION TO CONSTRUCT by: Mariah H. Dotson RS Date: 1/30/13 Existing System Inspected by: Mariah H. Dotson RS Date: 2/21/13

Health Dept. Copy - WHITE Applicant (Final Approval) - YELLOW Applicant (Conditional Approval) - PINK Date: