IREDELL COUNTY HEALTH DEPARTMENT

STATESVILLE 704-878-5305 MOORESVILLE 704-664-5281

IMPROVEMENT PERMIT / CERTIFICATE OF COMPLETION / OPERATION PERMIT / EXISTING SYSTEM INSPECTION

PROPERTY DESCRIPTION NO. 25322 DATE 8/26/97 TAX MAP NO. 26-23-B-56 4636115198 Watershed: ☑ Yes ☐ No

OWNER OR CONTRACTOR CHRIS ISETTS PHONE: Business _____ Home _____

ADDRESS 400 S TRYON ST # 1300 CHARLOTTE 28202

LOCATION BRAWLEY SCHOOL RD - TL ISLE OF PINES - TR COVE CREEK - 2ND LOT ON CT AFTER WYNSWEPT

SUBDIVISION NORTH SHORE BLOCK / SECTION II LOT 56 LOT AREA _____ SITE CLASS. RS DESIGN FLOW 480 GPD L.T.A.R. .3 GPD/FT

Septic Tank: 1000 Gallons; STB 794 Date 9/11/97

Pump Tank: 1000 Gallons; PT 29 Date _____

Pump Make: HYDROMATIC Model SK50A1 Serial No. 9/97

Nitrification Field: No Fields 1 Square Feet 540 Linear Feet 270

No Lines 6@45' Trench Width 24" Max Trench Bottom Depth 36" Gravel Depth N/A

☐ New System ☐ Repair System Type: I, II, ☑ III, IV, V, VI

System Description: PUMP PANEL

Repair System Description: PUMP PANEL

Maintenance Agreement Required: ☐ Yes ☑ No

☑ House/Mod. Home No. Bedrooms 4

☐ Mobile Home No. Bathrooms 4

☐ Business No. Employees _____

☐ Other _____


☐ Slab ☑ Crawl Space ☐ Basement w/plumbing ☐ Basement wo/plumbing

Water Supply: ☐ Individual ☑ Community ☐ Public

Comments:

Comments:

INITIAL SITE SKETCH

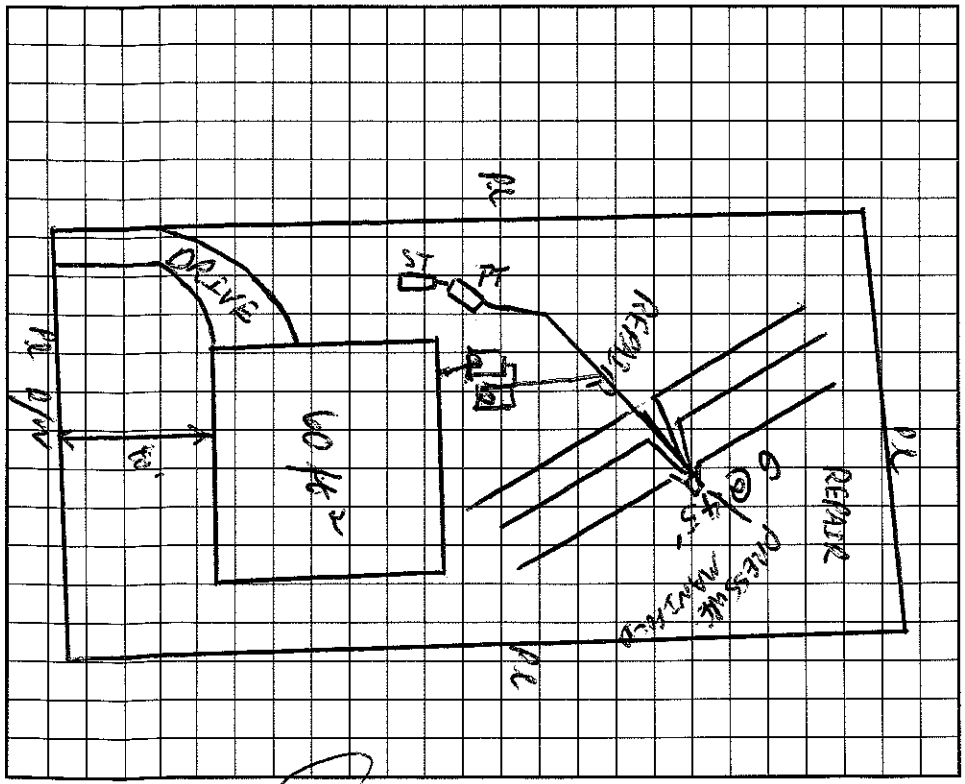

AS BUILT SKETCH

I understand that this permit can be suspended or revoked if any false information is supplied toward securing the permit/any unauthorized changes are made to the site/any unauthorized changes are made in the installation of the system. Improvement Permit is valid for 60 months from date of issuance.

Signed: _____

Improvement Permit by: _____ date 8/26/97

~~Authorization to Existing System Inspection by:~~ _____ date 8/26/97

Installed by: Tim Ammons

Certificate of Completion by: Wesley Sparks RS date 12/10/97

Operation Permit by: Wesley Sparks RS date 12/10/97

HEALTH DEPT. COPY: WHITE INSPECTION COPY (FINAL): GREEN OWNER COPY (FINAL): YELLOW INSPECTION COPY (INITIAL): PINK OWNER COPY (INITIAL): GOLD