IREDELL COUNTY HEALTH DEPARTMENT

STATESVILLE 704-878-5305 MOORESVILLE 704-664-5281

IMPROVEMENT PERMIT / AUTHORIZATION TO CONSTRUCT / OPERATION PERMIT / EXISTING SYSTEM INSPECTION

PERMIT# Repair PIN# 4636-11-5238 DATE 5/1/01

OWNER OR CONTRACTOR Tim Condron PHONE: Business Home 662-9003

ADDRESS 185 Cove Creek Rd. Mooresville, NC 28117

LOCATION 1100 TR slate Pines TR Cove Creek Rd. 3 BR on (L) past Wynsweept

SUBDIVISION North Shore BLOCK / SECTION 3 LOT 57 LOT AREA SITE CLASS. PS DESIGN FLOW 480 L.T.A.R. .3

Septic Tank: EXISTING Gallons; STB Date

Pump Tank: Gallons; PT Date

Pump Make: Model 500 Serial No.

Nitrification Field: No Fields Square Feet 528 Linear Feet 250

No Lines 4 Trench Width 2' Max Trench Bottom Depth 3'+ ~~Gravel Depth~~ SAND.

☐ New System ☒ Repair System Type: I, II, (III), IV, V, VI

System Description:

Repair System Description: 16" PP BAS + Dist Box

Maintenance Agreement Required: ☐ Yes ☒ No

☒ House/Mod. Home No. Bedrooms 4

☐ Mobile Home No. Bathrooms 2.5

☐ Business No. Employees

☐ Other


☐ Slab ☒ Crawl Space ☐ Basement w/plumbing ☐ Basement wo/plumbing

Water Supply: ☐ Individual ☐ Public ☒ Community


Comments:/Conditions:

Comments:/Conditions: 4/8/02 Zabel filter installed today.

INITIAL SITE SKETCH

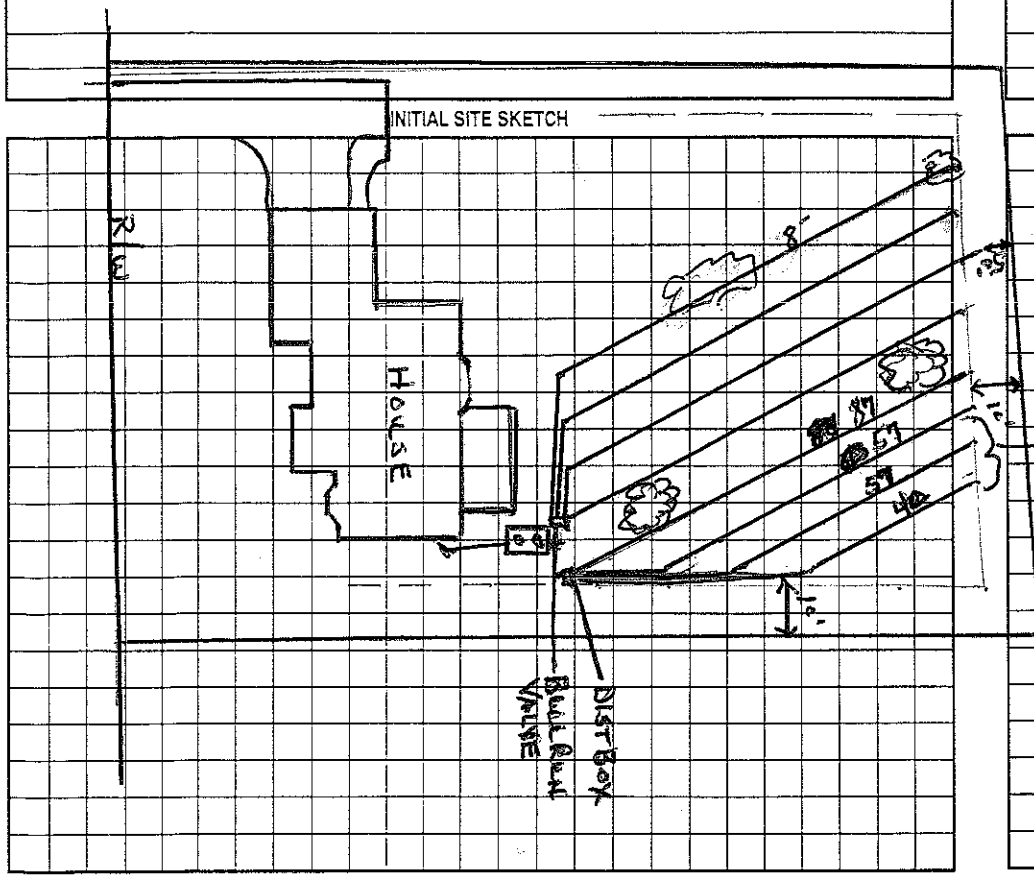

AS BUILT SKETCH

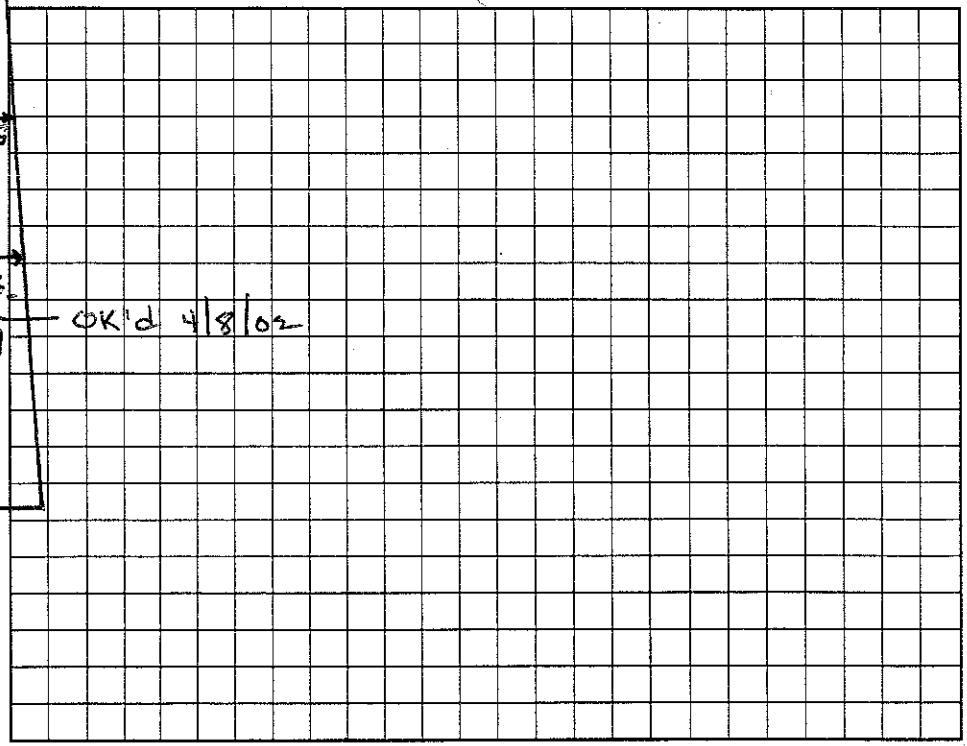

Permit can be suspended or revoked if any false information is supplied toward securing the permit/any unauthorized changes are made to the site/any unauthorized changes are made in the installation of the system. Improvement Permit with plat valid without expiration. Improvement Permit with site plan valid for sixty months. Authorization to Construct is valid for a period equal to that of Improvement Permit – not to exceed sixty months.

Signed: * Tim Condron date 1/24/02

Improvement Permit by: Wesley Sparks RS date 5/1/01

Authorization to Construct by: Wesley Sparks RS. date 5/1/01

Installed by: Stanley Septic Tank

Operation Permit by: Wesley Sparks RS date 4/9/02

Existing System Inspection by: date

HEALTH DEPT. COPY: WHITE OWNER COPY (FINAL): YELLOW OWNER COPY (INITIAL): PINK