"B" 3 00

IREDELL COUNTY HEALTH DEPARTMENT

STATESVILLE 704-878-5305 MOORESVILLE 704-664-5281

IMPROVEMENT PERMIT / CERTIFICATE OF COMPLETION / OPERATION PERMIT / EXISTING SYSTEM INSPECTION

PROPERTY DESCRIPTION NO. 25326 DATE 1/17/97 TAX MAP NO. 26-23-B-62 Watershed: ☑ Yes ☐ No

OWNER OR CONTRACTOR ~~CRESCENT RESOURCES~~ Brawlin Const. Co. PHONE: Business 663-6905 T. JACOBS ~~Home~~ 4636-11-6588

ADDRESS 400 S. TRYON ST CHARLOTTE 28202

LOCATION BRAWLEY SCHOOL. TL ISLE OF PINES - TR COVE CREEK, 1ST ON RT AFTER MUSSEL - Corner Lot

SUBDIVISION NORTH SHORE BLOCK / SECTION II LOT 62 LOT AREA — SITE CLASS. PS DESIGN FLOW 480 L.T.A.R. .3 gpd/ft²

Septic Tank: 1000 Gallons; STB 794 Date 8/14/97

Pump Tank: ______ Gallons; PT ______ Date ______

Pump Make: ______ Model ______ Serial No. ______

Nitrification Field: No Fields 1 Square Feet 810 Linear Feet 270

No Lines 6 @ 45' Trench Width 24" Max Trench Bottom Depth 36" Gravel Depth N/A

☑ New System ☐ Repair System Type: I, II, (III), IV, V, VI

System Description: GRAVITY PANEL

Repair System Description: SAME

Maintenance Agreement Required: ☐ Yes ☑ No

☐ Slab ☑ Crawl Space ☐ Basement w/plumbing ☐ Basement wo/plumbing

☑ House/Mod. Home No. Bedrooms 4

☐ Mobile Home No. Bathrooms 4

☐ Business No. Employees ______


☐ Other ______

Water Supply: ☐ Individual ☑ Community ☐ Public

Comments: 608-7024

Comments:

INITIAL SITE SKETCH

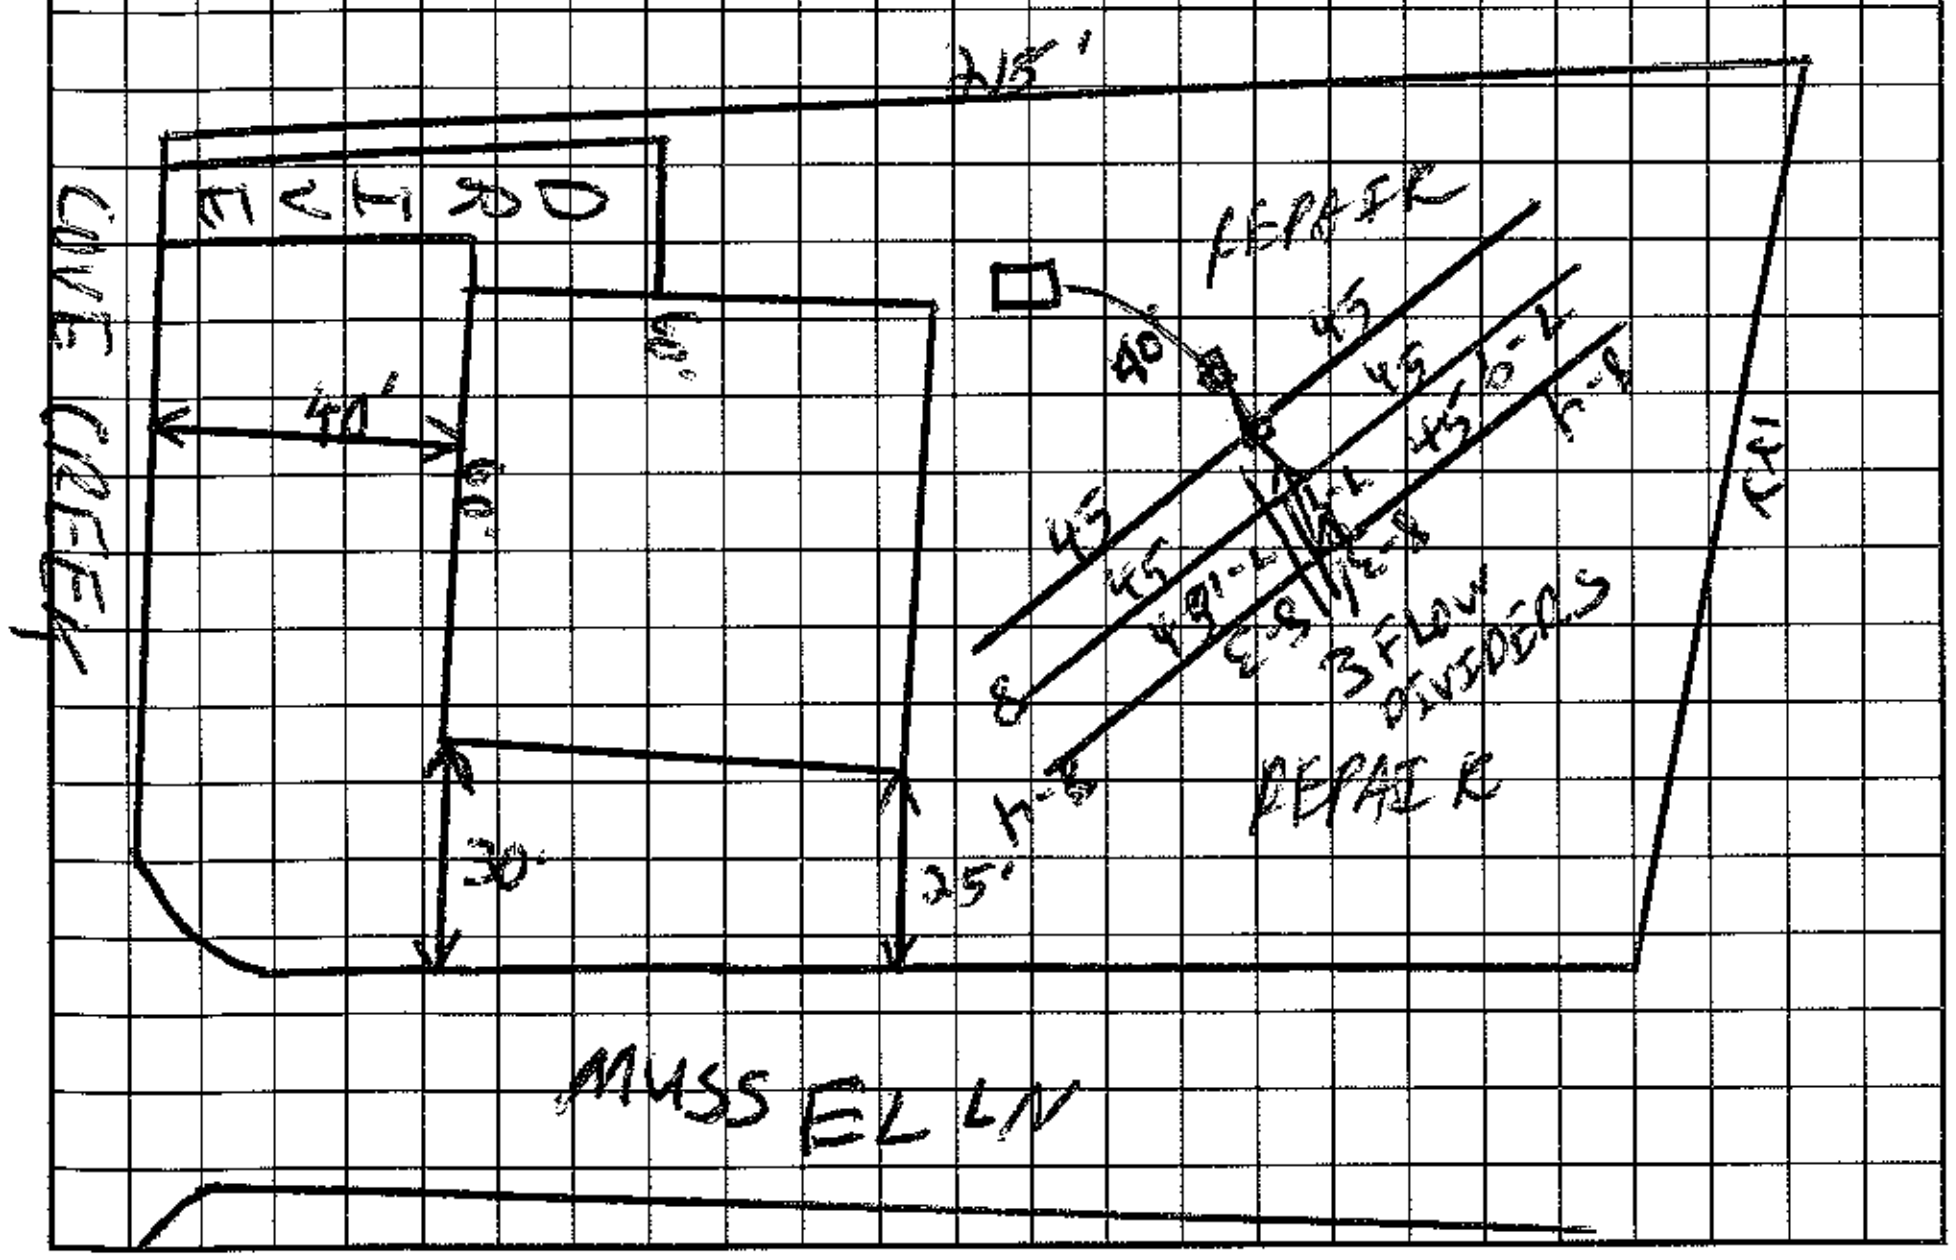

AS BUILT SKETCH

I understand that this permit can be suspended or revoked if any false information is supplied toward securing the permit/any unauthorized changes are made to the site/any unauthorized changes are made in the installation of the system. Improvement Permit is valid for 60 months from date of issuance.

Signed: Tony C. Jacobs CPSS 1-22-97

Installed by: Curt Dunning

Improvement Permit by: C. Bly ~~Lotto~~ EHSI date 1/17/97

Certificate of Completion by: Wesley Speaks RS date 11/5/97

Existing System Inspection: Auth. To Construct Wesley Speaks RS date 6/5/97

Operation Permit by: Wesley Speaks RS. date 11/5/97

HEALTH DEPT. COPY: WHITE INSPECTION COPY (FINAL): GREEN OWNER COPY (FINAL): YELLOW INSPECTION COPY (INITIAL): PINK OWNER COPY (INITIAL): GOLD