IREDELL COUNTY HEALTH DEPARTMENT

Authorization to Construct

STATESVILLE 704-878-5305 MOORESVILLE 704-664-5281

IMPROVEMENT PERMIT / ~~CERTIFICATE OF COMPLETION~~ / OPERATION PERMIT / EXISTING SYSTEM INSPECTION

PROPERTY DESCRIPTION NO. 24452 DATE 7/19/96 TAX MAP NO. 2&23 B75 Watershed: [X] Yes [ ] No

OWNER OR CONTRACTOR Robert Ingram Homes ~~PHONE: Business~~ 436-11-7394 Home 391-3715

ADDRESS 2900 B I 85 Service Rd. Charlotte, NC 28208

LOCATION Isle of Pines, TR Cove Creek Rd. lot on (R) before Mussel Lane

SUBDIVISION North Shore BLOCK / SECTION III LOT ~~SIZE~~ 5 LOT AREA 100x225 SITE CLASS. PS DESIGN FLOW 480 L.T.A.R. .3

Septic Tank: 1000 Gallons; STB 794 Date 5/24/96

Pump Tank: _____ Gallons; PT _____ Date _____

Pump Make: _____ Model _____ Serial No. _____

Nitrification Field: No Fields 1 Square Feet 1600 Linear Feet 400

No Lines 4 Trench Width 36" Max Trench Bottom Depth 36" Gravel Depth SAND

[X] New System [ ] Repair System Type: I, II, (III), IV, V, VI

System Description: GR CH PLASTIC

Repair System Description: SAME

Maintenance Agreement Required: [ ] Yes [X] No

[X] House/Mod. Home No. Bedrooms 4

[ ] Mobile Home No. Bathrooms 3

[ ] Business No. Employees _____

[ ] Other _____


[ ] Slab [X] Crawl Space [ ] Basement w/plumbing [ ] Basement wo/plumbing

Water Supply: [ ] Individual [X] Community [ ] Public


Comments: Gravity Ch Plastic on slope contour in direction shown.

Comments:

INITIAL SITE SKETCH

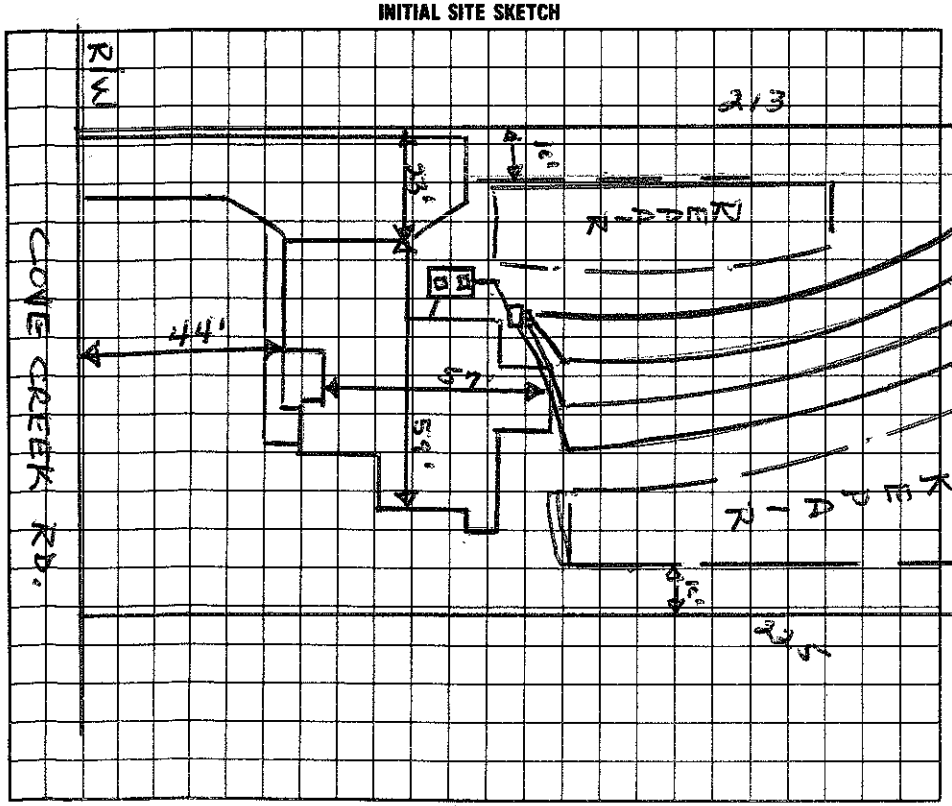

AS BUILT SKETCH

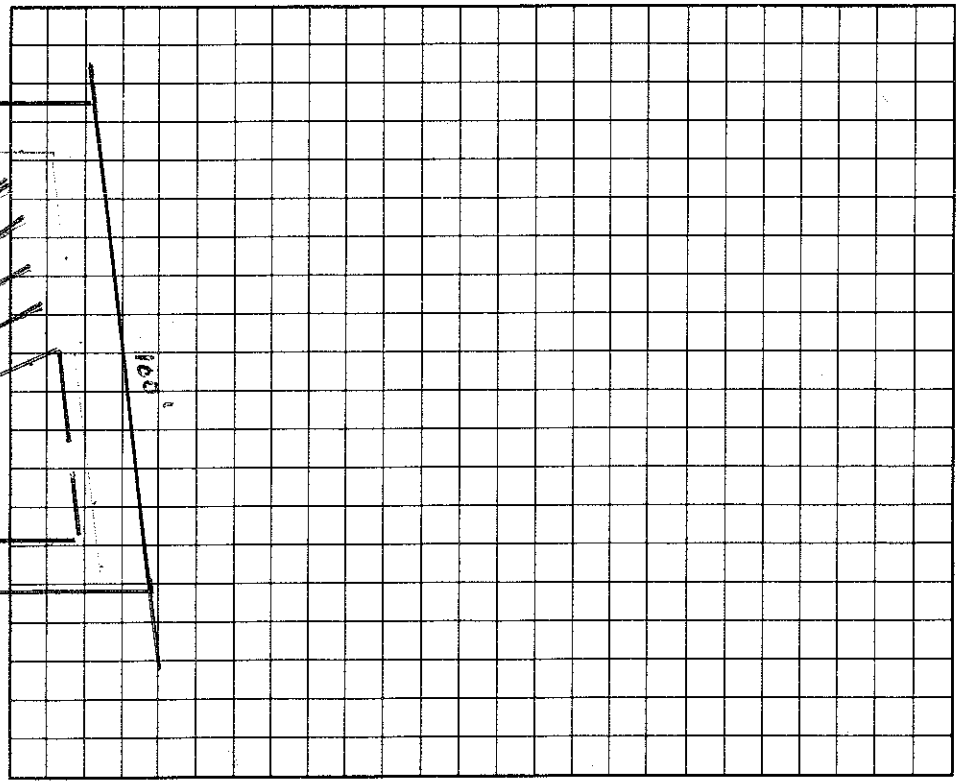

I understand that this permit can be suspended or revoked if any false information is supplied toward securing the permit/any unauthorized changes are made to the site/any unauthorized changes are made in the installation of the system.

Authorization to Construct valid indefinitely.

Signed: X _____

Installed by: _____

Improvement Permit by: Wesley Sparks R.S. date 7/19/96

Certificate of Completion by: _____ date _____

Existing System Inspection by: Wesley Sparks R.S. date 7/19/96

Operation Permit by: Wesley Sparks R.S. date 11/27/96

Authorization

HEALTH DEPT. COPY: WHITE INSPECTION COPY (FINAL): GREEN OWNER COPY (FINAL): YELLOW INSPECTION COPY (INITIAL): PINK OWNER COPY (INITIAL): GOLD