IREDELL COUNTY HEALTH DEPARTMENT

Auth' to Inspection to Construct

STATESVILLE 704-878-5305 MOORESVILLE 704-664-5281

IMPROVEMENT PERMIT / ~~CERTIFICATE OF COMPLETION~~ / OPERATION PERMIT / EXISTING SYSTEM INSPECTION

PROPERTY DESCRIPTION NO. 25686 DATE 12/13/96 TAX MAP NO. 2G-23-A-76 Watershed: X Yes ☐ No

OWNER OR CONTRACTOR Robert Ringstem Homes PHONE: Business 391-3715 ~~Home~~ 4636-11-8253

ADDRESS 2900 BS I-85 Service Rd. Chas. NC. 28208

LOCATION Brawley Sch Rd. (L) on Table Pines on (R) before Mussel Ln.

SUBDIVISION North Shore BLOCK / SECTION II LOT 76 LOT AREA 0.63 SITE CLASS. PS DESIGN FLOW 480 L.T.A.R. .3

Septic Tank: 1000 Gallons; STB 794 Date 1/7/97

Pump Tank: _____ Gallons; PT _____ Date _____

Pump Make: _____ Model _____ Serial No. _____

Nitrification Field: No Fields 1 Square Feet 1200± Linear Feet 400±

No Lines 4 Trench Width 36" Max Trench Bottom Depth 30-32" Gravel Depth STONE

X New System ☐ Repair System Type: I, II, III, IV, V, VI

System Description: X-CRAN-CH PLASTIC

Repair System Description: PRESSURE PANEL

Maintenance Agreement Required: ☐ Yes X No

X House/Mod. Home No. Bedrooms 4

☐ Mobile Home No. Bathrooms 3.5

☐ Business No. Employees _____

☐ Other _____


☐ Slab X Crawl Space ☐ Basement w/plumbing ☐ Basement wo/plumbing

Water Supply: ☐ Individual X Community ☐ Public


Comments:

Comments:

INITIAL SITE SKETCH

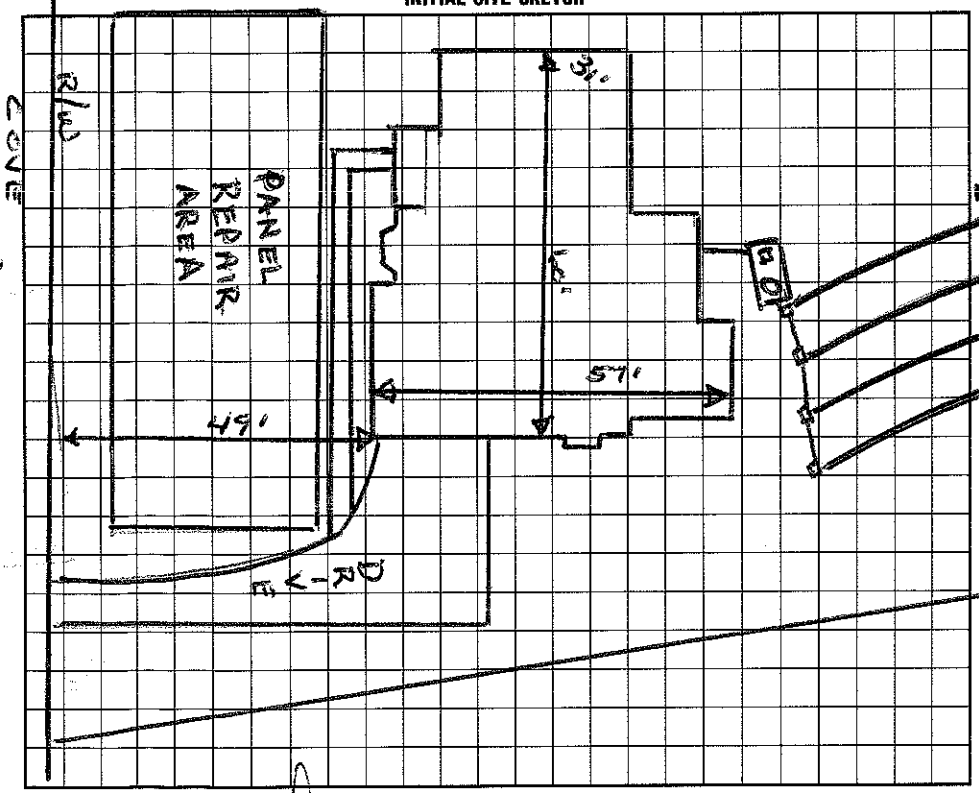

AS BUILT SKETCH

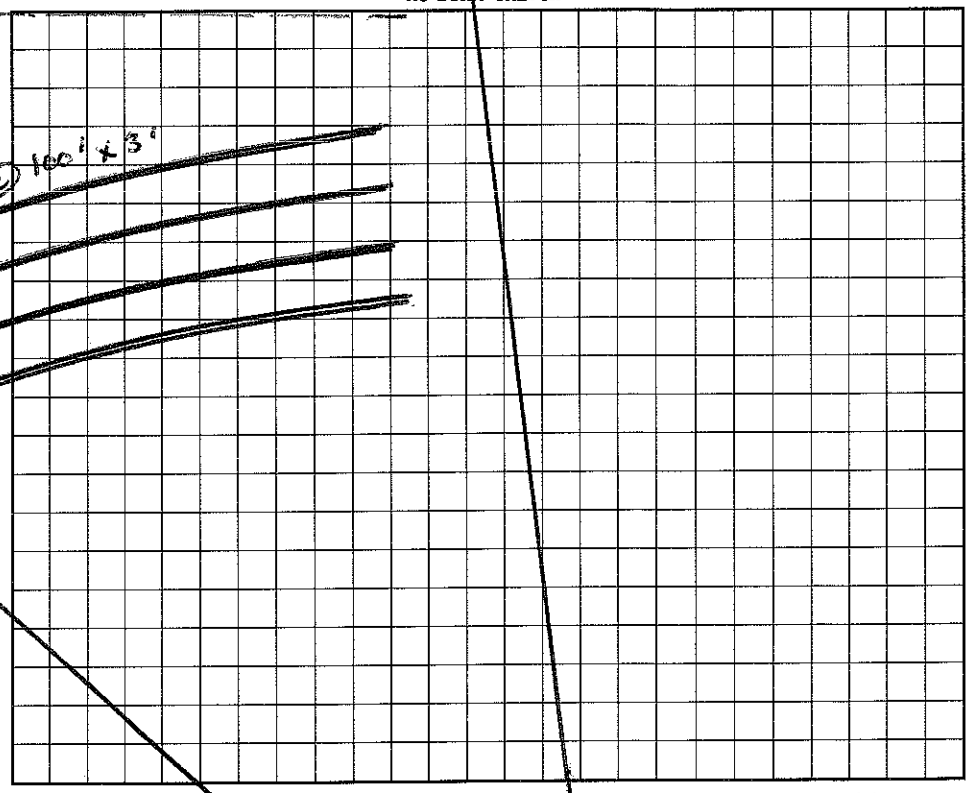

I understand that this permit can be suspended or revoked if any false information is supplied toward securing the permit/any unauthorized changes are made to the site/any unauthorized changes are made in the installation of the system.

Signed: S. Taylor

Improvement Permit by: Wesley Sparks RS. date 12/13/96

Existing System Inspection by: Wesley Sparks RS. date 12/13/96

Installed by: Ken Plaster - Johnson Home Building

Certificate of Completion by: Wesley Sparks RS date 4/1/97

Operation Permit by: Wesley Sparks RS date 4/1/97

Auth' to Construct

HEALTH DEPT. COPY: WHITE INSPECTION COPY (FINAL): GREEN OWNER COPY (FINAL): YELLOW INSPECTION COPY (INITIAL): PINK OWNER COPY (INITIAL): GOLD