IREDELL COUNTY HEALTH DEPARTMENT

Authorization to Construct

STATESVILLE 704-878-5305 MOORESVILLE 704-664-5281

IMPROVEMENT PERMIT / ~~CERTIFICATE OF COMPLETION~~ / OPERATION PERMIT / EXISTING SYSTEM INSPECTION

PROPERTY DESCRIPTION NO. 23455 DATE 3/28/96 TAX MAP NO. 2C 23 B 63 4636 11 8639 Watershed: [X] Yes [ ] No

OWNER OR CONTRACTOR Robert Ingram Homes PHONE: Business 391-3715 Home

ADDRESS 2900 B I-85 S Service Road Carolina Business Center Charlotte, NC 28208

LOCATION Style of Pines TR Cove Creek Rd. TR Mussel Ln approx 150' on (L)

SUBDIVISION North Shore II BLOCK / SECTION II ph3 LOT 63 LOT AREA .75AC SITE CLASS. PS DESIGN FLOW 480 L.T.A.R. .3

Septic Tank: 1000 Gallons; STB 797 Date 5/9/96

Pump Tank: 1000 Gallons; PT 27 Date 5/26/96

Pump Make: Model Serial No.

Nitrification Field: No Fields 1 Square Feet 1600 Linear Feet 267 *

No Lines 4 Trench Width 24" Max Trench Bottom Depth 36" Gravel Depth SAND

[X] New System [ ] Repair System Type: I, II, (III), IV, V, VI

System Description: 16" Prefab. Panel Blocks

Repair System Description: Same

Maintenance Agreement Required: [ ] Yes [X] No

[X] House/Mod. Home No. Bedrooms 4

[ ] Mobile Home No. Bathrooms 3.5

[ ] Business No. Employees

[ ] Other


[ ] Slab [X] Crawl Space [ ] Basement w/plumbing [ ] Basement wo/plumbing

Water Supply: [ ] Individual [X] Community [ ] Public

Comments: * Pressure Manifold Required

Comments:

INITIAL SITE SKETCH

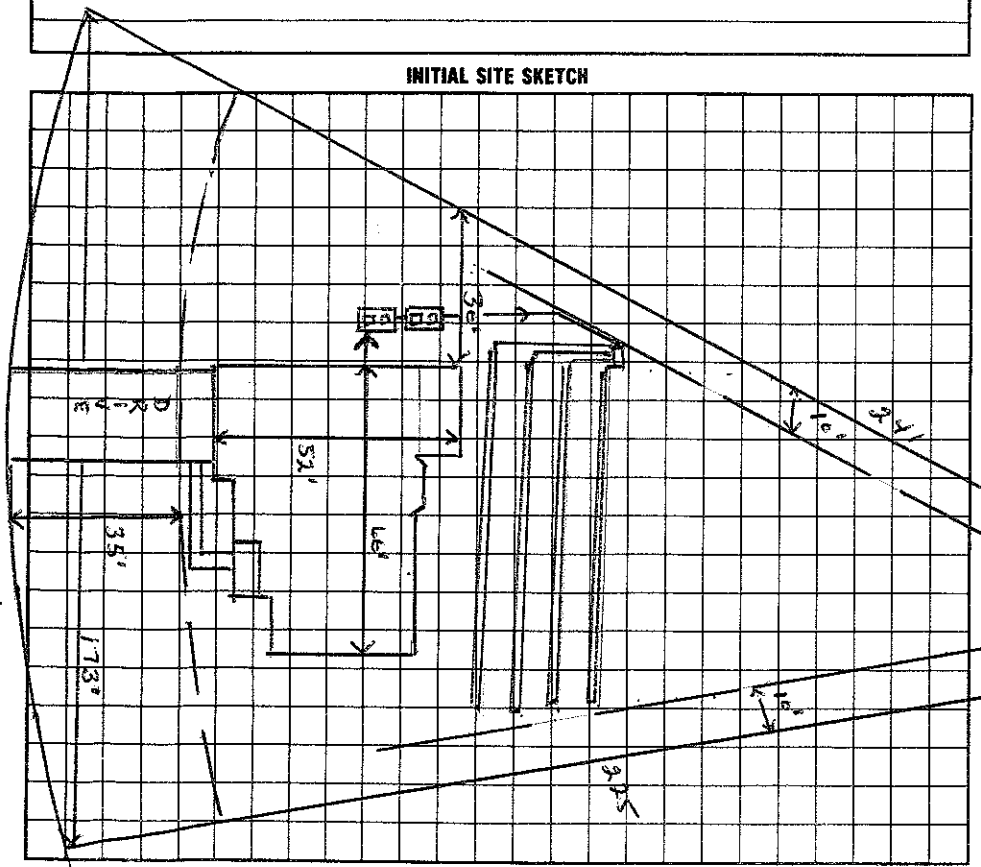

AS BUILT SKETCH

1" = 40'

I understand that this permit can be suspended or revoked if any false information is supplied toward securing the permit/any unauthorized changes are made to the site/any unauthorized changes are made in the installation of the system.

Authorization to Construct valid for 5 years.

Signed: 3/29/96

Improvement Permit by: Wesley Sparks RS date 3/28/96

Authorization to Construct by: Wesley Sparks RS. date 3/28/96

Installed by: Ingram Homes Builder

Certificate of Completion by: date

Operation Permit by: Wesley Sparks RS. date 7/18/96

HEALTH DEPT. COPY: WHITE INSPECTION COPY (FINAL): GREEN OWNER COPY (FINAL): YELLOW INSPECTION COPY (INITIAL): PINK OWNER COPY (INITIAL): GOLD