IREDELL COUNTY HEALTH DEPARTMENT

STATESVILLE 704-878-5305 MOORESVILLE 704-664-5281

IMPROVEMENT PERMIT / CERTIFICATE OF COMPLETION / OPERATION PERMIT / EXISTING SYSTEM INSPECTION

PROPERTY DESCRIPTION NO. 20618 DATE April 30, '95 TAX MAP NO. part of 2178 10 Watershed: ☐ Yes ☐ No WSIV

OWNER OR CONTRACTOR Crescent Resources Inc (Kenneth Young) PHONE: Business Home 41636-11-8850

ADDRESS PO Box 1033 Charlotte

LOCATION Brawley Sch Rd. TL 1113 TR Cove Creek TR Mussel Ct. 3rd lot on left

SUBDIVISION North Shore BLOCK / SECTION IV - 3 LOT 64 LOT AREA 21780 ft² SITE CLASS I Spec 1996 DESIGN FLOW 480 gpd L.T.A.R. .03

Septic Tank: 1000 Gallons; STB 794 Date 3/17/99

Pump Tank: 1000 Gallons; PT 27 Date 4/1-99

Pump Make: _____ Model _____ Serial No. _____

Nitrification Field: No Fields 1 Square Feet _____ Linear Feet 267'

No Lines 4 Trench Width 24" Max Trench Bottom Depth 36" Gravel Depth NA

☑ New System ☐ Repair System Type: I, II, III, (IV) V, VI

System Description: LPP PBRS

Repair System Description: Same

Maintenance Agreement Required: ☑ Yes ☐ No

☑ House/Mod. Home No. Bedrooms 4/4

☐ Mobile Home No. Bathrooms 4

☐ Business No. Employees _____

☐ Other _____

☐ Slab ☑ Crawl Space ☐ Basement w/plumbing ☐ Basement wo/plumbing


Water Supply: ☐ Individual ☑ Community ☐ Public

Comments:


Comments: DEVELOPER PERMIT

1" = 50'

INITIAL SITE SKETCH

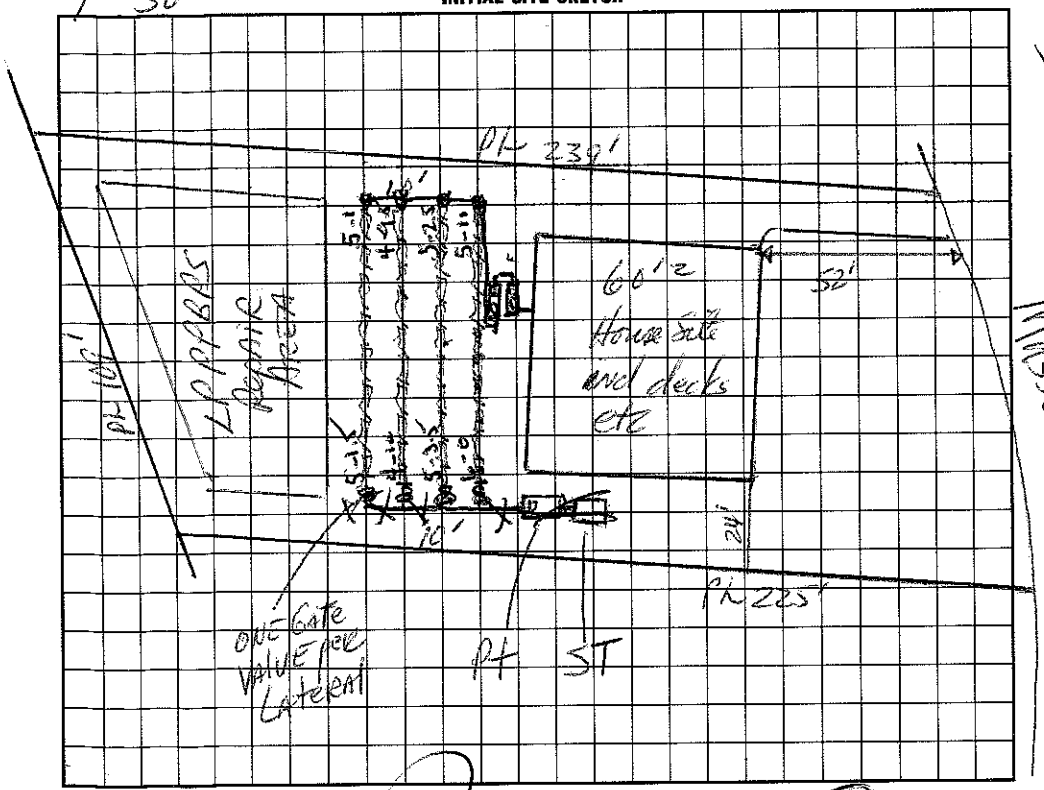

AS BUILT SKETCH

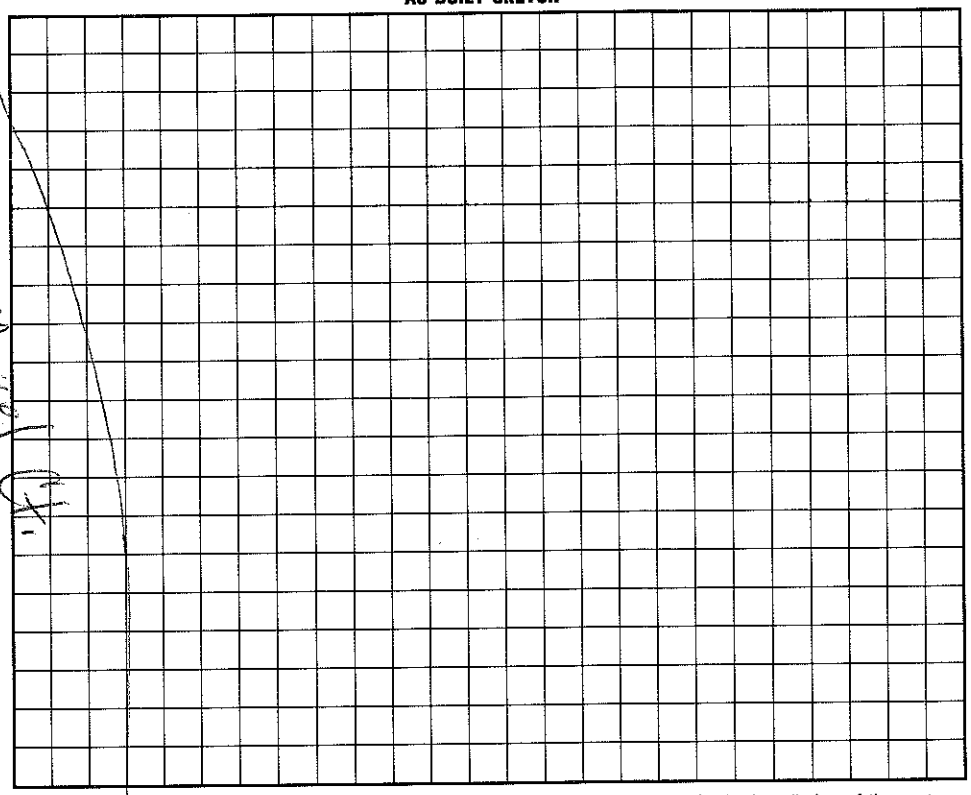

I understand that this permit can be suspended or revoked if any false information is supplied toward securing the permit/any unauthorized changes are made to the site/any unauthorized changes are made in the installation of the system. Improvement Permit is valid for 60 months from date of issuance.

Signed: _____

Improvement Permit by: _____ date 4/30/95

~~Existing System Inspection~~ by: Wesley Sparks R.S. date 10/27/98

Installed by: R+H elec.

Certificate of Completion by: Wesley Sparks R.S. date 9/24/99

Operation Permit by: Wesley Sparks R.S. date 9/24/99

HEALTH DEPT. COPY: WHITE INSPECTION COPY (FINAL): GREEN OWNER COPY (FINAL): YELLOW INSPECTION COPY (INITIAL): PINK OWNER COPY (INITIAL): GOLD