IREDELL COUNTY HEALTH DEPARTMENT

Authorization to Construct

STATESVILLE 704-878-5305 MOORESVILLE 704-664-5281

IMPROVEMENT PERMIT / ~~CERTIFICATE OF COMPLETION~~ / OPERATION PERMIT / EXISTING SYSTEM INSPECTION

PROPERTY DESCRIPTION NO. 24238 DATE 7/15/96 TAX MAP NO. 2623A65 4636 11 8962 Watershed: ☒ Yes ☐ No

OWNER OR CONTRACTOR Robert Clayton Homes PHONE: Business _____ Home 391-3715

ADDRESS 2900 B I 85 Sandifer Rd. Charlotte, NC. 28208

LOCATION Brawley School Rd. Treble Pines TR Cove Creek TR Mussel Ln., 4th lot on (L)

SUBDIVISION North Shore BLOCK / SECTION III LOT 65 LOT AREA .78 SITE CLASS. PS DESIGN FLOW 480 L.T.A.R. .3

Septic Tank: 1000 Gallons; STB 794 Date 9/29/96

Pump Tank: 1000 Gallons; PT 29 Date 9/29/96

Pump Make: Zoeller Model E165-C Serial No. 006803-A

Nitrification Field: No Fields 1 Square Feet 1600 Linear Feet 400

No Lines 5 Trench Width 36" Max Trench Bottom Depth 36" Gravel Depth SAND

☒ New System ☐ Repair System Type: I. II. III. IV. V. VI.

System Description: Pressure - ch. plastic

Repair System Description: ~~Same~~ Panel Repair

Maintenance Agreement Required: ☐ Yes ☒ No

☒ House/Mod. Home No. Bedrooms 4

☐ Mobile Home No. Bathrooms 2.5

☐ Business No. Employees ____

☐ Other ____

☐ Slab ☒ Crawl Space ☐ Basement w/plumbing ☐ Basement wo/plumbing


Water Supply: ☐ Individual ☒ Community ☐ Public

Comments:


Comments: 480 / 16 / 240 160

Final Electrical - Landscaping Pending - 11/1/96

INITIAL SITE SKETCH

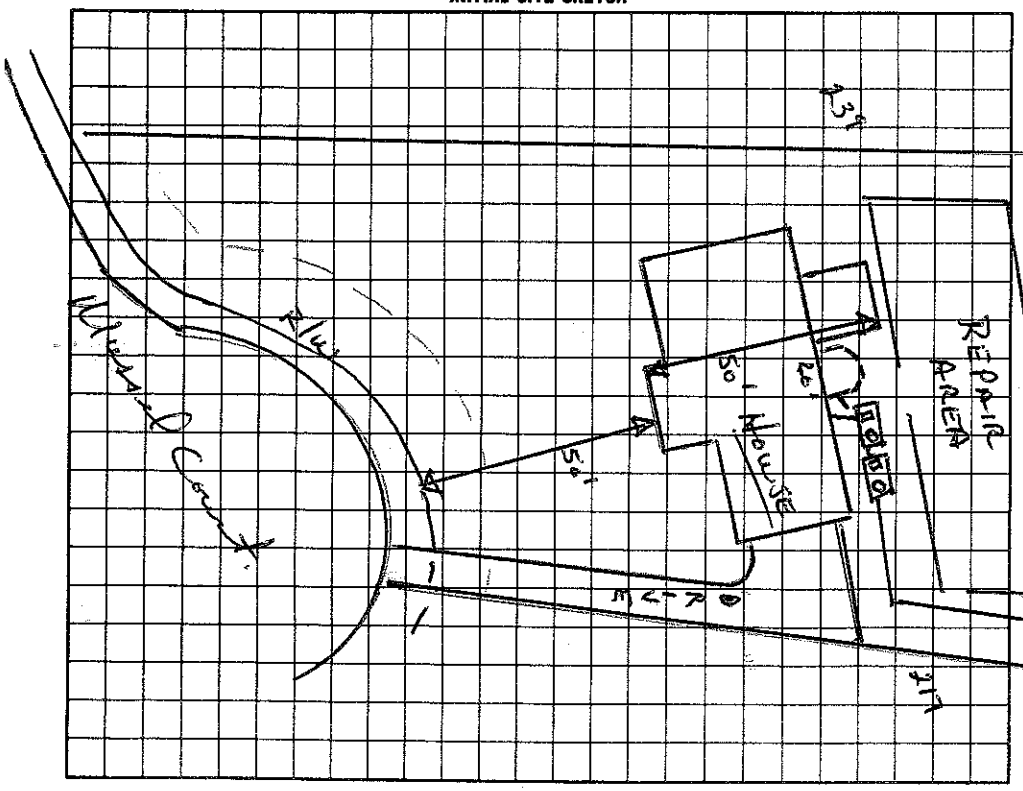

AS BUILT SKETCH

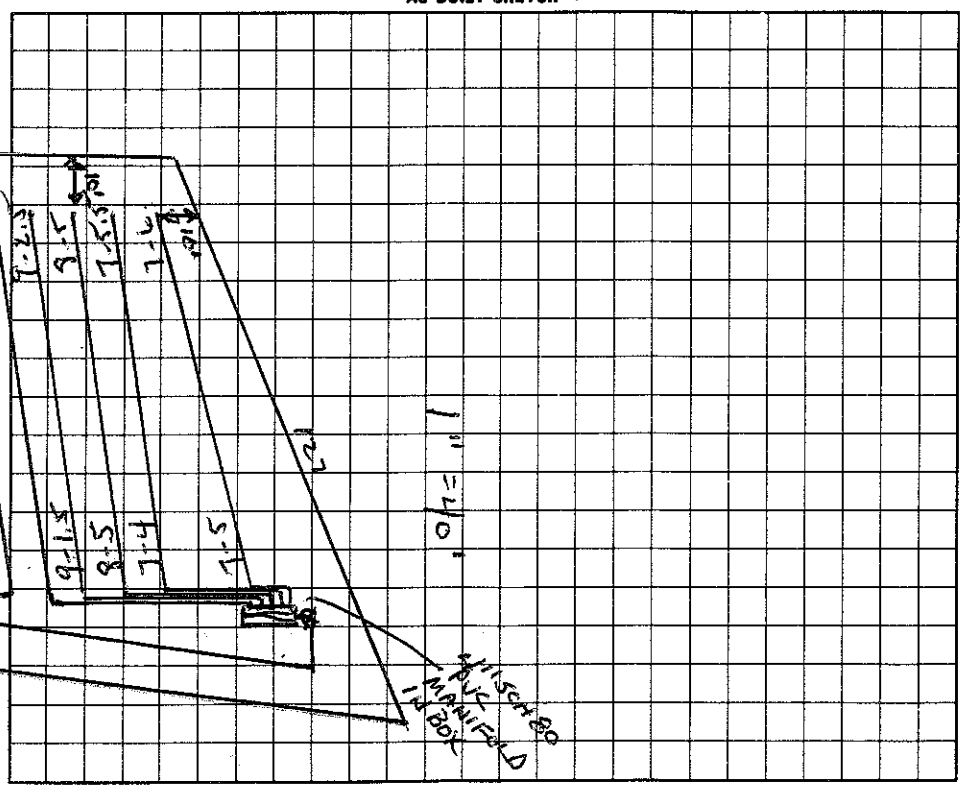

I understand that this permit can be suspended or revoked if any false information is supplied toward securing the permit/any unauthorized changes are made to the site/any unauthorized changes are made in the installation of the system.

Authorization to Construct valid 60 months.

Signed: _____

Improvement Permit by: Wesley Sparks R.S. date 7/16/96

Existing System Inspection by: Wesley Sparks R.S. date 9/16/96

Installed by: Shaw Home Grading

Certificate of Completion by: _____ date _____

Operation Permit by: Wesley Sparks R.S. date 12/13/96

HEALTH DEPT. COPY: WHITE INSPECTION COPY (FINAL): GREEN OWNER COPY (FINAL): YELLOW INSPECTION COPY (INITIAL): PINK OWNER COPY (INITIAL): GOLD