IREDELL COUNTY HEALTH DEPARTMENT

Statesville Office (704) 878-5305 Mooresville Office (704) 660-3625 PERMIT # 209265

IMPROVEMENT PERMIT / AUTHORIZATION TO CONSTRUCT / OPERATION PERMIT / EXISTING SYSTEM

PIN # 4636120805

APPLICANT: CP III LLC APPLICANT ADDRESS: 3125 Presidential Pkwy Ste 200 Atlanta, GA 30430

SITE ADDRESS: 318 Cove Creek Mooresville, NC PHONE: 7049289215 ALT. PHONE:

SITE DIRECTIONS: Brawley School Rd TL Isle of Pines TR Cove Creek Rd on left.

SUBDIVISION: Chesapeake Pt SECTION: 2 LOT # 85 LOT AREA: .74 Acre DESIGN FLOW: 600gpd L.T.A.R.: .3

Septic Tank 1500 (gal) STB 444 Date 9-5-15
Pump Tank (gal) PT Date
Pump Make Model Serial #
Nitrification Fields 1 # Lines 5 Linear Ft: 500FT
Trench Width 36" Max. Trench Bottom Depth 36" Gravel Depth N/A

[X] New System [ ] Repair [ ] Expansion System Type: I II (III) IV V VI
System Description: Gravity - 25% Reduction
Repair System Description: LPP BPS
Maintenance Agreement Required: [ ] YES [X] NO
[X] GRAVITY [ ] PRESSURE

[X] Residence No. Bedrooms 5
[ ] Business No. Persons 10
[ ] Other No. Employees
[ ] Slab [X] Crawl Space
[ ] Basement w/plumbing [ ] Basement w/o plumbing

Water Supply: [ ] Private [ ] Public [X] Community

Comments / Conditions:

This permit replaces the previous permit dated 10/27/2006

INITIAL SITE SKETCH

See attached/approved plan by Michael Athanas & Assoc. dated 5/20/15

AS BUILT SKETCH

Permit can be suspended or revoked if any false information is supplied toward securing the permit / any unauthorized changes are made to the site / any unauthorized changes are made in the installation of the system. **CONTACT A LOCATOR SERVICE PRIOR TO ANY EXCAVATION**

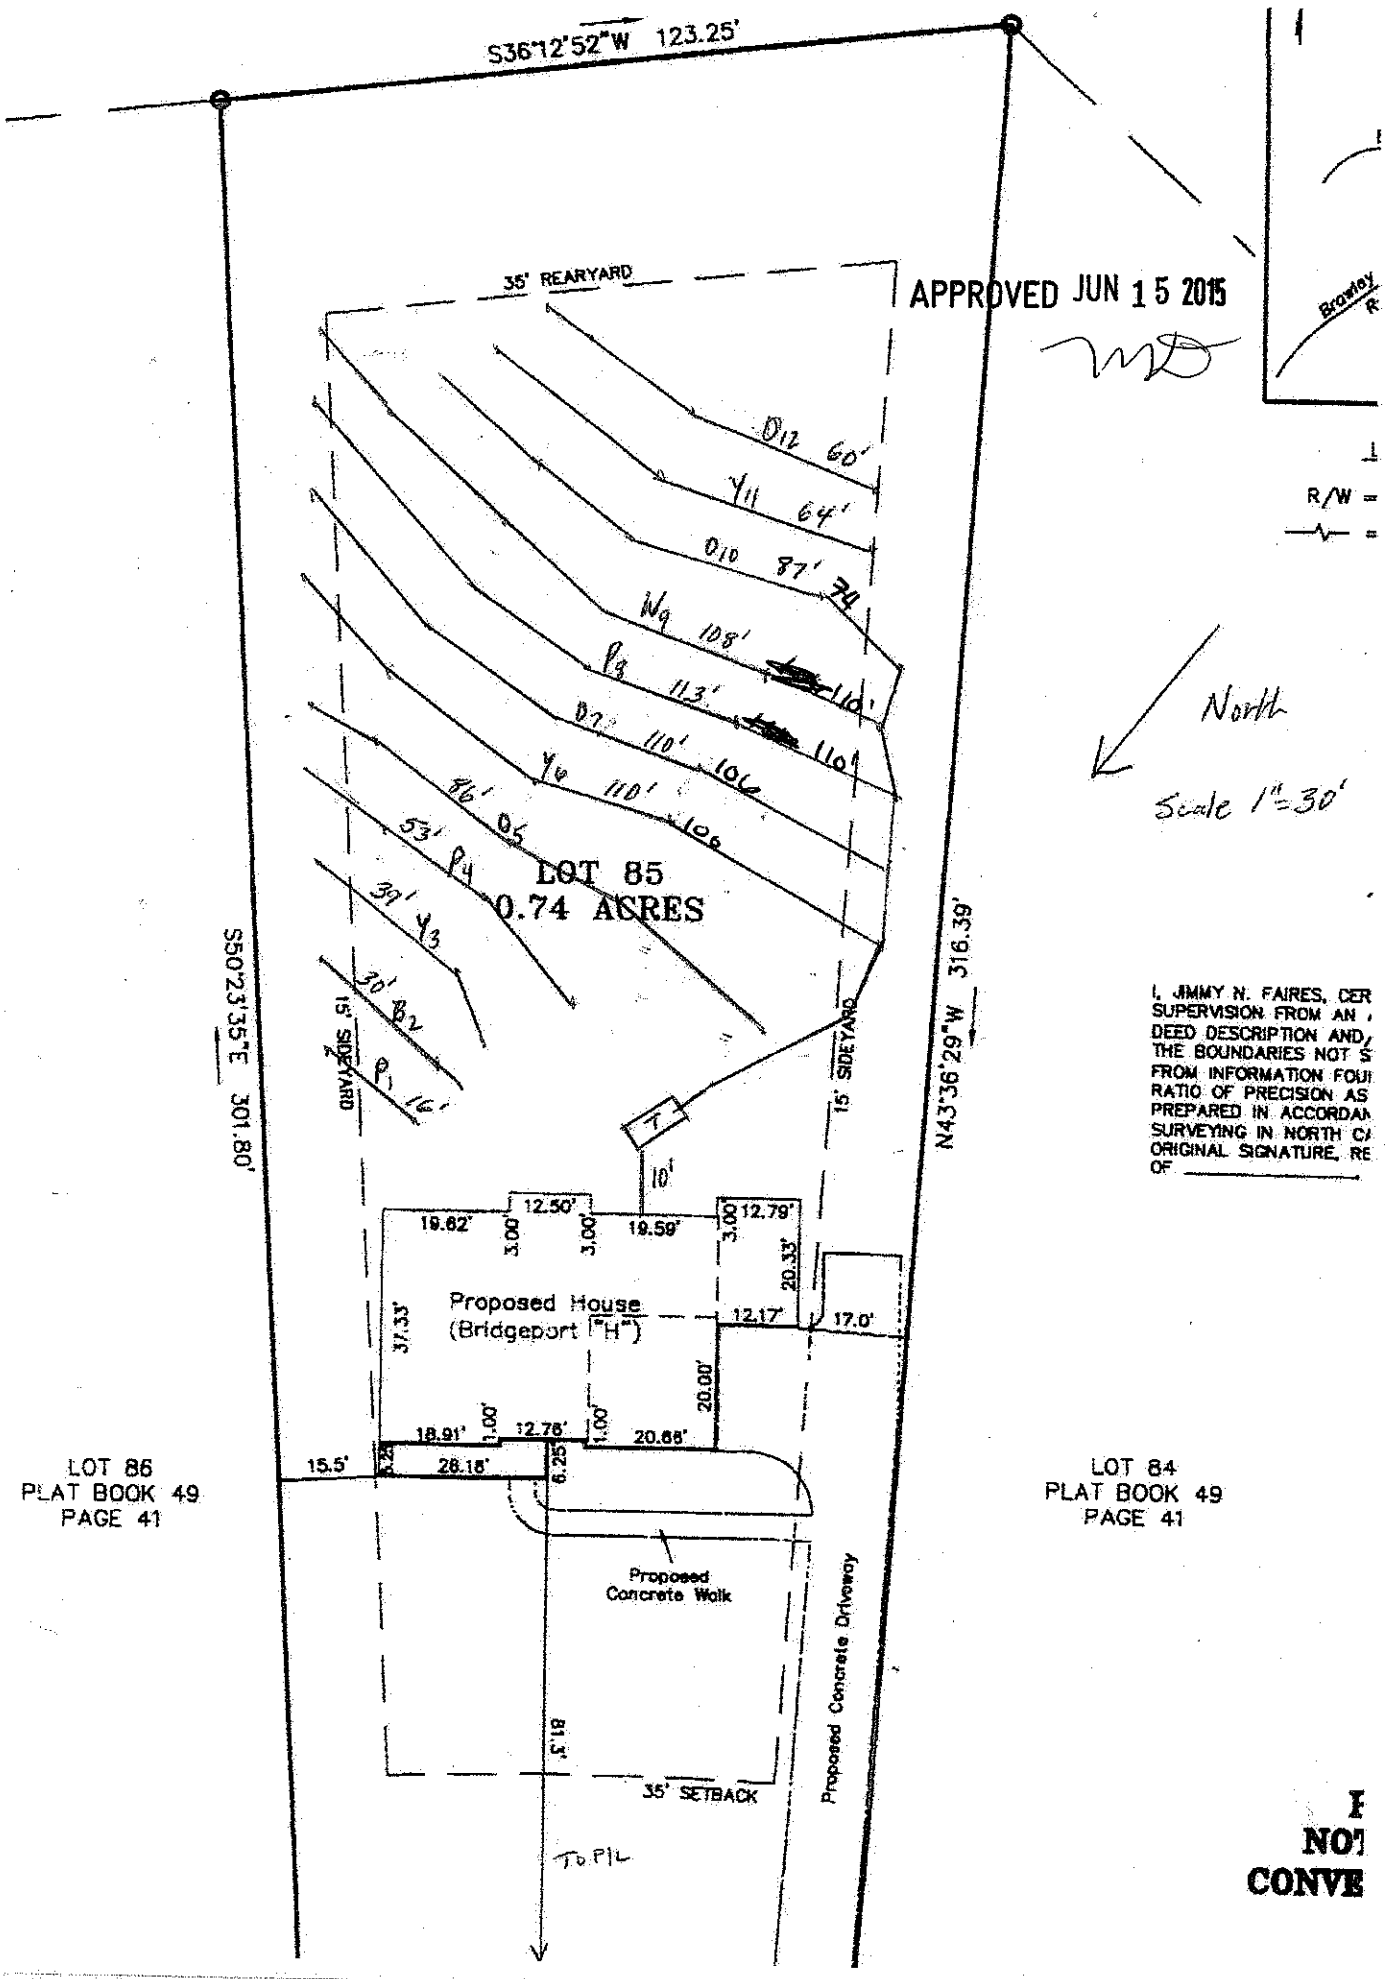
[ ] **IMPROVEMENT PERMIT** *with plat valid without expiration.* [X] **IMPROVEMENT PERMIT** *with site plan valid for 60 mos.* [ ] **AUTHORIZATION TO CONSTRUCT** *valid for period equal to IMPROVEMENT PERMIT--not to exceed 60 mo.*

Owner / Applicant Signature: Date: 6/19/15 Installed by: ABERNATHY

IMPROVEMENT PERMIT by: Date: 6/15/15 OPERATION PERMIT by: Date: 10-22-15

AUTHORIZATION TO CONSTRUCT by: Date: 6/15/15 Existing System Inspected by: Date:

Health Dept. Copy - WHITE Applicant (Final Approval) - YELLOW Applicant (Conditional Approval) - PINK


S36°12'52"W 123.25'
35' REARYARD
APPROVED JUN 15 2015
D12 60'
Y11 64'
D10 87'
W9 108'
P8 113'
D7 110'
Y6 110'
86' D5
53' P4
39' Y3
30' B2
P1 16'
LOT 85
0.74 ACRES
S50°23'35"E 301.80'
N43°36'29"W 316.39'
15' SIDEYARD
15' SIDEYARD
10'
12.50'
19.82'
3.00'
3.00'
19.59'
3.00'
12.79'
20.33'
37.33'
Proposed House
(Bridgeport "H")
12.17'
17.0'
20.00'
18.91'
1.00'
12.76'
1.00'
20.66'
15.5'
0.25'
28.18'
6.25'
Proposed Concrete Walk
Proposed Concrete Driveway
35' SETBACK
To P1L
North
Scale 1"=30'
R/W =
I, JIMMY N. FAIRES, CER
SUPERVISION FROM AN
DEED DESCRIPTION AND
THE BOUNDARIES NOT S
FROM INFORMATION FOU
RATIO OF PRECISION AS
PREPARED IN ACCORDAN
SURVEYING IN NORTH C
ORIGINAL SIGNATURE, RE
OF
LOT 86
PLAT BOOK 49
PAGE 41
LOT 84
PLAT BOOK 49
PAGE 41