IREDELL COUNTY HEALTH DEPARTMENT

Statesville Office (704) 878-5305 Mooresville Office (704) 660-3625

Old # 137634 PERMIT # 209264

IMPROVEMENT PERMIT / AUTHORIZATION TO CONSTRUCT / OPERATION PERMIT / EXISTING SYSTEM

PIN # 4636 12 0962

APPLICANT: CP TL LLC APPLICANT ADDRESS: 3125 Presidential Pkwy Ste 200 Atlanta, GA 30340

SITE ADDRESS: 322 Cove Creek Loop - Mooresville PHONE: 704 928-9215 ALT. PHONE:

SITE DIRECTIONS: Brawley School Rd TL Isle of Pines TR Cove Creek on left

SUBDIVISION: Chesapeake Pt SECTION: 2 LOT # 86 LOT AREA: .72Ac DESIGN FLOW: 480gpd L.T.A.R.: .25

Septic Tank	1000 (gal)	STB	794	Date	9-5-15	☒ New System	☐ Repair	☐ Expansion	System Type: I II III IV V VI	☒ Residence	No. Bedrooms 4
Pump Tank	1000 (gal)	PT	27	Date	9-16-15	System Description:	Pump-PM 25% Reduction			☐ Business	No. Persons 8
Pump Make	Myers	Model	ME45MC-50	Serial #		Repair System Description:	TLP PPBPS			☐ Other	No. Employees
# Nitrification Fields	1	# Lines	6	Linear Ft:	480'	Maintenance Agreement Required:	☐ YES	☒ NO		☐ Slab	☒ Crawl Space
Trench Width	36"	Max. Trench Bottom Depth	36"	Gravel Depth	N/A		☐ GRAVITY	☒ PRESSURE		☐ Basement w/plumbing	☐ Basement w/o plumbing

Water Supply: ☐ Private ☐ Public ☒ Community

Comments / Conditions:

Pressure Manifold detail: Use 1/2" Sch 80 tap for 65ft drainlines 1/2" Sch 40 tap for 85ft & 90ft lines.

INITIAL SITE SKETCH

See attached/approved plan by Michael Athanas & Assoc.

AS BUILT SKETCH

Checked Lines, Tanks, PM

RA

10-22-15

PM

1-21-16 - Leaky Tap Electrical OK



Tom Shuck

Permit can be suspended or revoked if any false information is supplied toward securing the permit / any unauthorized changes are made to the site / any unauthorized changes are made in the installation of the system. **CONTACT A LOCATOR SERVICE PRIOR TO ANY EXCAVATION**

☐ **IMPROVEMENT PERMIT** *with plat valid without expiration* ☐ **IMPROVEMENT PERMIT** *with site plan valid for 60 mos.* ☐ **AUTHORIZATION TO CONSTRUCT** *valid for period equal to IMPROVEMENT PERMIT--not to exceed 60 mo.*

Owner / Applicant Signature: Date: 6/9/15

IMPROVEMENT PERMIT by: Date: 6/16/15

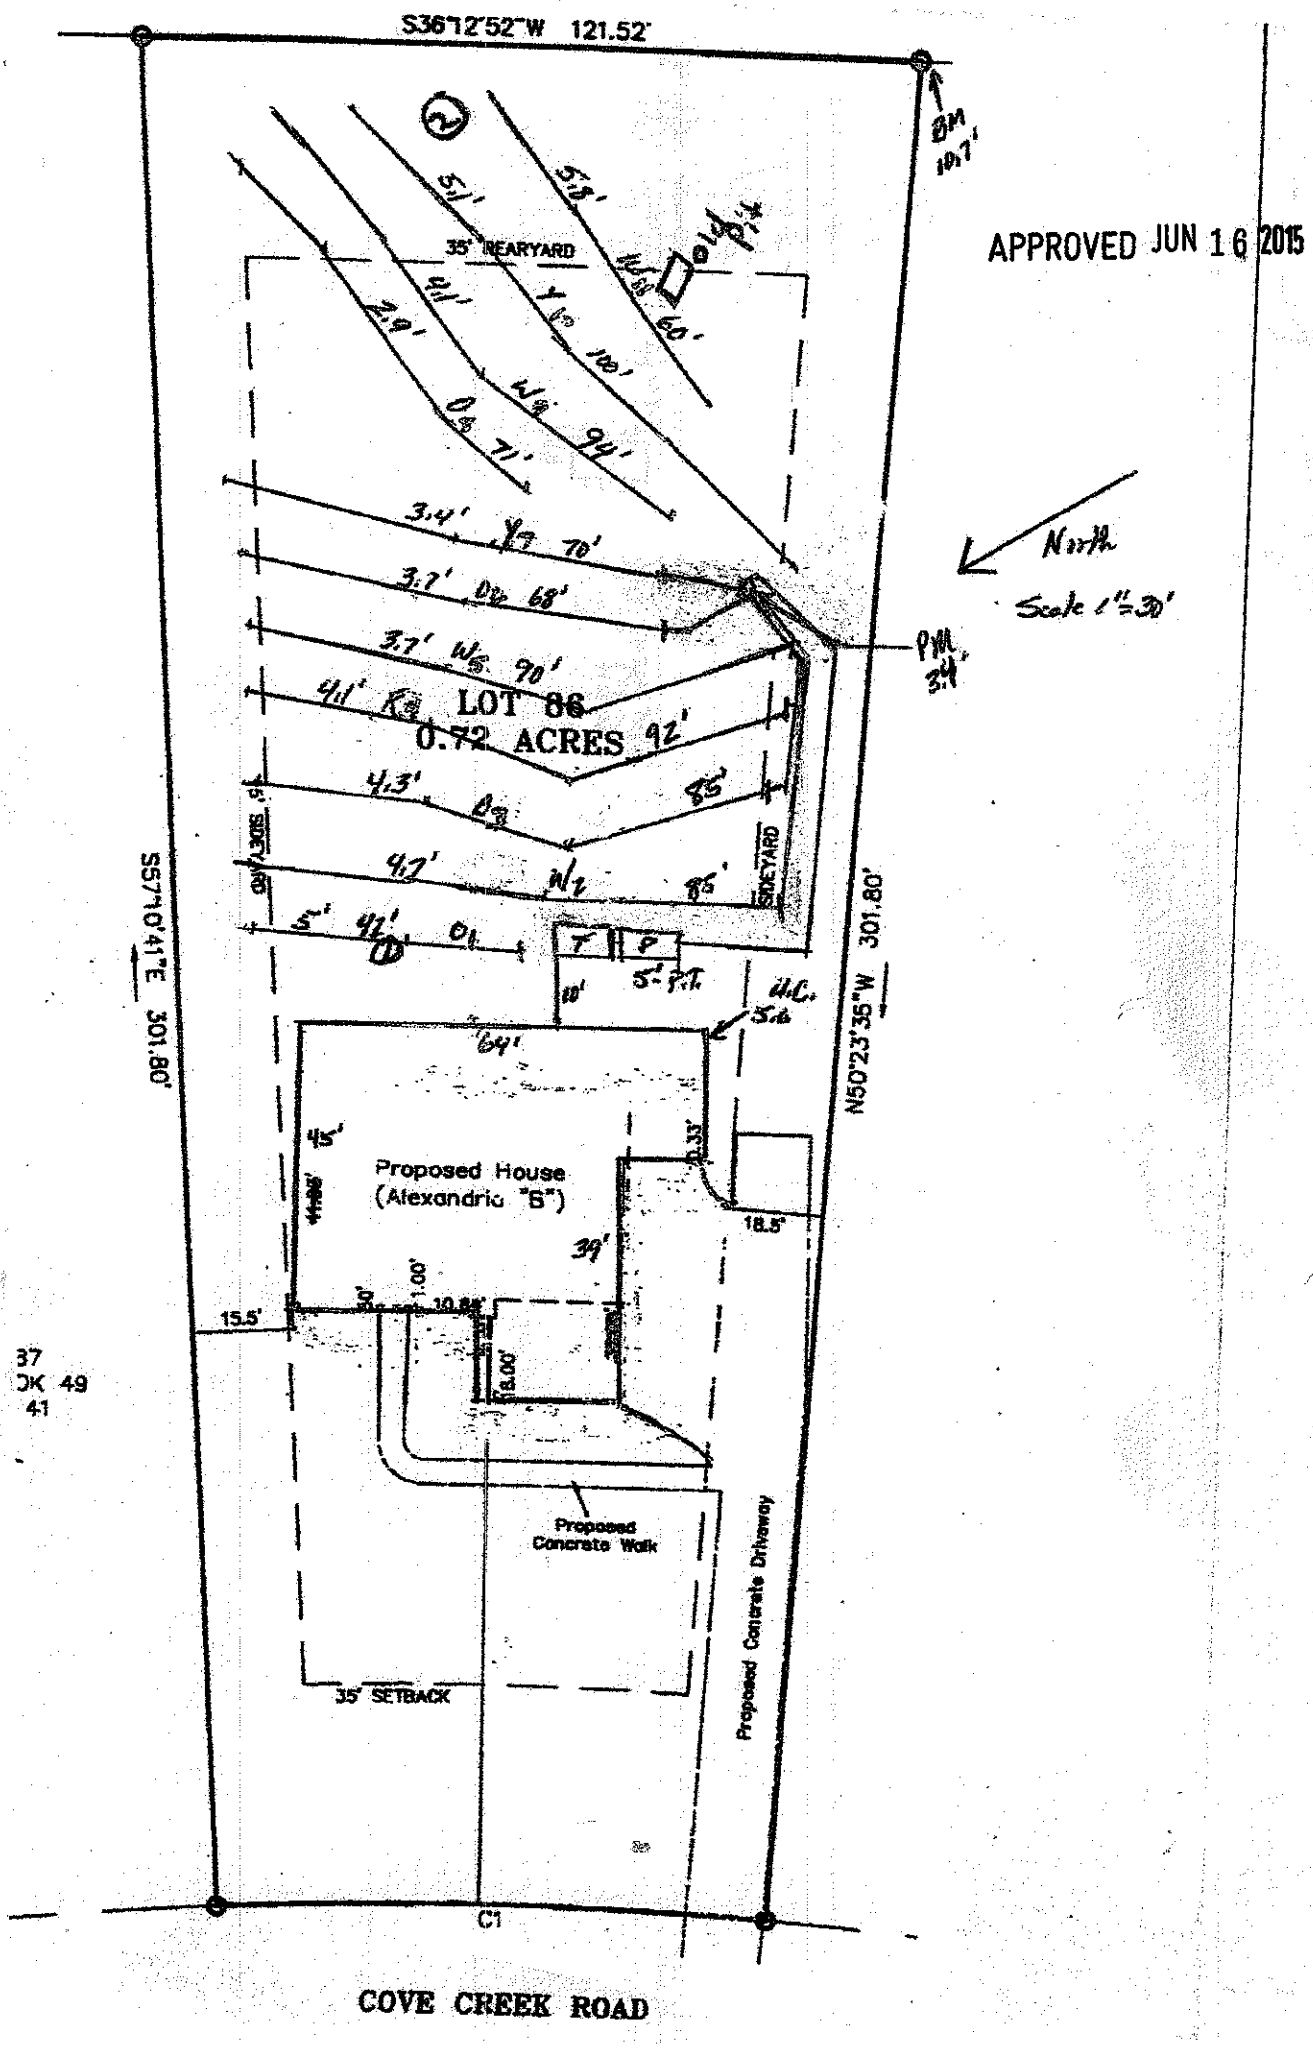
AUTHORIZATION TO CONSTRUCT by: Date: 6/16/15

Installed by: ABERNATHY

OPERATION PERMIT by: Date: 1/26/16

Existing System Inspected by: Date:

Health Dept. Copy - WHITE Applicant (Final Approval) - YELLOW Applicant (Conditional Approval) - PINK


S36°12'52"W 121.52'
APPROVED JUN 16 2015
35' REARYARD
LOT 86
0.72 ACRES
North
Scale 1"=30'
PM
3.4'
S57°04'41"E 301.80'
N50°23'35"W 301.80'
SIDEYARD
Proposed House
(Alexandria "S")
64'
45'
39'
18.5'
15.5'
10.86'
8.00'
Proposed Concrete Walk
Proposed Concrete Driveway
35' SETBACK
C1
37
DK 49
41
COVE CREEK ROAD