IREDELL COUNTY HEALTH DEPARTMENT

Statesville Office (704) 878-5305 Mooresville Office (704) 660-3625 PERMIT # 211787

IMPROVEMENT PERMIT / AUTHORIZATION TO CONSTRUCT / OPERATION PERMIT / EXISTING SYSTEM

PIN # 4631612106900

APPLICANT: John Wallen APPLICANT ADDRESS: 220 Cove Creek Lp. Mooresville, NC 28117

SITE ADDRESS: 220 Cove Creek Lp. PHONE: ALT. PHONE: 860 214 8119

SITE DIRECTIONS: Brawley School Rd TL Isle of Pines TR Cove Creek on left @ Sandy Cove Ct.

SUBDIVISION: Chesapeake Pt SECTION: III LOT # 63 LOT AREA: .82 Ac DESIGN FLOW: 480gpd L.T.A.R.: .25

EXISTING

Septic Tank 1000 (gal) STB Date
Pump Tank (gal) PT Date
Pump Make Model Serial #
Nitrification Fields 1 # Lines 5 Linear Ft: 480+
Trench Width 36" Max. Trench Bottom Depth 36" Gravel Depth N/A

☐ New System ☐ Repair ☐ Expansion System Type: I II III IV V VI
System Description: Gravity - 25% Reduction
Repair System Description: 1 P PPBPS
Maintenance Agreement Required: ☐ YES ☒ NO
☒ GRAVITY ☐ PRESSURE


☒ Residence No. Bedrooms 4
☐ Business No. Persons 8
☐ Other No. Employees
☐ Slab ☒ Crawl Space
☐ Basement w/plumbing ☐ Basement w/o plumbing

Water Supply: ☐ Private ☐ Public ☒ Community

Comments / Conditions: The proposed 14'X10' Shed does not appear to impact the existing Septic System


* Must keep Shed (or any building) at least 5FT from Septic System

INITIAL SITE SKETCH

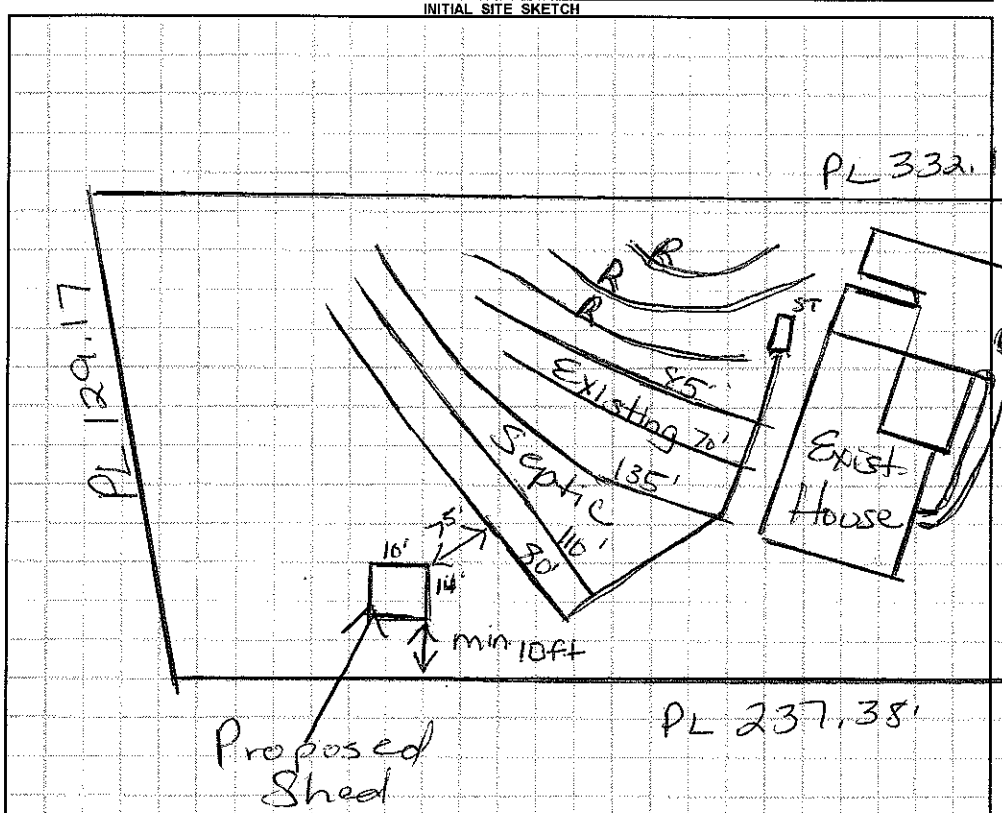

AS BUILT SKETCH

Scale 1:50

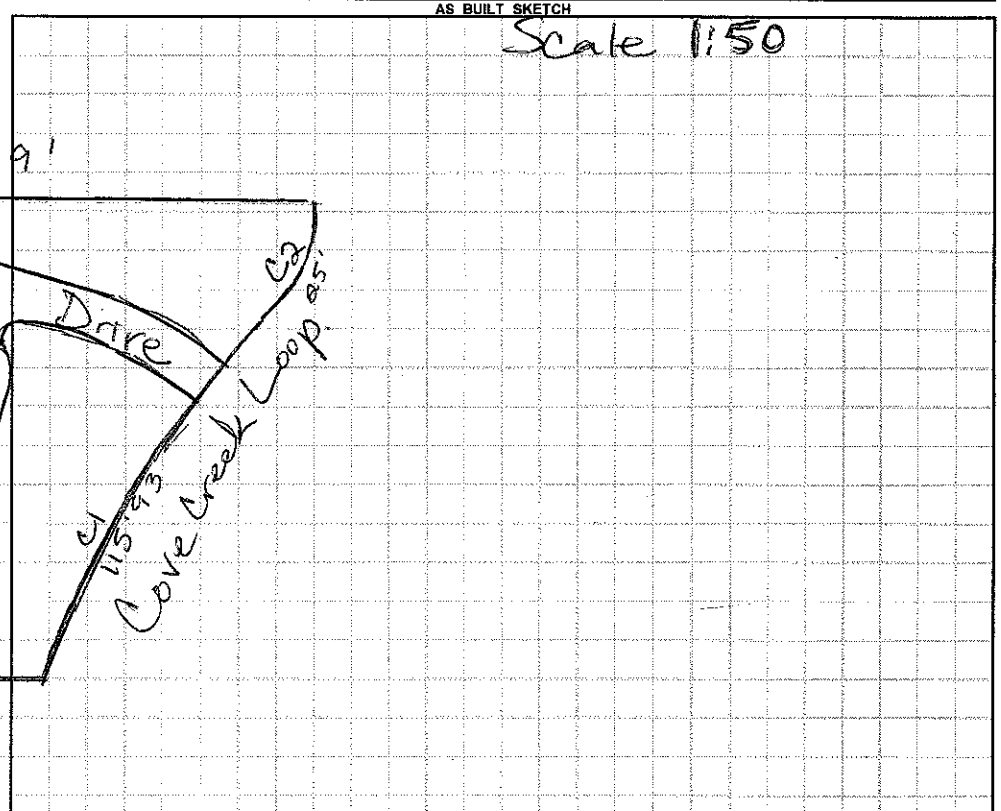

Permit can be suspended or revoked if any false information is supplied toward securing the permit / any unauthorized changes are made to the site / any unauthorized changes are made in the installation of the system. **CONTACT A LOCATOR SERVICE PRIOR TO ANY EXCAVATION**

☐ **IMPROVEMENT PERMIT** *with plat valid without expiration.* ☐ **IMPROVEMENT PERMIT** *with site plan valid for 60 mos.* ☐ **AUTHORIZATION TO CONSTRUCT** *valid for period equal to IMPROVEMENT PERMIT--not to exceed 60 mo.*

Owner / Applicant Signature: JTCh Date: 10/27/15 Installed by:

IMPROVEMENT PERMIT by: Date: OPERATION PERMIT by: Date:

AUTHORIZATION TO CONSTRUCT by: Date: Existing System Inspected by: Maria Dotson RS Date: 9/17/15

Health Dept. Copy - WHITE Applicant (Final Approval) - YELLOW Applicant (Conditional Approval) - PINK