IREDELL COUNTY HEALTH DEPARTMENT

Statesville Office (704) 878-5305 Mooresville Office (704) 660-3625 BA PERMIT # 209081

IMPROVEMENT PERMIT / AUTHORIZATION TO CONSTRUCT / OPERATION PERMIT / EXISTING SYSTEM

PIN # 4636-12-4370

APPLICANT: Douglas P. Phillips APPLICANT ADDRESS: 113 Sandy Cove Ct Mooresville NC

SITE ADDRESS: 113 Sandy Cove Ct PHONE: 704-534-2477 ALT. PHONE:

SITE DIRECTIONS: Brawley Sch Rd, TL on Isle of Pines, TR on Cove Creek, TL on Sandy Cove, Lot on L at End

SUBDIVISION: Chesapeake Pointe SECTION: 3 LOT # 60 LOT AREA: 0.71 ac DESIGN FLOW: 480 gal L.T.A.R.:

Septic Tank 1000 Exist (gal) STB Date

Pump Tank 1000 Exist (gal) PT Date

Pump Make Model Serial #

Nitrification Fields 1 # Lines 3 Linear Ft: 402

Trench Width EXISTING Max. Trench Bottom Depth EXISTING Gravel Depth N/A

☐ New System ☐ Repair ☐ Expansion System Type: I II III IV V VI

System Description: PM 25% Red. EXISTING

Repair System Description: LP PPBPS

Maintenance Agreement Required: ☐ YES ☑ NO ☐ GRAVITY ☑ PRESSURE

☑ Residence No. Bedrooms

☐ Business No. Persons

☑ Other No. Employees

☐ Slab ☐ Crawl Space


☐ Basement w/plumbing ☐ Basement w/o plumbing

Water Supply: ☐ Private ☐ Public ☑ Community

Comments / Conditions: SCREENED IN PORCH

INITIAL SITE SKETCH

AS BUILT SKETCH

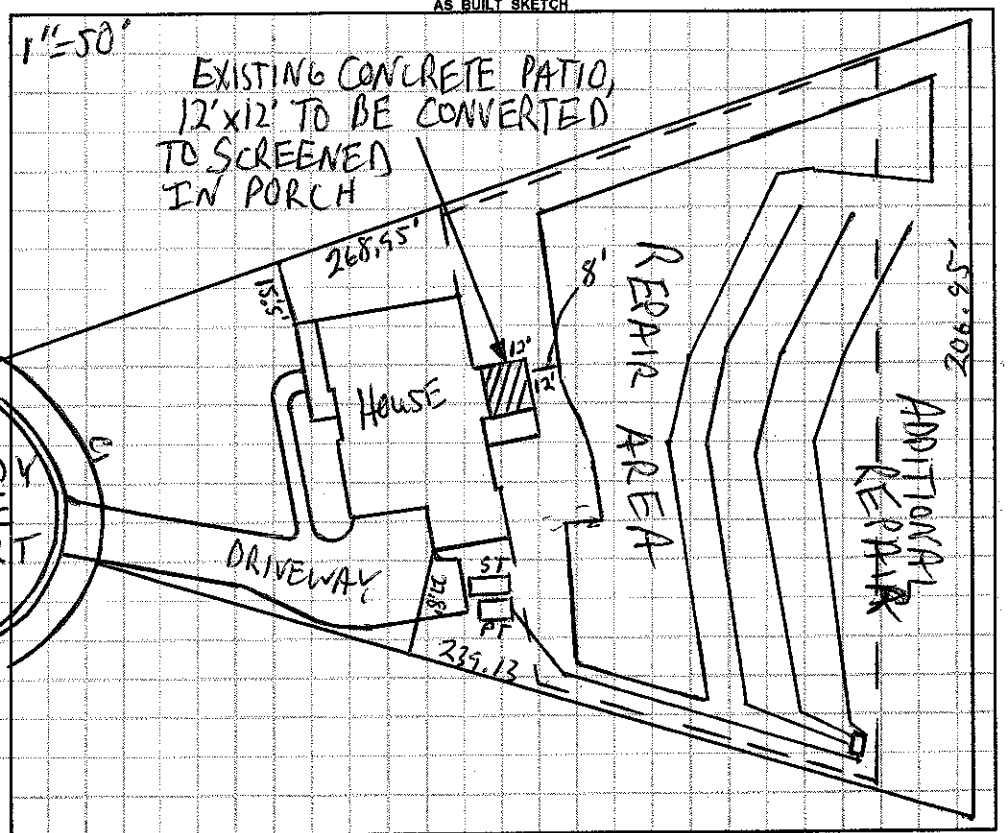

Permit can be suspended or revoked if any false information is supplied toward securing the permit / any unauthorized changes are made to the site / any unauthorized changes are made in the installation of the system. **CONTACT A LOCATOR SERVICE PRIOR TO ANY EXCAVATION**

☐ **IMPROVEMENT PERMIT** *with plat valid without expiration.* ☐ **IMPROVEMENT PERMIT** *with site plan valid for 60 mos.* ☐ **AUTHORIZATION TO CONSTRUCT** *valid for period equal to IMPROVEMENT PERMIT--not to exceed 60 mo.*

Owner / Applicant Signature: D. P. Phillips Date: 10 APR 2015 Installed by:

IMPROVEMENT PERMIT by: Date: OPERATION PERMIT by: Date:

AUTHORIZATION TO CONSTRUCT by: Date: Existing System Inspected by: Date: 4-9-15

Health Dept. Copy - WHITE Applicant (Final Approval) - YELLOW Applicant (Conditional Approval) - PINK