MD Old # 133769

IREDELL COUNTY HEALTH DEPARTMENT

Statesville Office (704) 878-5305 Mooresville Office (704) 660-3625 PERMIT # 208731

IMPROVEMENT PERMIT / AUTHORIZATION TO CONSTRUCT / OPERATION PERMIT / EXISTING SYSTEM ✓ PIN # 4636-12-4545

APPLICANT: True Homes APPLICANT ADDRESS: 2649 Brekonridge Centra Dr.

SITE ADDRESS: 103 Farm Knoll Way - Mooresville PHONE: 704-283-1229 ALT. PHONE:

SITE DIRECTIONS: BSR, TL Isle of Pines, TR Rock Ridge Point, TL Farm Knoll Way

SUBDIVISION: Rock Ridge Point SECTION: - LOT # 21 LOT AREA: 1.02 AC DESIGN FLOW: 600 L.T.A.R.: .25

Septic Tank	1500 (gal)	STB 444	Date 1-16-16	☑ New System	☐ Repair	☐ Expansion	System Type: I II III ⓘ V VI	☑ Residence	No. Bedrooms 5	Water Supply
Pump Tank	1500 (gal)	PT 4777	Date 1-11-16	System Description:		LP Panel Block		☐ Business	No. Persons	☐ Private
Pump Make		Model	Serial #	Repair System Description:		Same		☐ Other	No. Employees	☐ Public
# Nitrification Fields	1	# Lines 4	Linear Ft: 400'	Maintenance Agreement Required:	☑ YES	☐ NO		☐ Slab	☑ Crawl Space	☒ Community
Trench Width	24"	Max. Trench Bottom Depth 36"	Gravel Depth —		☐ GRAVITY	☑ PRESSURE		☐ Basement w/plumbing	☐ Basement w/o plumbing	

Comments / Conditions:

3/28/16 Set pressure, Checked Electa Alarm

INITIAL SITE SKETCH

See Plan From Kenny Owens

	Date	Initials
Drain Lines Checked	3-3-16	
Tanks Checked	3-3-16	
Pressure Manifold or Valve Box Checked	3/28/16	MD
Pressure Head Set		
Electrical Checked		
Floats Set		
Alarm Checked	3/28/16	MD
Maintenance Contract Y / N		

AS BUILT SKETCH

3-3-16 : Dillinger Precast top seam septic + pump tanks (1500 gal) w/ a Polylok PL-68 Filter


Measurements/As-Built on back of Final Page (soil notes)

Lat 1 = 4' 4" → 4' 3" WW

Lat 2 = 4" ½" WW

Lat 3 = 5' 10" WWW

Lat 4 = 6' 9"

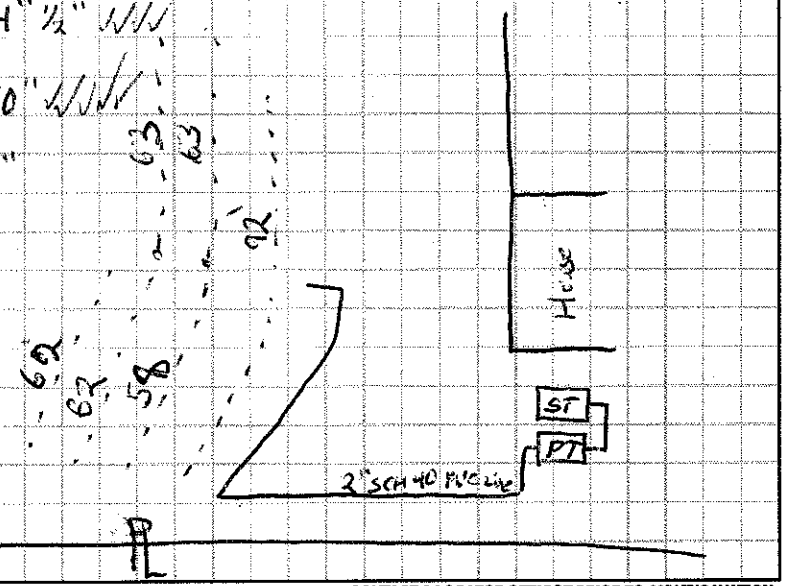

Permit can be suspended or revoked if any false information is supplied toward securing the permit / any unauthorized changes are made to the site / any unauthorized changes are made in the installation of the system. **CONTACT A LOCATOR SERVICE PRIOR TO ANY EXCEDVATION**

☐ **IMPROVEMENT PERMIT** *with plat valid without expiration* ☐ **IMPROVEMENT PERMIT** *with site plan valid for 60 mos.* ☑ **AUTHORIZATION TO CONSTRUCT** *valid for period equal to IMPROVEMENT PERMIT--not to exceed 60 mo.*

Owner / Applicant Signature: [signature] Date: 11/23/15

IMPROVEMENT PERMIT by: [signature] RS APPROVED Date: NOV 23 2015

AUTHORIZATION TO CONSTRUCT by: [signature] RS APPROVED Date: NOV 23 2015

Installed by: SID Gaskins Emike Powell

OPERATION PERMIT by: Maria Dotson RS Date: 3/28/16

Existing System Inspected by: Date:

Health Dept. Copy - WHITE Applicant (Final Approval) - YELLOW Applicant (Conditional Approval) - PINK

ROCKRIDGE POINT SUBDIVISION

