IREDELL COUNTY HEALTH DEPARTMENT

Statesville Office (704) 878-5305 Mooresville Office (704) 660-3625 PERMIT # 208794

IMPROVEMENT PERMIT / AUTHORIZATION TO CONSTRUCT / OPERATION PERMIT / EXISTING SYSTEM

PIN # 4636-12-4551.000

APPLICANT: True Homes APPLICANT ADDRESS: 2649 Beaton Ridge Centre Dr.

SITE ADDRESS: 101 Farm Knoll Way Mooresville NC PHONE: 704-283-1229 ALT. PHONE:

SITE DIRECTIONS: I-77 N, TL ISLE of Pines, TR Rock Ridge, TL Farm Knoll Way

SUBDIVISION: Rock Ridge Point SECTION: LOT # 20 LOT AREA: 1.17 Acre DESIGN FLOW: 480 GPD L.T.A.R.: .25

Septic Tank 1500 (gal) STB Date 1-27-15
Pump Tank (gal) PT Date
Pump Make Model 300/600 Serial #
Nitrification Fields 1 # Lines 4 @ 120' Linear Ft: 480'
Trench Width 36" Max. Trench Bottom Depth 36" Gravel Depth N/A

☒ New System ☐ Repair ☐ Expansion System Type: I II ☒ III IV V VI
System Description: 25% Reduction - Gravity
Repair System Description: Same
Maintenance Agreement Required: ☐ YES ☒ NO
☒ GRAVITY ☐ PRESSURE

☒ Residence No. Bedrooms 4
☐ Business No. Persons 8
☐ Other No. Employees
☐ Slab ☒ Crawl Space
☐ Basement w/plumbing ☐ Basement w/o plumbing

Water Supply: ☐ Private ☐ Public ☒ Community

Comments / Conditions: 3 Have Any Burns In Septic Area.
Use Approved Fill If Needed.
1500 Gal. Tank For Design.

Installed Quick 4 installed in 3 lines

INITIAL SITE SKETCH

See Attached / Approved Design By Septic Environmental Solutions

Dated APPROVED MAY 07 2015

AS BUILT SKETCH

Permit can be suspended or revoked if any false information is supplied toward securing the permit / any unauthorized changes are made to the site / any unauthorized changes are made in the installation of the system. **CONTACT A LOCATOR SERVICE PRIOR TO ANY EXCAVATION**

☐ **IMPROVEMENT PERMIT** *with plat valid without expiration.* ☒ **IMPROVEMENT PERMIT** *with site plan valid for 60 mos.* ☒ **AUTHORIZATION TO CONSTRUCT** *valid for period equal to IMPROVEMENT PERMIT--not to exceed 60 mo.*


Owner / Applicant Signature: Date: 5/11/15 Installed by: Sid Gaskins

IMPROVEMENT PERMIT by: APPROVED MAY 07 2015 OPERATION PERMIT by: Maria Dotson Date: 8/31/15

AUTHORIZATION TO CONSTRUCT by: APPROVED JUN 01 2015 Existing System Inspected by: Date:

Health Dept. Copy - WHITE Applicant (Final Approval) - YELLOW Applicant (Conditional Approval) - PINK

ROCKRIDGE POINT SUBDIVISION

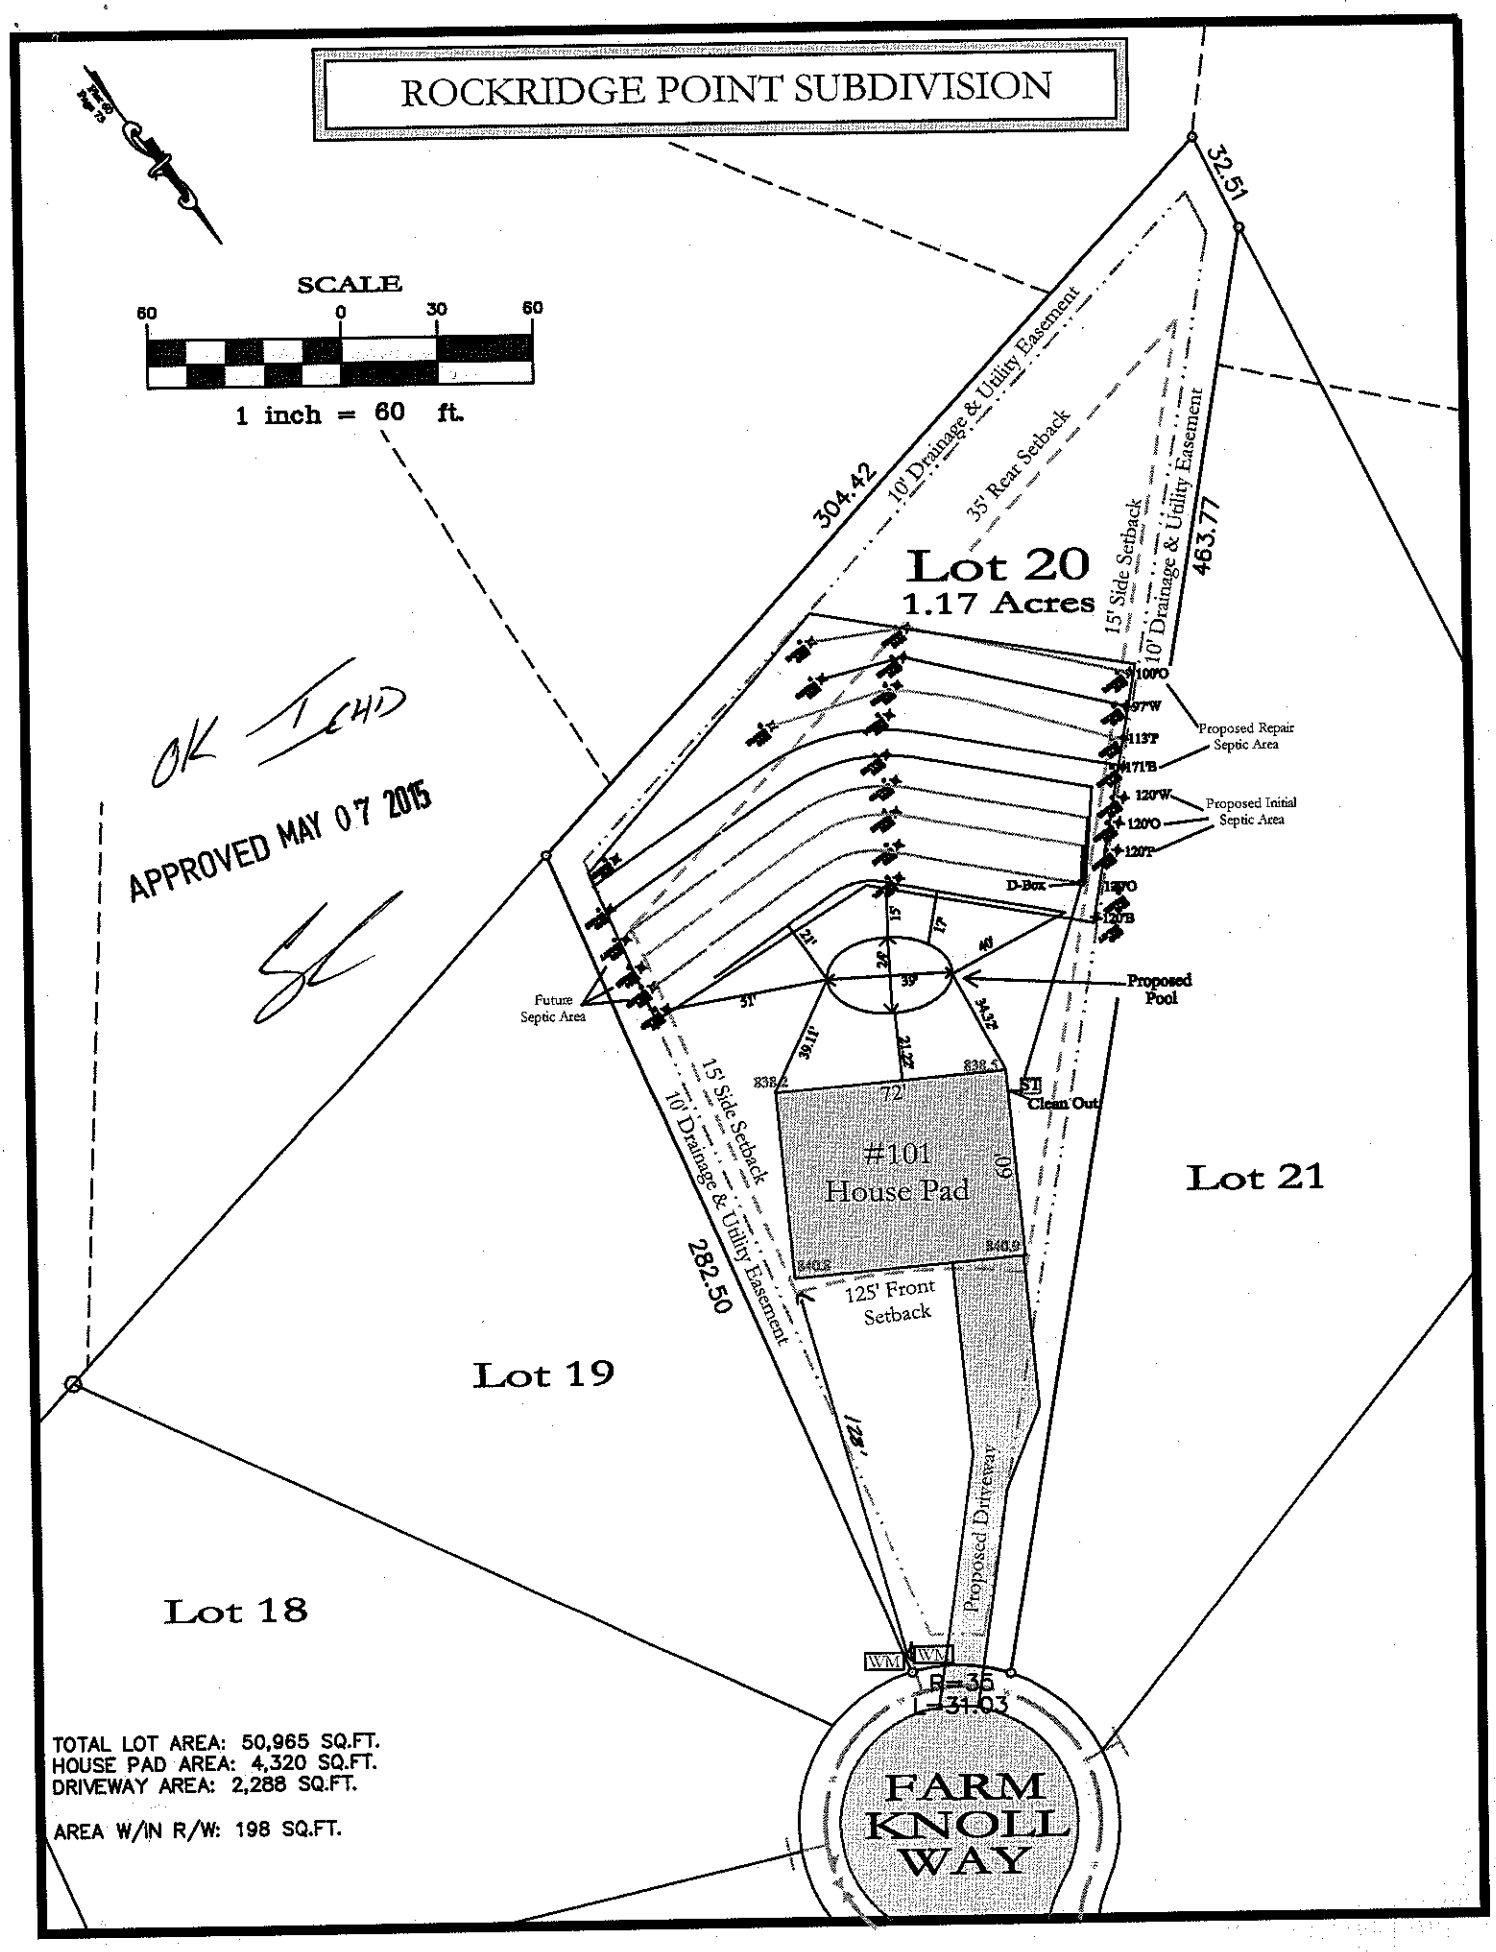

TOTAL LOT AREA: 50,965 SQ.FT.
HOUSE PAD AREA: 4,320 SQ.FT.
DRIVEWAY AREA: 2,288 SQ.FT.

AREA W/IN R/W: 198 SQ.FT.