IREDELL COUNTY HEALTH DEPARTMENT

Statesville Office (704) 878-5305 | Mooresville Office (704) 660-3625 (DSE) | PERMIT # 208456 ✓

IMPROVEMENT PERMIT / AUTHORIZATION TO CONSTRUCT / OPERATION PERMIT / EXISTING SYSTEM

PIN # 4636-12-4785

APPLICANT: True Homes | APPLICANT ADDRESS: 2649 Brekon Ridge Center

SITE ADDRESS: 105 Farm Knoll Way | PHONE: 704-288-1229 | ALT. PHONE:

SITE DIRECTIONS: BSR, TR Isle of Pines, TR into Rocky Ridge

SUBDIVISION: Rocky Ridge Point | SECTION: | LOT # 22 | LOT AREA: .85 AC | DESIGN FLOW: 480 | L.T.A.R.: .3 (.25R)

Septic Tank	1500 (gal)	STB 338	Date 5/4/15	☒ New System	☐ Repair	☐ Expansion	System Types I II (III)B IV V VI	☒ Residence	No. Bedrooms 4	Water Supply	
Pump Tank	500 (gal)	PT	Date	System Description: Gravity 25% Reduction				☐ Business	No. Persons	☐ Private	
Pump Make		Model	Serial #	Repair System Description: LP Panel Block				☐ Other	No. Employees	☐ Public	
# Nitrification Fields	1	# Lines 6@70'	Linear Ft: 420'	Maintenance Agreement Required:	☐ YES	☒ NO		☐ Slab	☒ Crawl Space	☒ Community	
Trench Width	36"	Max. Trench Bottom Depth	36"	Gravel Depth	☒ GRAVITY		☐ PRESSURE	☐ Basement w/plumbing	☐ Basement w/o plumbing		

Comments / Conditions:

Changed from Pressure to Gravity as allowed by plumbing and tank location. SL


INITIAL SITE SKETCH

See Plan From Septic Environmental Solutions

AS BUILT SKETCH

Installed TOP 3 lines ~~as staked~~ Checked OK 6/1/15 &

Installed Quick 4 Chambers slightly off contour Bed 24"-36" Trench Bottom.

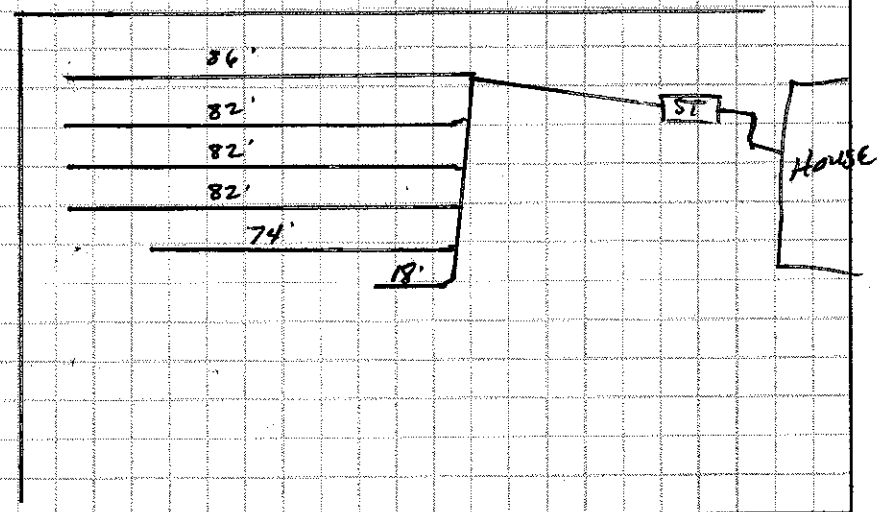

Permit can be suspended or revoked if any false information is supplied toward securing the permit / any unauthorized changes are made to the site / any unauthorized changes are made in the installation of the system. **CONTACT A LOCATOR SERVICE PRIOR TO ANY EXCAVATION**


☐ **IMPROVEMENT PERMIT** *with plat valid without expiration.* ☐ **IMPROVEMENT PERMIT** *with site plan valid for 60 mos.* ☒ **AUTHORIZATION TO CONSTRUCT** *valid for period equal to IMPROVEMENT PERMIT--not to exceed 60 mo.*

Owner / Applicant Signature: [signature] Date: 3-16-15 Installed by: Water Solutions (Sid Gaskins)


IMPROVEMENT PERMIT by: [signature] Date: APPROVED MAR 13 2015 OPERATION PERMIT by: [signature] Date: APPROVED JUN 05 2015

AUTHORIZATION TO CONSTRUCT by: [signature] Date: APPROVED MAR 13 2015 Existing System Inspected by: Date:

Health Dept. Copy - WHITE Applicant (Final Approval) - YELLOW Applicant (Conditional Approval) - PINK

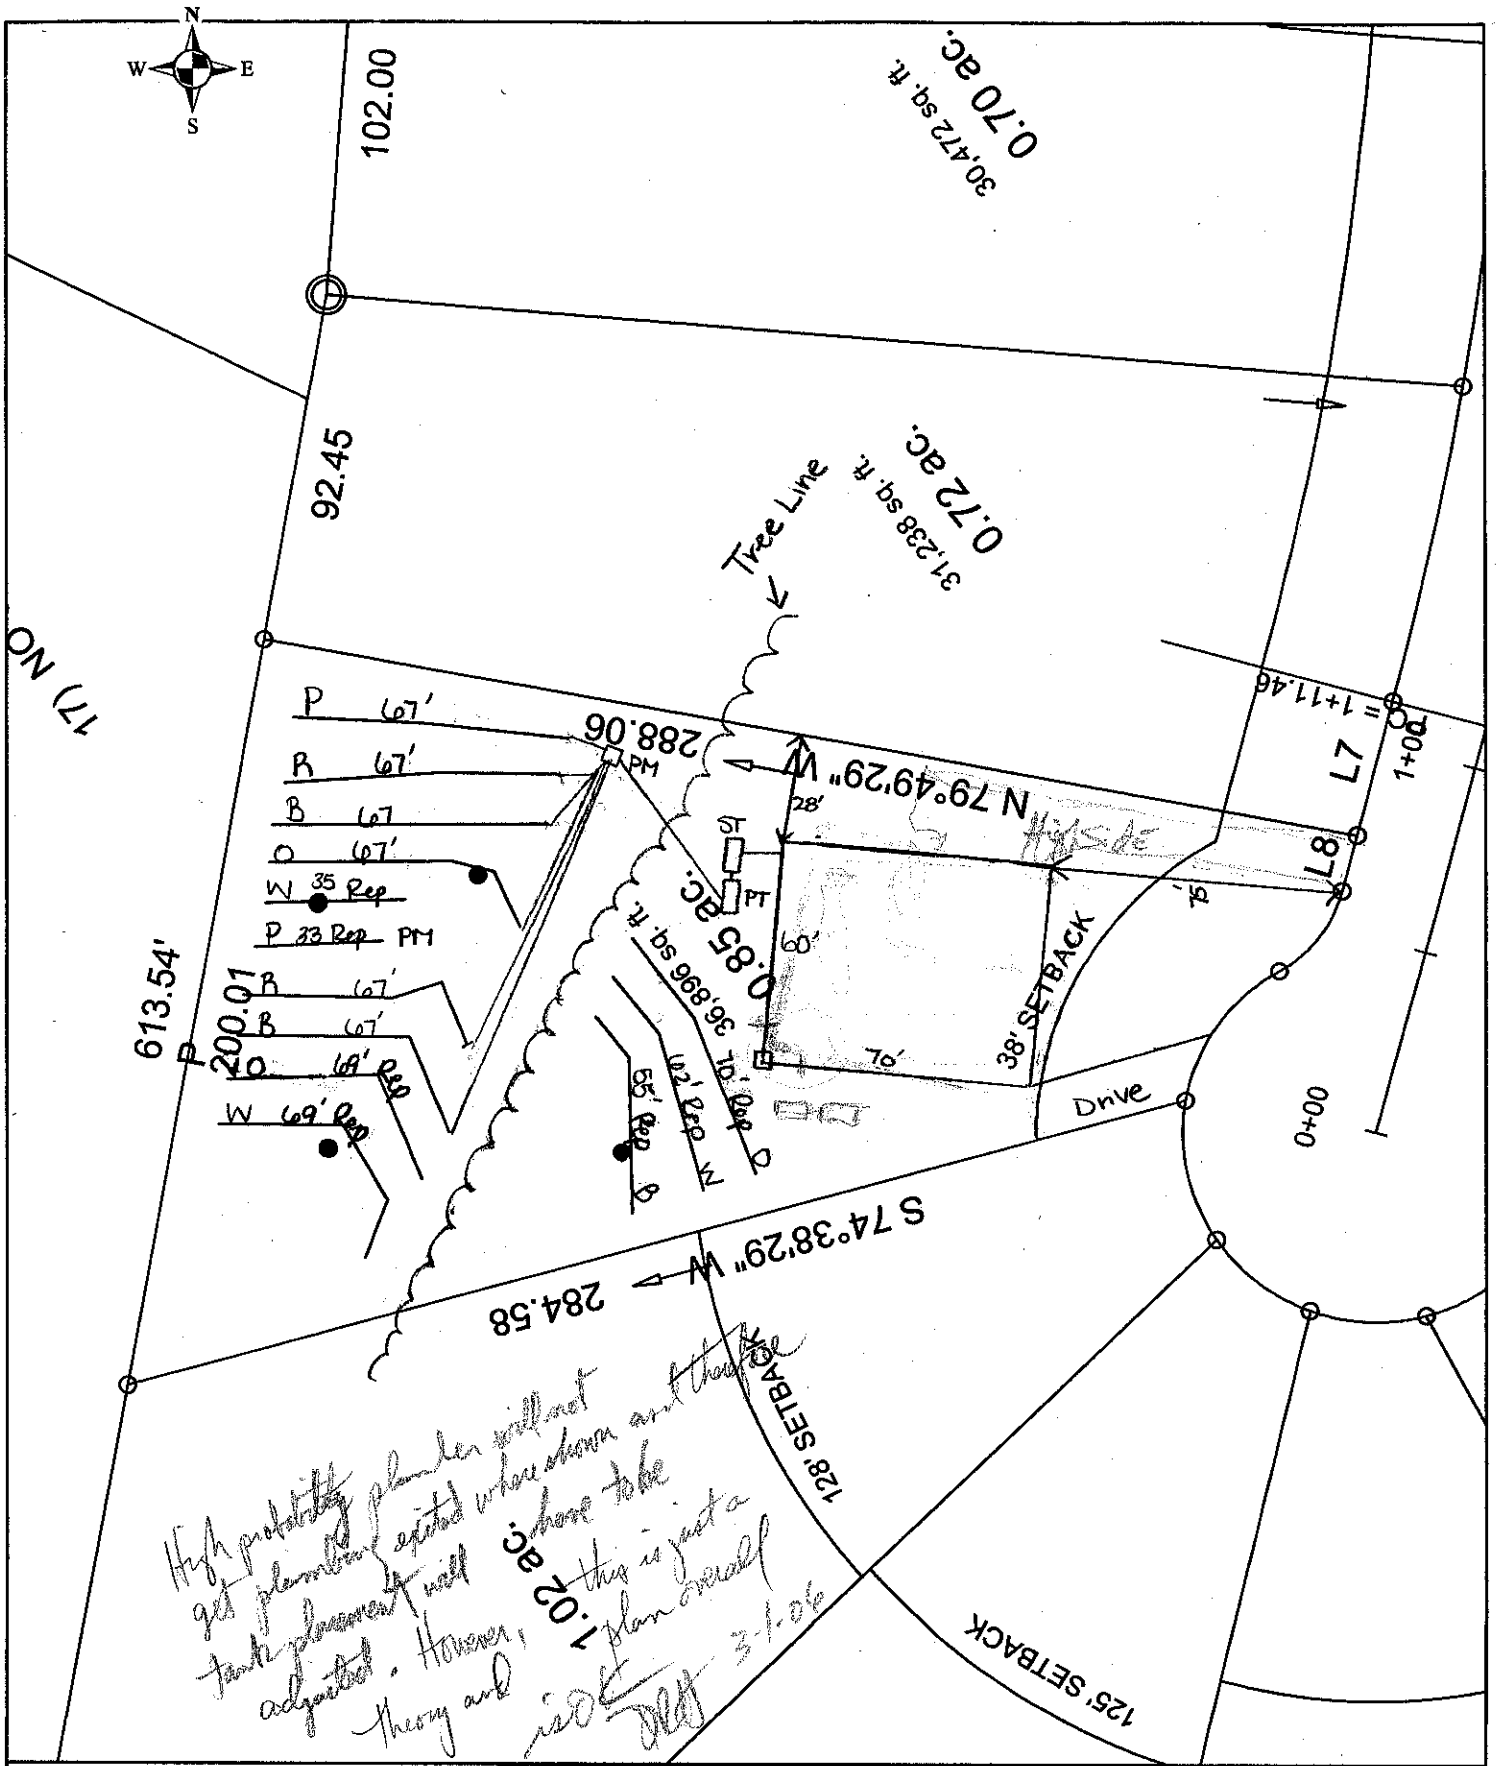

Scale: 1 inch equals 50 feet	S&ME	Rocky Ridge - Lot 22	FIGURE
Drawn by: JBP		Scaled Detailed Site Plan	1
Reviewed by: PGP		Iredell County, NC	
Date: February, 2006	ENVIRONMENTAL SERVICES • ENGINEERING • TESTING	S&ME Project #1588-05-081	

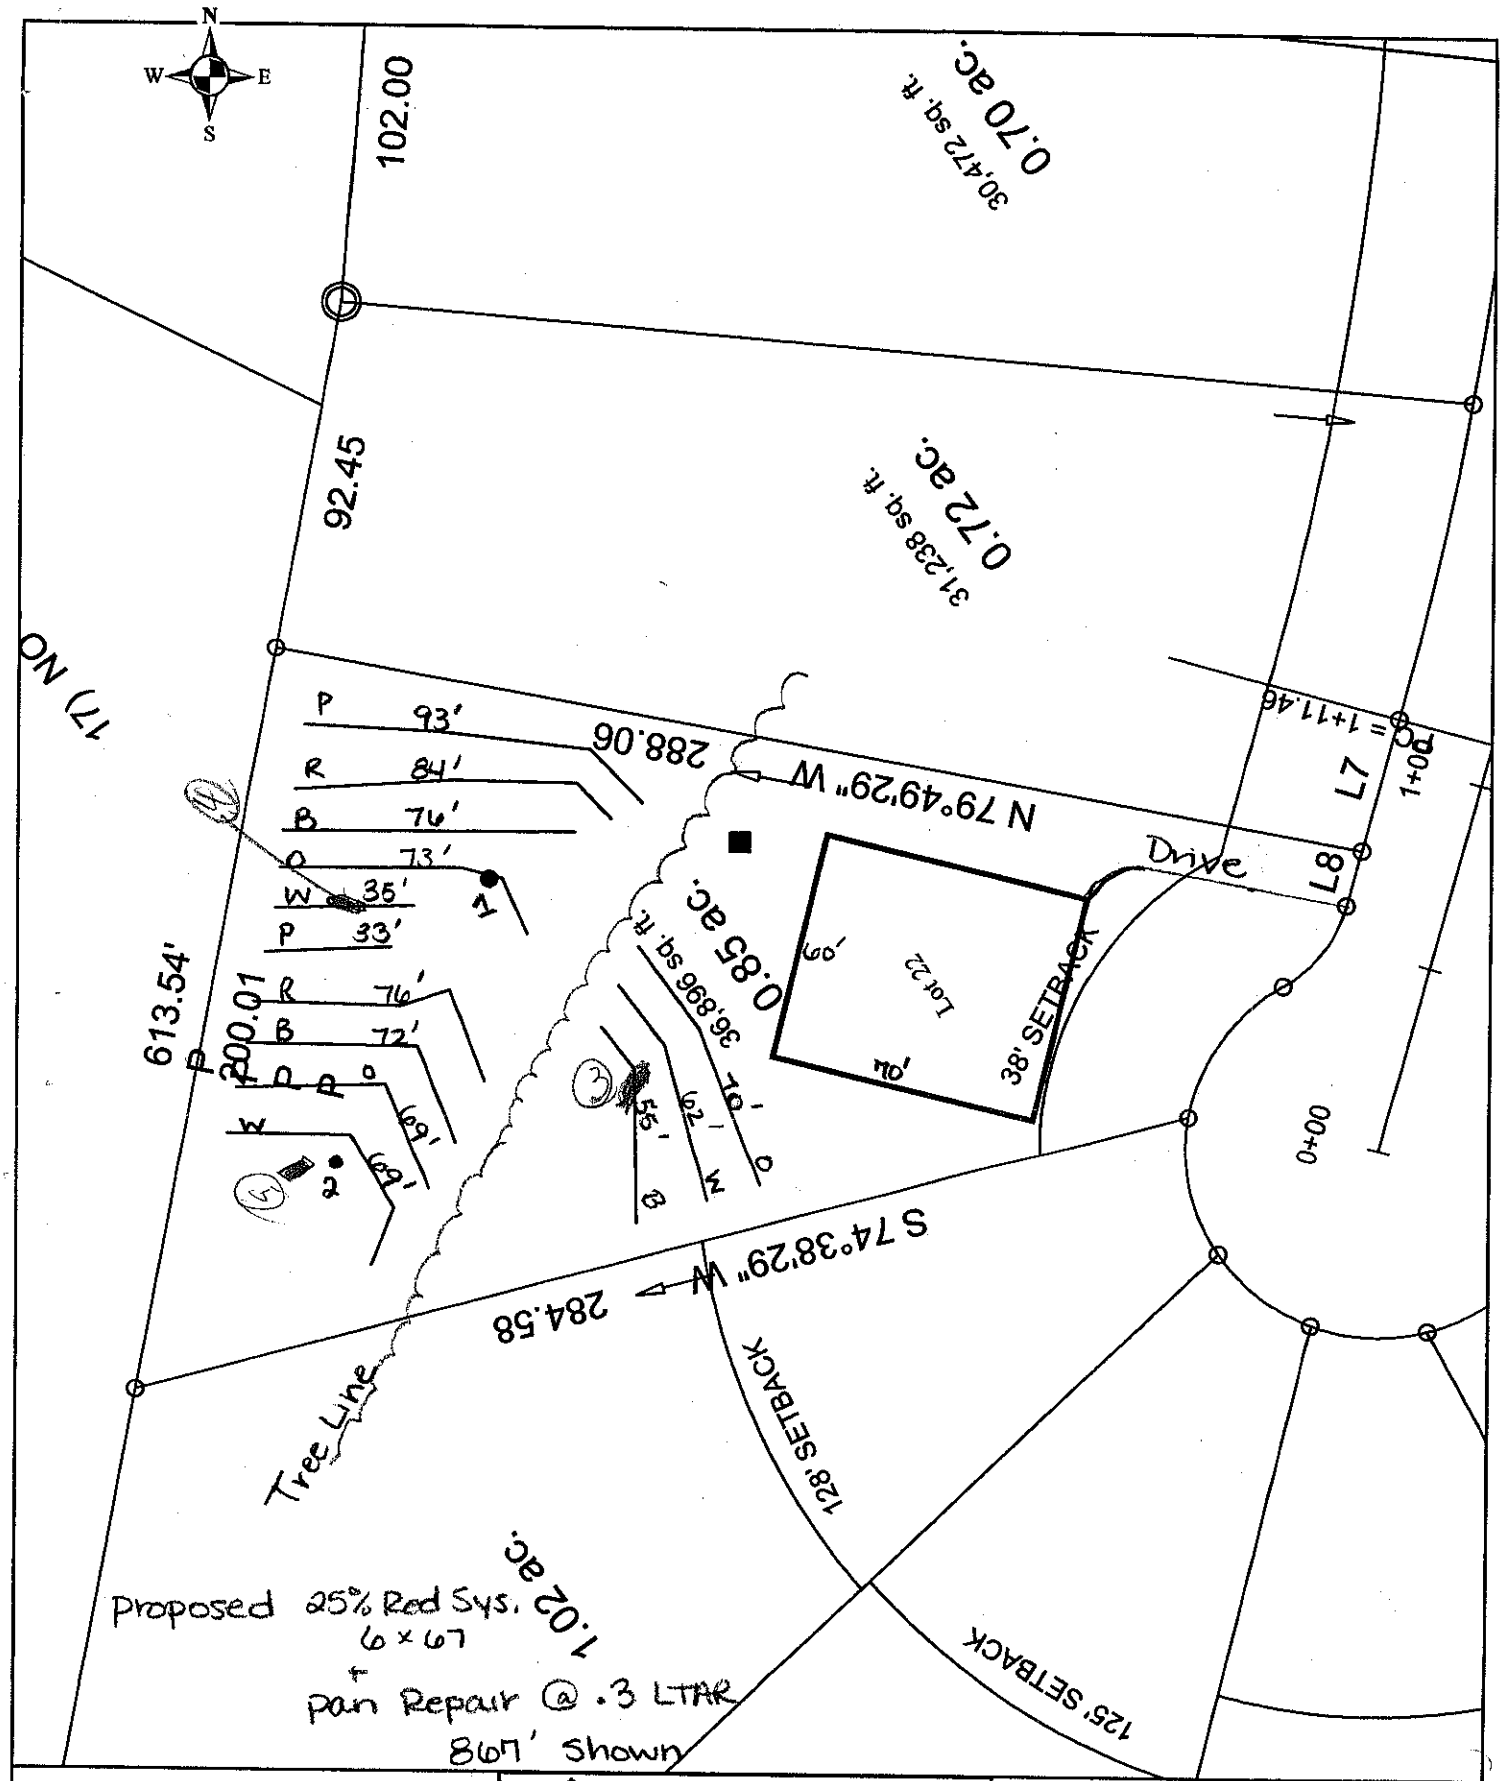

Scale: 1 inch equals 50 feet	S&ME ENVIRONMENTAL SERVICES • ENGINEERING • TESTING	Rocky Ridge - Lot 22	FIGURE 1
Drawn by: JBP		Scaled Detailed Site Plan	
Reviewed by: PGP		Iredell County, NC	
Date: February, 2006		S&ME Project #1588-05-081	