IREDELL COUNTY HEALTH DEPARTMENT

Statesville Office (704) 878-5305 | Mooresville Office (704) 660-3625 | PERMIT # 2060540 (Old # 138058)

IMPROVEMENT PERMIT / AUTHORIZATION TO CONSTRUCT / OPERATION PERMIT / EXISTING SYSTEM

PIN # 4636-12-6191

APPLICANT: CP II LLC | APPLICANT ADDRESS: 3125 Presidential Pkwy Ste 200 Atlanta, GA 30340

SITE ADDRESS: 116 Sandy Cove Ct Mooresville, NC | PHONE: | ALT. PHONE:

SITE DIRECTIONS: Brawley School Rd TL Isle of Pines TL Sandy Cove in cul-de-sac on right

SUBDIVISION: Chesapeake Pt. | SECTION: 3 | LOT # 57 | LOT AREA: .897Ac | DESIGN FLOW: 480gpd | L.T.A.R.:

Septic Tank	1000 (gal)	STB 794	Date 7-29-16	☒ New System ☐ Repair ☐ Expansion	System Type: I II III IV V VI	☒ Residence	No. Bedrooms	4	Water Supply
Pump Tank	1000 (gal)	PT 283	Date 3-8-16	System Description: Pump-Pmp 25% Reduction		☒ Business	No. Persons	8	☐ Private
Pump Make		Model	Serial #	Repair System Description: LP PP BPS		☐ Other	No. Employees		☐ Public
# Nitrification Fields	1	# Lines 3	Linear Ft: 400 ft	Maintenance Agreement Required:	☐ YES ☒ NO	☐ Slab	☒ Crawl Space		☒ Community
Trench Width	36"	Max. Trench Bottom Depth 36"	Gravel Depth N/A		☐ GRAVITY ☒ PRESSURE	☐ Basement w/plumbing	☐ Basement w/o plumbing		

Comments / Conditions:


INITIAL SITE SKETCH

See attached/approved plan by Michael Athanas & Assoc dated 8/18/2015

NEED TO SET PUMP ON BOTTOM OF TANK

	Date	Initials
Drain Lines Checked	4-14-16	SF
Tanks Checked	4-14-16	SF
Pressure Manifold or Valve Box Checked	6-20	BA
Pressure Head Set	6-20	BA
Electrical Checked	6-21	BA
Floats Set	6-20	BA
Alarm Checked	6-20	BA
Maintenance Contract Y / (N)		

AS BUILT SKETCH

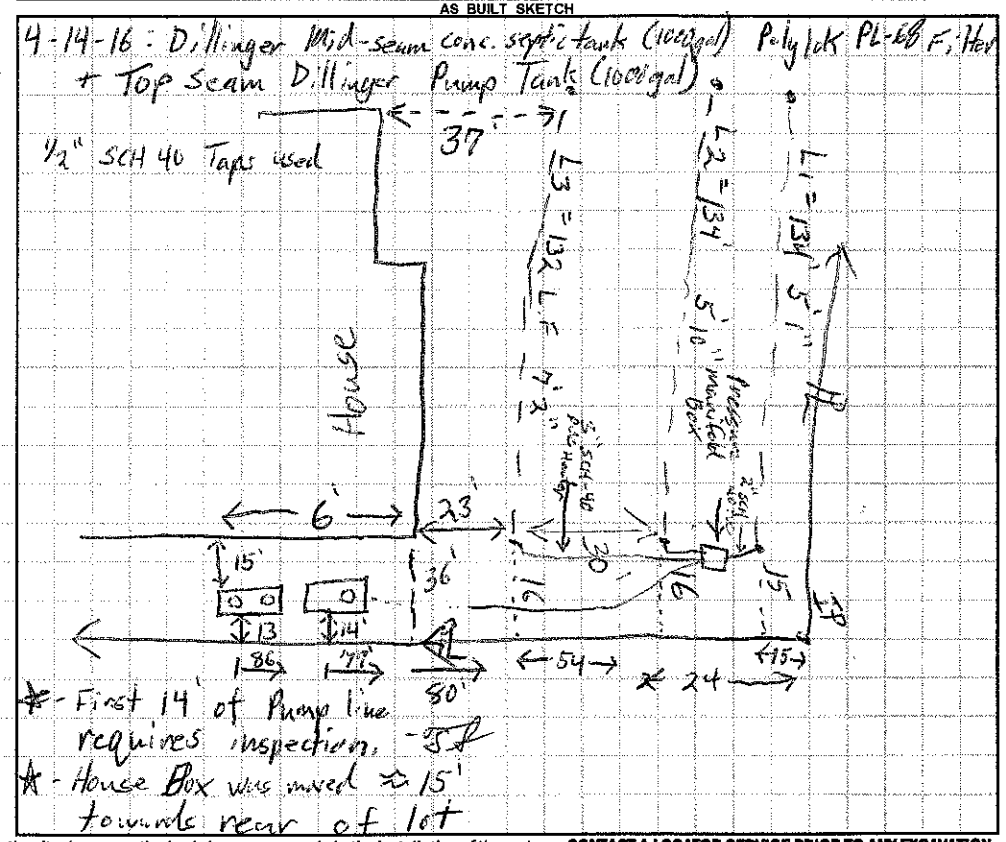

Permit can be suspended or revoked if any false information is supplied toward securing the permit / any unauthorized changes are made to the site / any unauthorized changes are made in the installation of the system. **CONTACT A LOCATOR SERVICE PRIOR TO ANY EXCAVATION**

☐ **IMPROVEMENT PERMIT** *with plat valid without expiration.* ☐ **IMPROVEMENT PERMIT** *with site plan valid for 60 mos.* ☒ **AUTHORIZATION TO CONSTRUCT** *valid for period equal to IMPROVEMENT PERMIT--not to exceed 60 mo.*


Owner / Applicant Signature: | Date: 9/17/15 | Installed by: Richard Abernathy

IMPROVEMENT PERMIT by: Maina Kihara RS | Date: 8/25/15 | OPERATION PERMIT by: BA Ellis | Date:

APPROVED JUN 21 2016

AUTHORIZATION TO CONSTRUCT by: Maina Kihara RS | Date: 8/25/15 | Existing System Inspected by: | Date:

Health Dept. Copy - WHITE Applicant (Final Approval) - YELLOW Applicant (Conditional Approval) - PINK

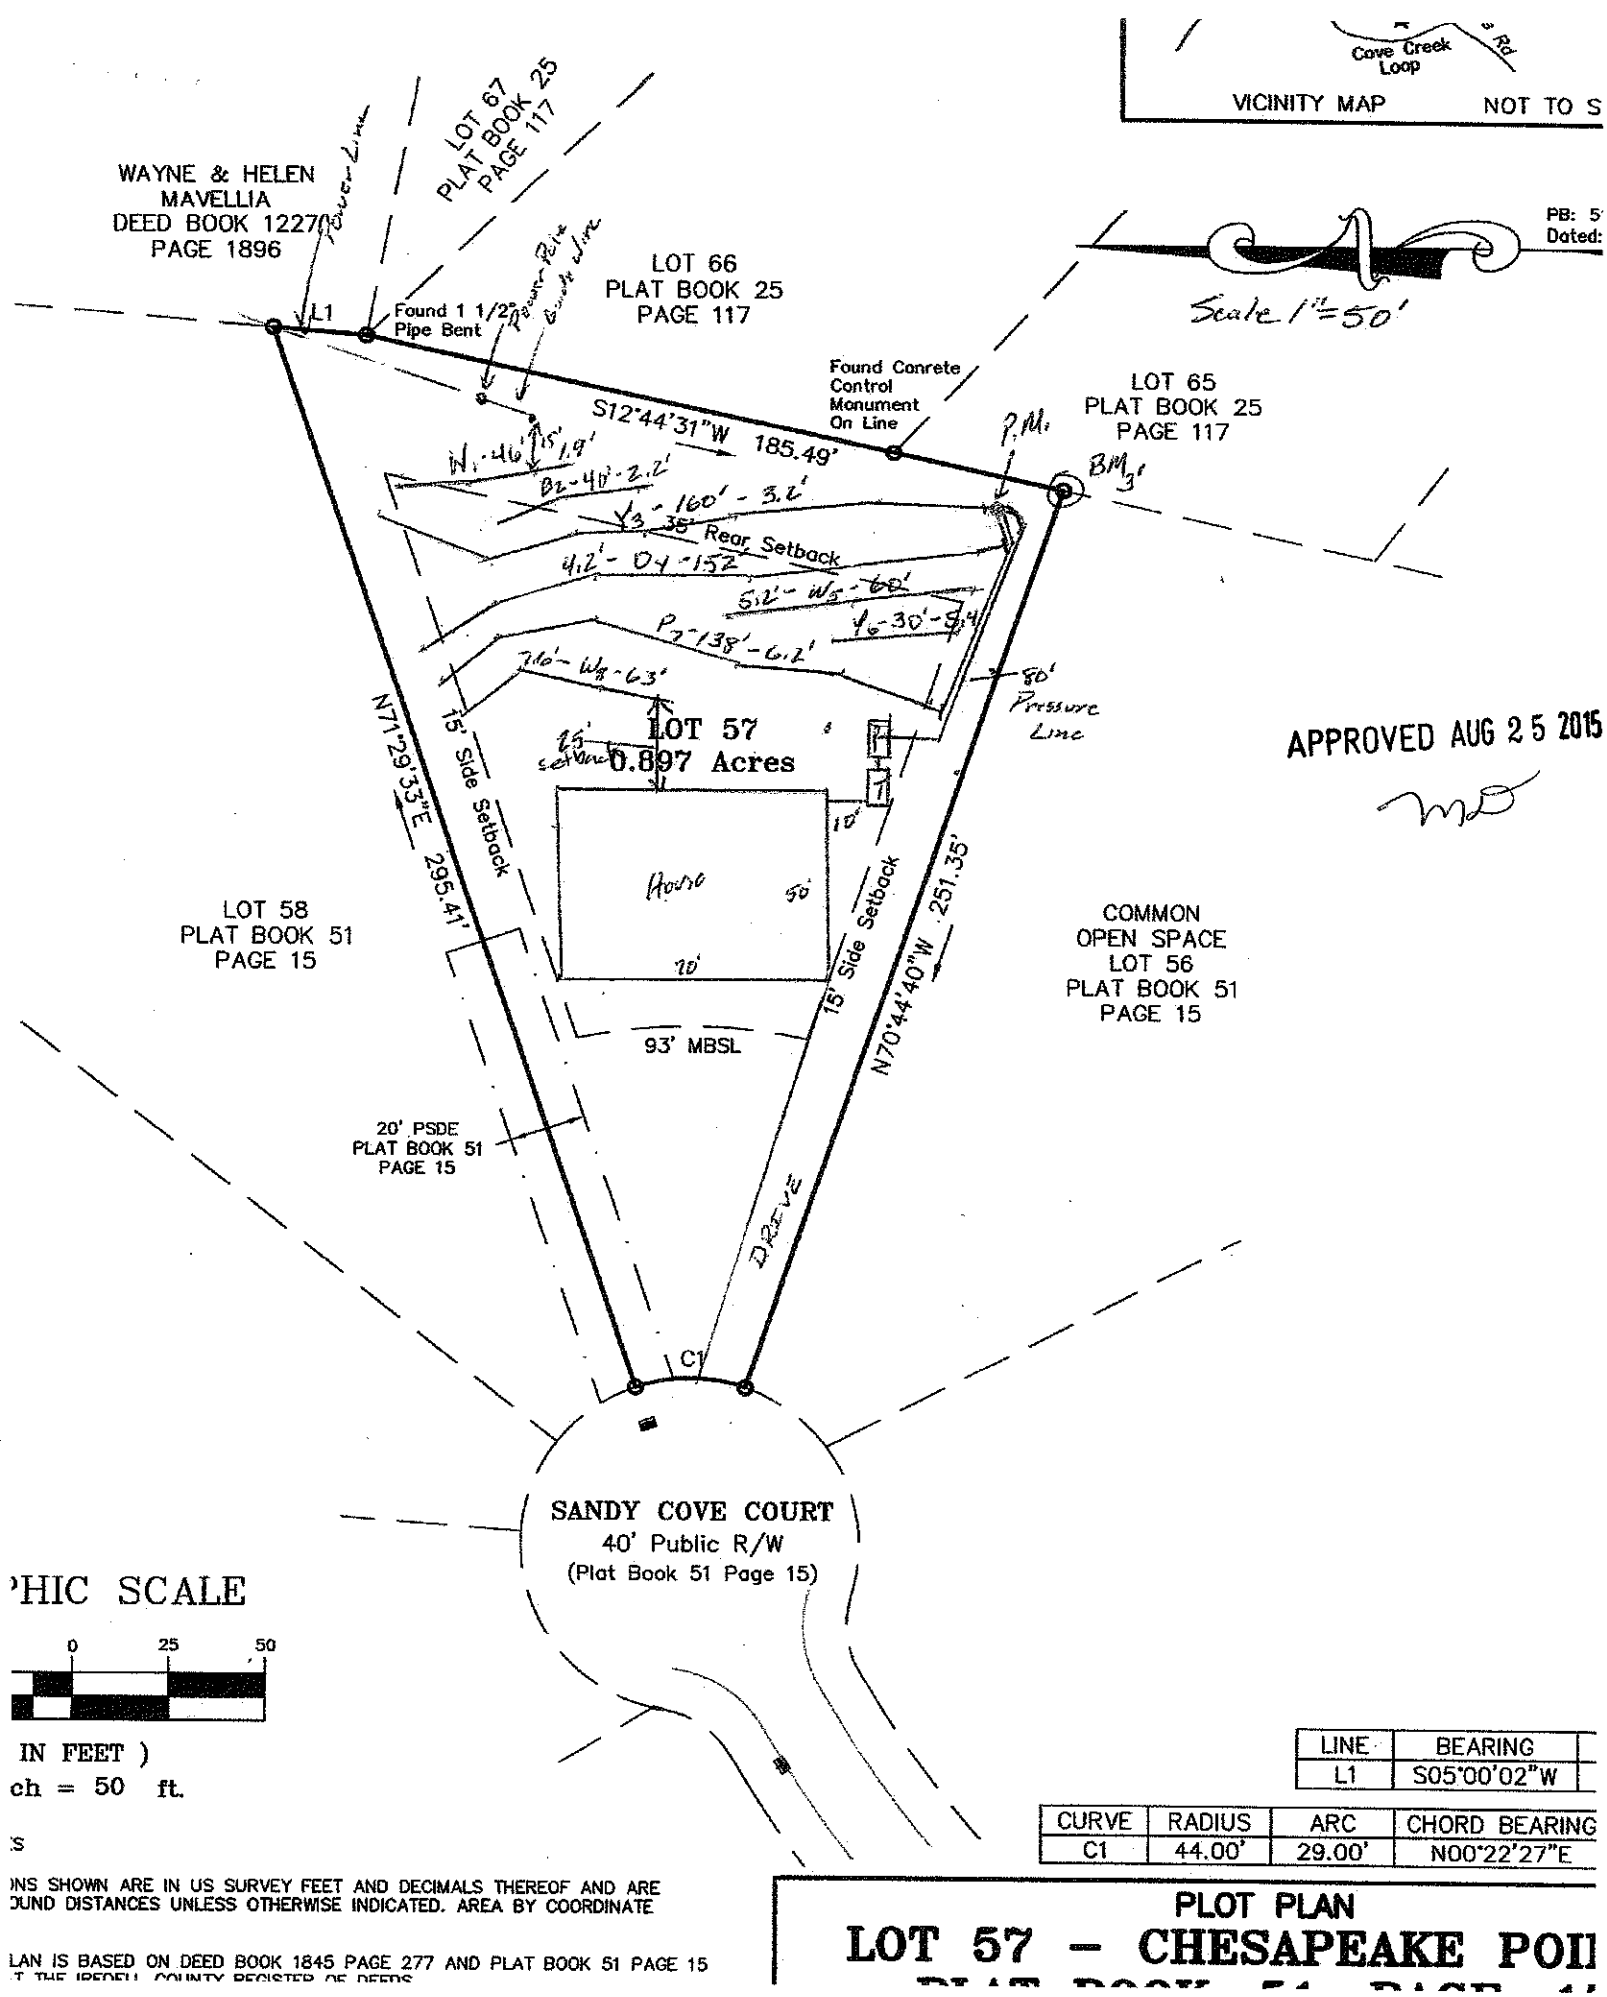

LINE	BEARING
L1	S05°00'02"W

CURVE	RADIUS	ARC	CHORD BEARING
C1	44.00'	29.00'	N00°22'27"E

PLOT PLAN
LOT 57 – CHESAPEAKE POI