IREDELL COUNTY HEALTH DEPARTMENT

STATESVILLE 704-878-5305 MOORESVILLE 704-664-5281

IMPROVEMENT PERMIT / AUTHORIZATION TO CONSTRUCT / OPERATION PERMIT / EXISTING SYSTEM INSPECTION

PERMIT# 133767 PIN# ~~4636-23-3137.019~~ 4636-12-6583 DATE March 22, 06

OWNER OR APPLICANT Diewst Enterprises PHONE: Business 704-369-0123 Home

ADDRESS 2125 Sharon Ln. Charlotte N.C. 28211

LOCATION Brawley Sch Rd. TL Isle of Pines TR Rocky Farm Rd to end TL Farm Knoll Cir. at end 100 Farm Knoll Way

SUBDIVISION Rocky Ridge Pt. BLOCK / SECTION LOT 19 LOT AREA .93Ac SITE CLASS. RS DESIGN FLOW 480gpd L.T.A.R. .25

Septic Tank: 1500 * 1 Gallons; STB ~~500~~ 535 Date 4-8-14

Pump Tank: Gallons; PT Date

Pump Make: Model Serial No.

Nitrification Field: No Fields 1 Square Feet 1440 Linear Feet 480

No Lines 4 Trench Width 36" Max Trench Bottom Depth 36" Gravel Depth N/A

☒ New System ☐ Repair ☐ Expansion System Type: I (II) III IV V VI

System Description: Gravity 25% Reduction LPP/BPS

Repair System Description:

Maintenance Agreement Required: ☐ Yes ☒ No Initially

☒ Gravity ☐ Pressure

☒ House/Mod. Home No. Bedrooms 4

☐ Mobile Home No. Persons

☐ Business No. Employees

☐ Other

Water Supply: ☐ Individual ☒ Public ☒ Community

☐ Slab ☒ Crawl Space ☐ Basement w/plumbing ☐ Basement wo/plumbing

Comments:/Conditions: ✗ PER Plan Specs
Shave off old burms in septic system AREA

Comments:/Conditions:

INITIAL SITE SKETCH

SEE PLAN from S&ME

AS BUILT SKETCH

INSTALLED AS SHOWN ON PLAN

Permit can be suspended or revoked if any false information is supplied toward securing the permit/any unauthorized changes are made to the site/any unauthorized changes are made in the installation of the system. Improvement Permit with plat valid without expiration ☐ Improvement Permit with site plan valid for sixty months ☒ Authorization to Construct is valid for a period equal to that of Improvement Permit – not to exceed sixty months.

Signed: Robert A. Drenski date 4/11/06

Improvement Permit by: date 3-22-06


Authorization to Construct by: date 1-17-14

Installed by: OVERBY

Operation Permit by: date 5-29-14

Existing System Inspection by: date

HEALTH DEPT. COPY: WHITE OWNER COPY (FINAL): YELLOW OWNER COPY (INITIAL): PINK

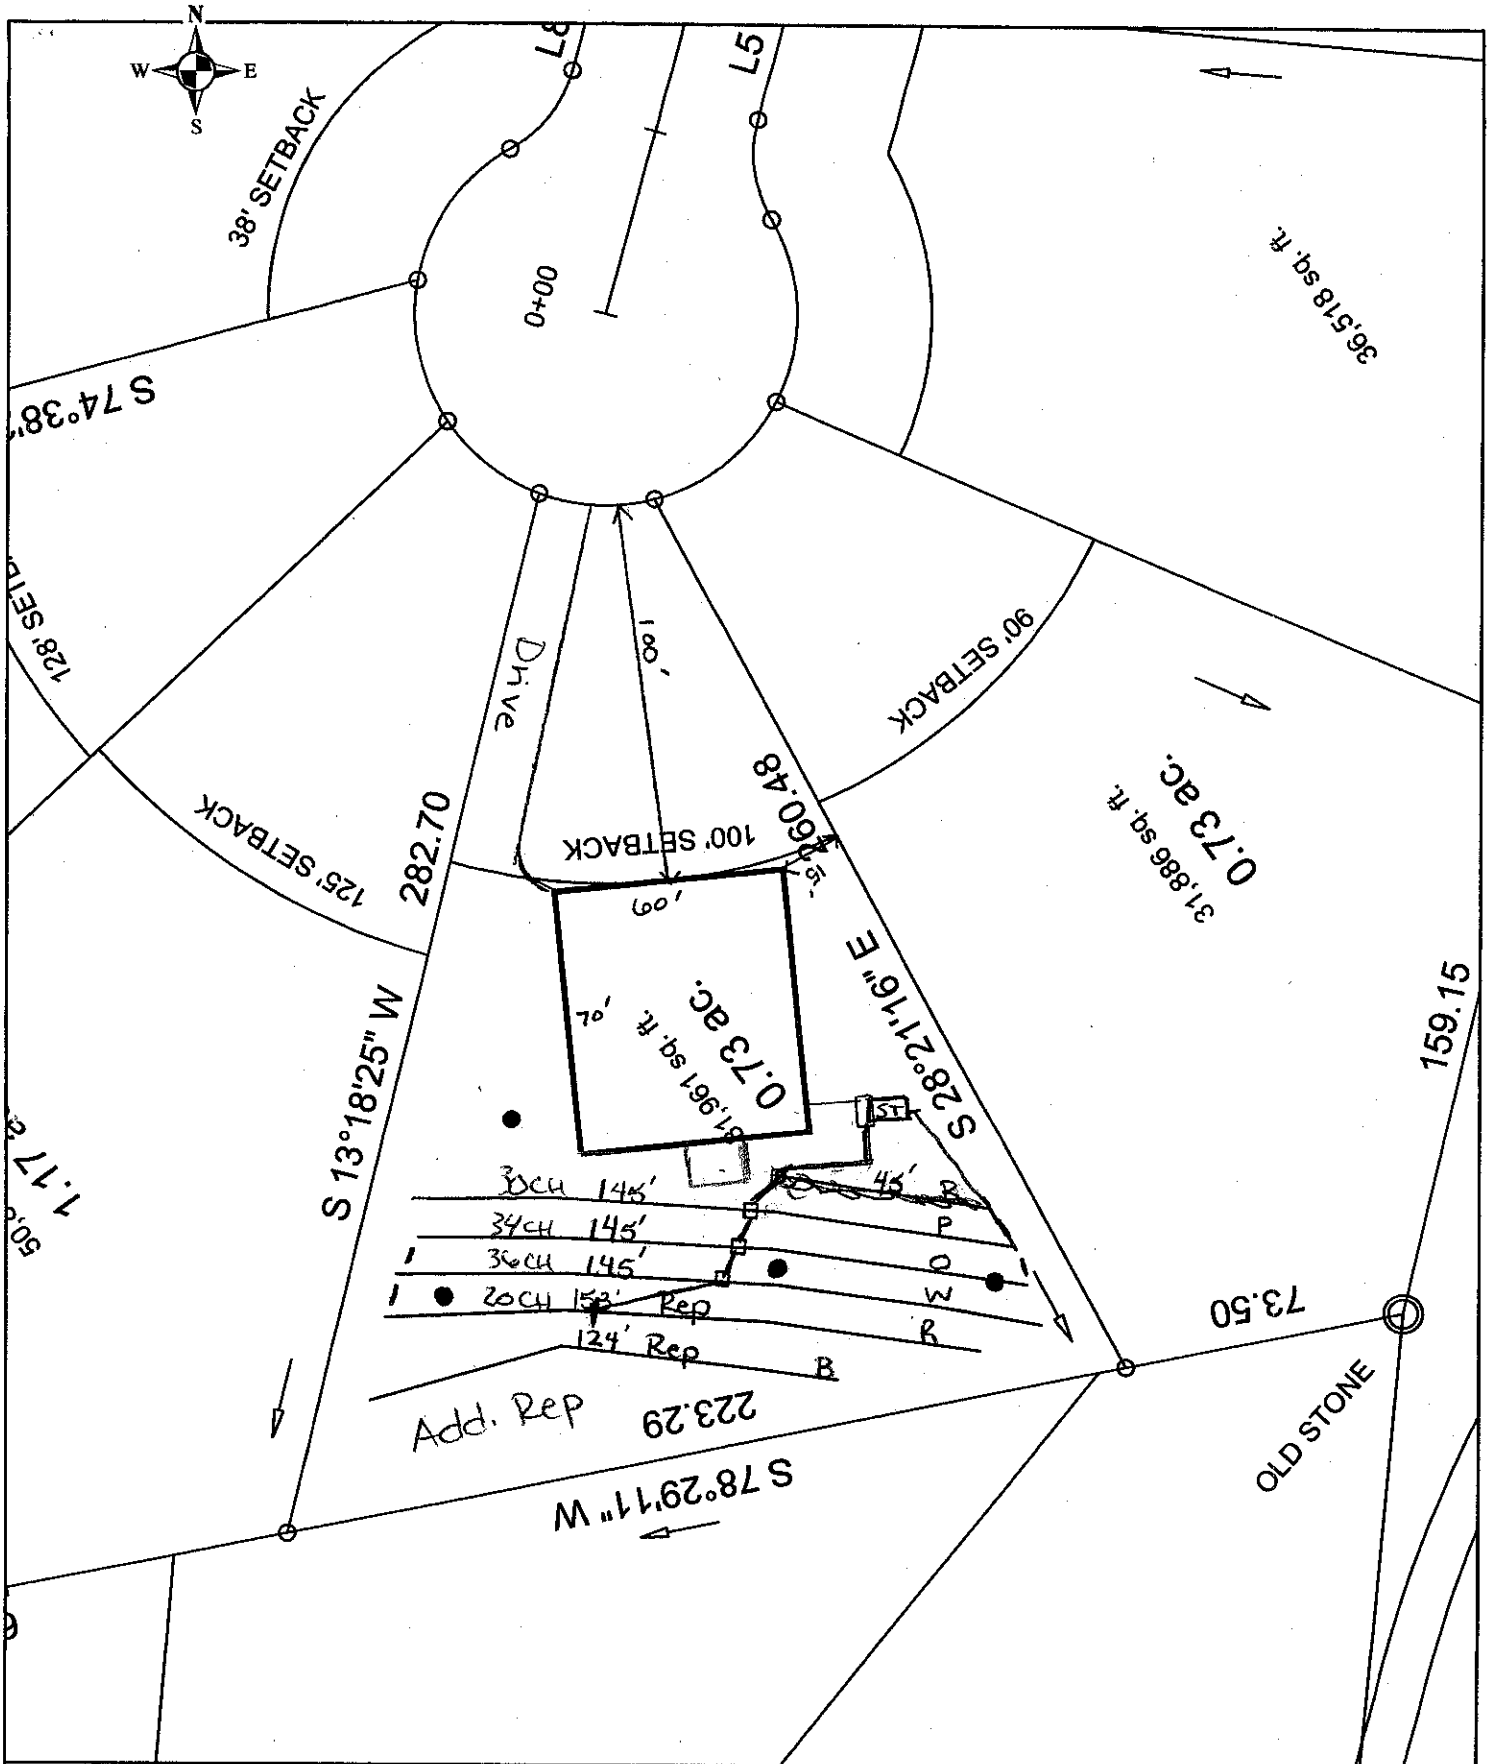

Scale: 1 inch equals 50 feet	S&ME ENVIRONMENTAL SERVICES • ENGINEERING • TESTING	Rocky Ridge - Lot 19	FIGURE
Drawn by: JBP		Scaled Detailed Site Plan	1
Reviewed by: PGP		Iredell County, NC	
Date: February, 2006		S&ME Project #1588-05-081	