Permit# 209762

# IREDELL COUNTY HEALTH DEPARTMENT

STATESVILLE 704-878-5305 MOORESVILLE 704-664-5281

## IMPROVEMENT PERMIT / AUTHORIZATION TO CONSTRUCT / OPERATION PERMIT / EXISTING SYSTEM INSPECTION

PERMIT# 13862 / 209762 PIN# ~~4636.12-0237.058~~ 4636127203 DATE October 24, 2006

OWNER OR APPLICANT Chesapeake Pointe, LLC / Mark Benitez PHONE: Business 678-300-8521 Home

ADDRESS 7380 McGinnis Ferry Rd., Suwanee, GA. 30024

LOCATION BSR TL Isle of Pines TR Cove Creek TL Sandy Cove end - 117 Sandy Cove Court, Mrsvl

SUBDIVISION Chesapeake Pointe BLOCK / SECTION III LOT 58 LOT AREA 1.1 Ac SITE CLASS. PS DESIGN FLOW 600gpd A.T.A.R. 03

Septic Tank: 1500 Gallons; STB 338 Date 9-5-15
Pump Tank: 1500 Gallons; PT 917 Date 9-5-15
Pump Make: Myers Model ME45 Serial No.
Nitrification Field: No Fields 1 Square Feet 1500 Linear Feet 500
No Lines 5@100' Trench Width 36" Max Trench Bottom Depth 36"

☒ New System ☐ Repair ☐ Expansion System Type: I II III IV V VI
System Description: pm 25% reduction
Repair System Description: LP PIPES
Maintenance Agreement Required: ☐ Yes ☒ No

☒ House/Mod. Home No. Bedrooms 5
☐ Mobile Home No. Persons
☐ Business No. Employees
☐ Other

Water Supply: ☐ Individual ☒ Public ☒ Community

Gravel Depth N/A ☐ Gravity ☒ Pressure ☐ Slab ☒ Crawl Space ☐ Basement w/plumbing ☐ Basement wo/plumbing

Comments/Conditions:
Shave off any old burms in septic system area

Comments/Conditions: 10/22/15 Checked tanks, lines set pressure Checked elect & alarm

INITIAL SITE SKETCH

SEE PLAN from S&ME

AS BUILT SKETCH

Installed Quick Up essentially as drawn


Permit can be suspended or revoked if any false information is supplied toward securing the permit/any unauthorized changes are made to the site/any unauthorized changes are made in the installation of the system. Improvement Permit with plat valid without expiration ☐ Improvement Permit with site plan valid for sixty months ☒ Authorization to Construct is valid for a period equal to that of Improvement Permit – not to exceed sixty months.

Signed: date 12-12-06 Installed by: Richard Abernathy

Improvement Permit by: date 10-24-06 Operation Permit by: Marcia H. Watson RS date 10/22/15

Authorization to Construct by: date 4-19-15 Existing System Inspection by: date

HEALTH DEPT. COPY: WHITE OWNER COPY (FINAL): YELLOW OWNER COPY (INITIAL): PINK

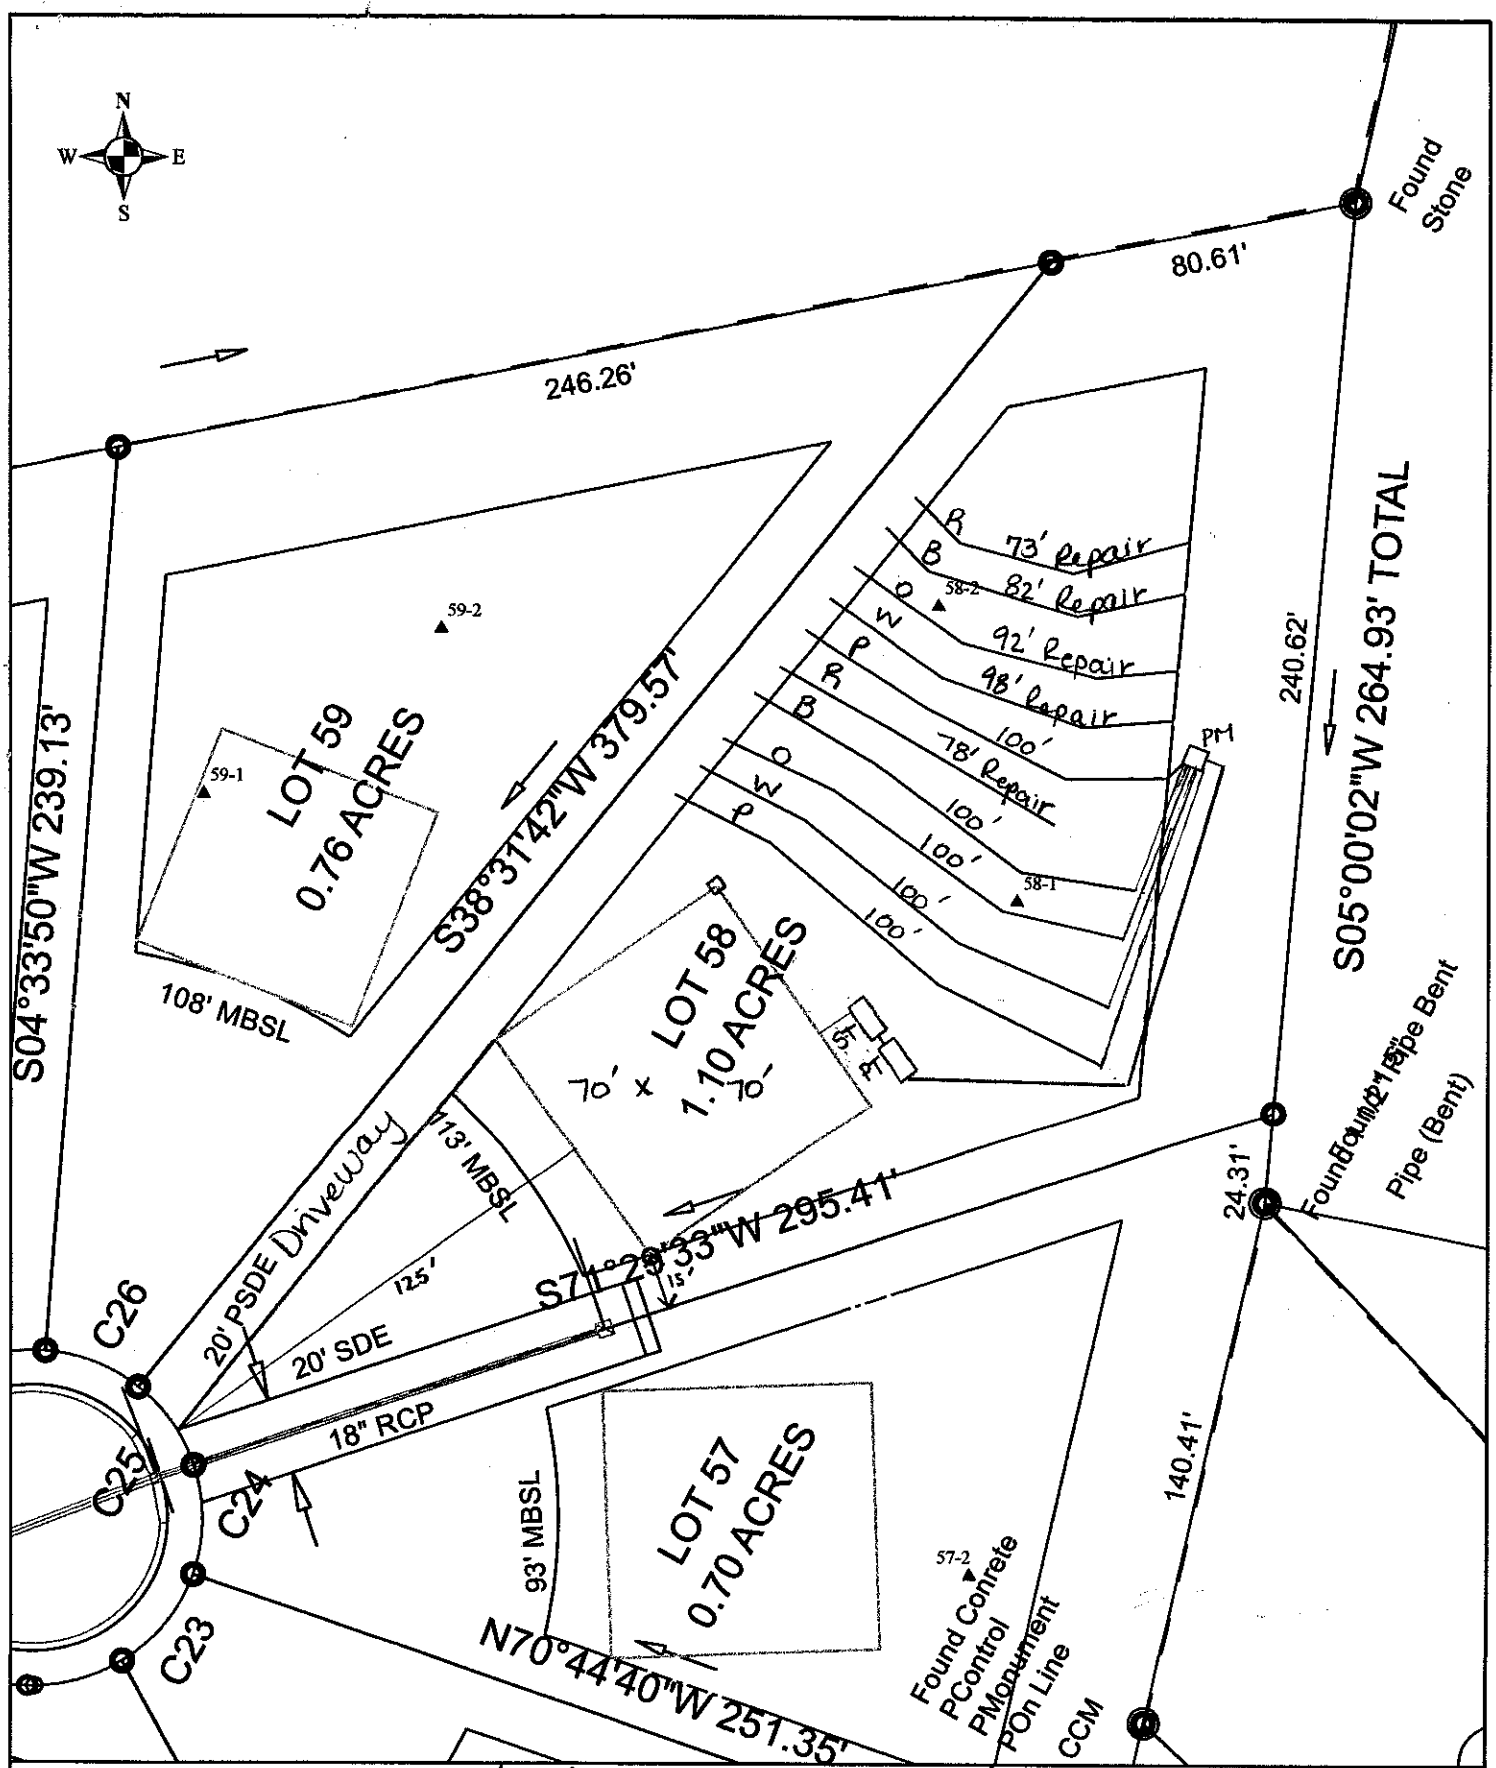


| | | | |
|---|---|---|---|
| Scale: 1 inch equals 50 feet | S&ME | Lot 58 Chesapeke Point | FIGURE |
| Drawn by: JBP | | Detailed, Scaled Site Plan | 1 |
| Reviewed by: KS | | Iredell County, NC | |
| Date: September, 2006 | ENVIRONMENTAL SERVICES • ENGINEERING • TESTING | S&ME Project #1588-04-011 | |