IREDELL COUNTY HEALTH DEPARTMENT

STATESVILLE 704-878-5305 MOORESVILLE 704-664-5281

IMPROVEMENT PERMIT / AUTHORIZATION TO CONSTRUCT / OPERATION PERMIT / EXISTING SYSTEM INSPECTION

PERMIT# ~~13376~~ 20465 PIN# ~~4636 23 3131 7048~~ 4636-12-7586 DATE March 17, 06

OWNER OR APPLICANT Diesel Enterprises / True Homes PHONE: Business 704 309-0123 Home

ADDRESS 2125 Sharon Ln. Charlotte, N.C. 28211

LOCATION Brawley School Rd TR end of Pines TR Rocky Farm Rd. TL Farm Knoll Ln. st end on left

SUBDIVISION Rocky Ridge Ph I BLOCK / SECTION LOT 18 LOT AREA ±.73Ac SITE CLASS RS DESIGN FLOW 480gpd L.T.A.R. 1 ±25

Septic Tank: 1/1500# Gallons: STB 338 Date 11/5/14

Pump Tank: Gallons: PT Date

Pump Make: Model Serial No.

Nitrification Field: No Fields 1 Square Feet 1440 Linear Feet 480

No Lines 5 Trench Width 36" Max Trench Bottom Depth 36" Gravel Depth NA

☒ New System ☐ Repair ☐ Expansion System Type: I (II) III IV V VI

System Description: Gravity 25% Reduction

Repair System Description: LPP BPS

Maintenance Agreement Required: ☐ Yes ☒ No initially

☒ House/Mod. Home ☐ Mobile Home ☐ Business ☐ Other

No. Bedrooms 4 No. Persons No. Employees

Water Supply: ☐ Individual ☒ Public ☒ Community

☒ Gravity ☐ Pressure ☐ Slab ☒ Crawl Space ☐ Basement w/plumbing ☐ Basement wo/plumbing

Comments:/Conditions: * PER Plan Specs

Shave off any old burms in septic system area.

Comments:/Conditions: 9/29/14 Reviewed Floor plans, in compliance with Septic plan. Must place house as shown in plan.

INITIAL SITE SKETCH

SEE Plan from S&ME

AS BUILT SKETCH

Permit can be suspended or revoked if any false information is supplied toward securing the permit/any unauthorized changes are made to the site/any unauthorized changes are made in the installation of the system. Improvement Permit with plan valid without expiration ☐ Improvement Permit with site plan valid for sixty months ☒ Authorization to Construct is valid for a period equal to that of Improvement Permit – not to exceed sixty months.

Signed: Robert B. Diesel date 4/11/06

Improvement Permit by: Nelson RS date 3-17-06


Authorization to Construct by: Maria Dotson RS date 7/29/14

Installed by: Overby Septic

Operation Permit by: P. Jessup date 12/9/14

Existing System Inspection by: date

HEALTH DEPT. COPY: WHITE OWNER COPY (FINAL): YELLOW OWNER COPY (INITIAL): PINK

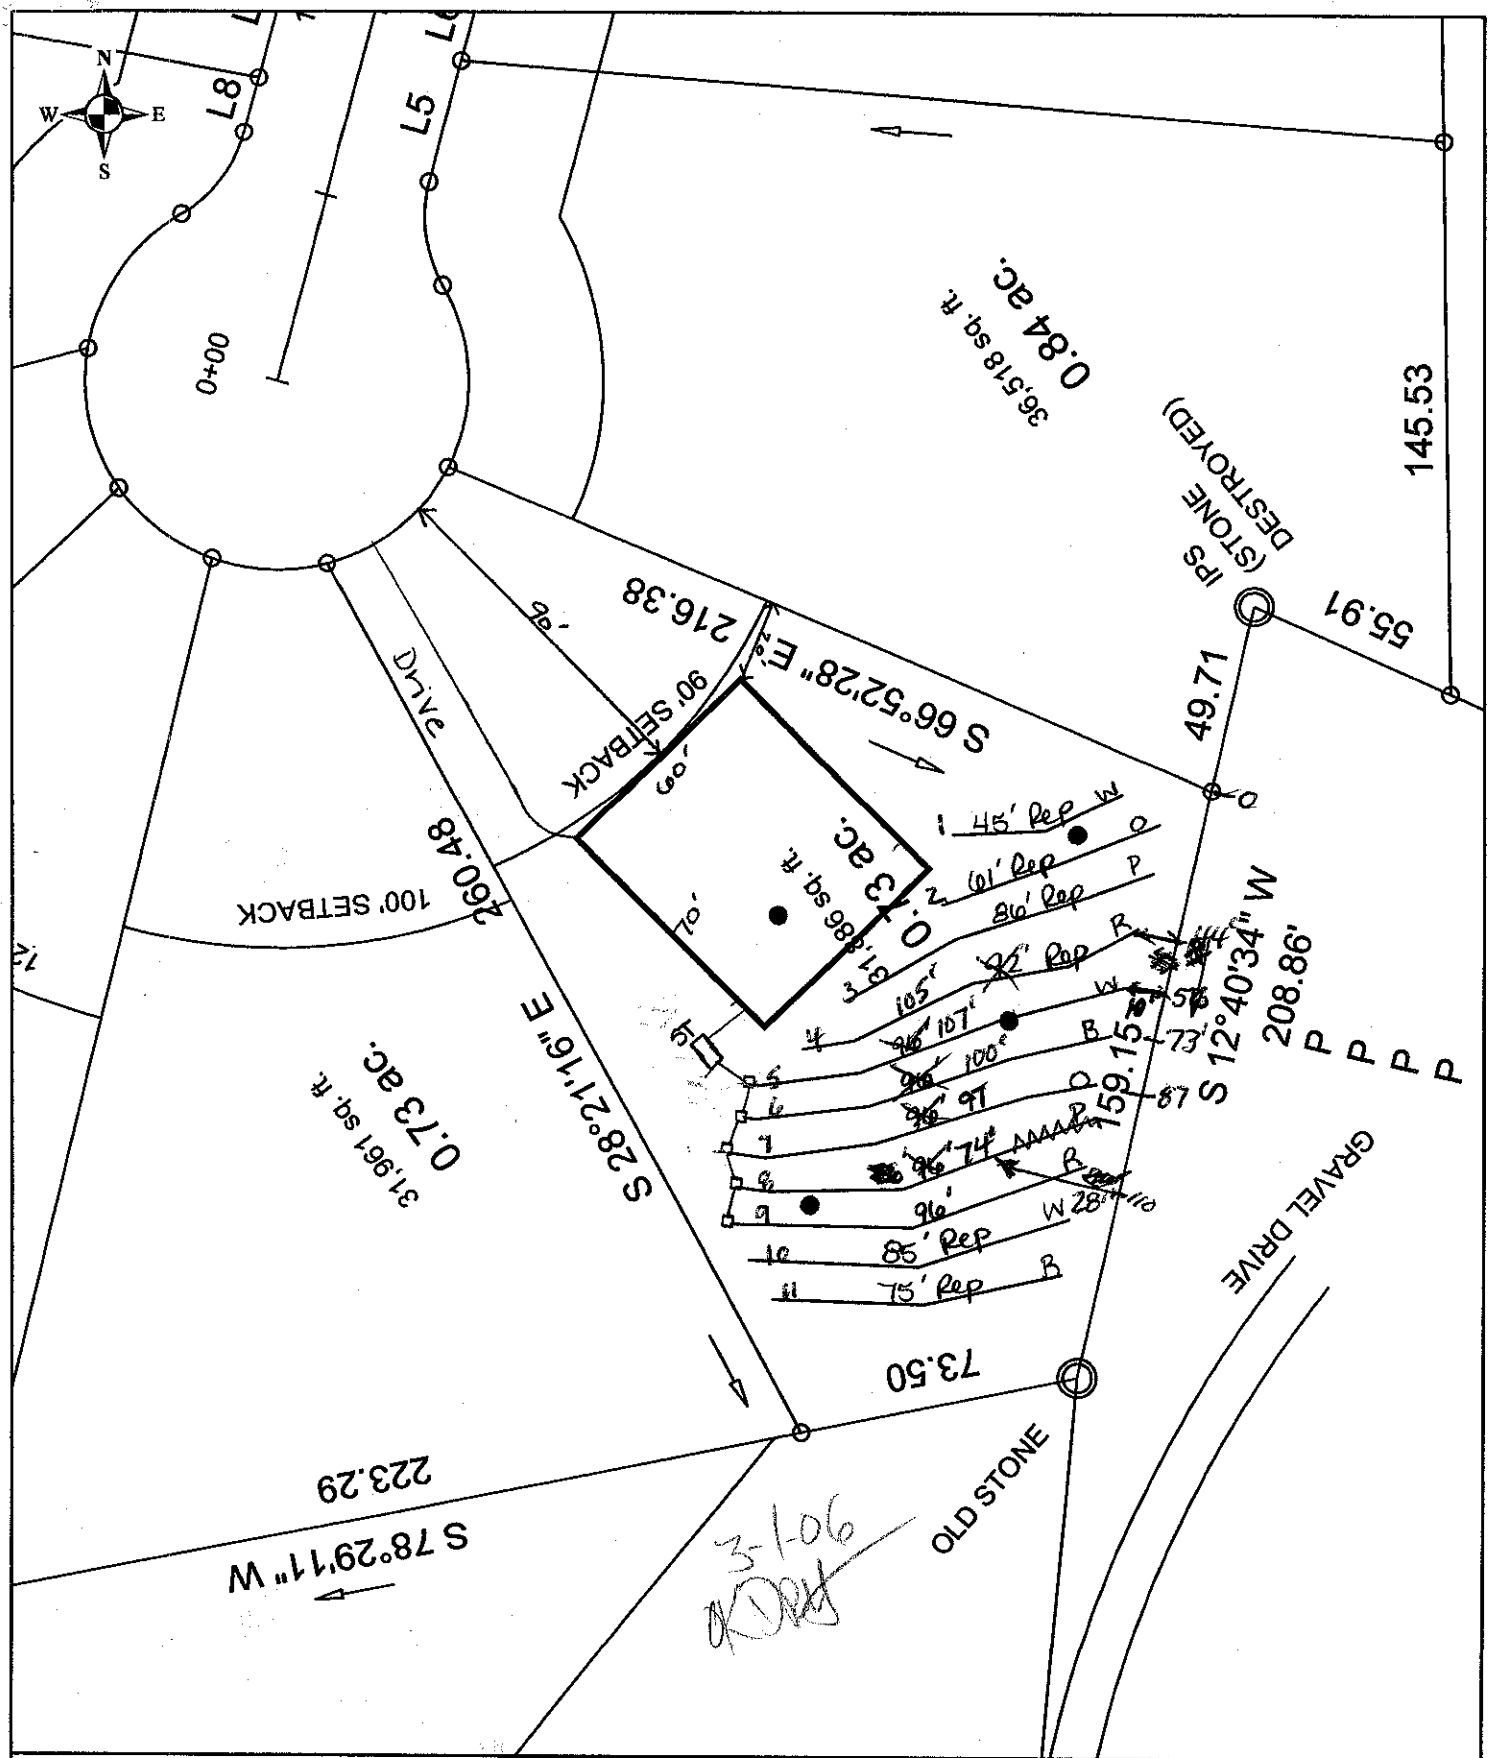

Scale: 1 inch equals 50 feet	S&ME	Rocky Ridge - Lot 18	FIGURE
Drawn by: JBP		Scaled Detailed Site Plan	1
Reviewed by: PGP		Iredell County, NC	
Date: February, 2006	ENVIRONMENTAL SERVICES • ENGINEERING • TESTING	S&ME Project #1588-05-081	