IREDELL COUNTY HEALTH DEPARTMENT

STATESVILLE 704-878-5305 MOORESVILLE 704-664-5281

IMPROVEMENT PERMIT / AUTHORIZATION TO CONSTRUCT / OPERATION PERMIT / EXISTING SYSTEM INSPECTION

PERMIT# 13962 20421 PIN# 4636-23-3131.017 4636-12-8721 DATE March 17, 06

OWNER OR APPLICANT Quest Enterprises PHONE: Business 704 309 0123 Home

ADDRESS 2125 Sharon Lane, Charlotte, N.C. 28211

LOCATION Brawley School Rd. TL Isle of Pines TR Rocky Farm Rd. TL Farm Knoll Ln. 3rd Lot on left

SUBDIVISION Rocky Ridge Ph 1 BLOCK / SECTION LOT 17 LOT AREA .84ac SITE CLASS. PS DESIGN FLOW L.T.A.R. .25

Septic Tank: 1500 * Gallons: STB [redacted] Date 5-23-14

Pump Tank: Gallons: PT Date

Pump Make: Model Serial No.

Nitrification Field: No Fields 1 Square Feet 1440 Linear Feet 480

No Lines 5 Trench Width 36" Max Trench Bottom Depth 36"

☒ New System ☐ Repair ☐ Expansion System Type: I II III IV V VI

System Description: Gravity 25% Reduction

Repair System Description: LPP PBRS

Maintenance Agreement Required: ☐ Yes ☒ No Initially

☒ House/Mod. Home ☐ Mobile Home ☐ Business ☐ Other

No. Bedrooms 4 No. Persons No. Employees

Water Supply: ☐ Individual ☒ Public ☐ Community

Gravel Depth NA ☒ Gravity ☐ Pressure ☐ Slab ☒ Crawl Space ☐ Basement w/plumbing ☐ Basement wo/plumbing

Comments:/Conditions: * PER Plan Specs

Shave off any old stumps in septic system area.

Levelers required for use with a single D-Box.

Comments:/Conditions:

INITIAL SITE SKETCH

SEE Plan from S&ME

AS BUILT SKETCH

SEE ATTACHED PICTURES BA

See attachment for as-built sketch + info. & Checklist for Conventional Septic System Installation

APPROVED SEP 23 2014

Permit can be suspended or revoked if any false information is supplied toward securing the permit/any unauthorized changes are made to the site/any unauthorized changes are made in the installation of the system. Improvement Permit with plat valid without expiration ☐ Improvement Permit with site plan valid for sixty months ☒ Authorization to Construct is valid for a period equal to that of Improvement Permit – not to exceed sixty months.

Signed: Robert B. Priest date 4/11/06

Improvement Permit by: Jimson, RS date 3-17-06


Authorization to Construct by: APPROVED JUN 25 2014 date

Installed by: Howard [redacted]


Operation Permit by: Richard Farmer date [redacted] 9/24/14

Existing System Inspection by: date

HEALTH DEPT. COPY: WHITE OWNER COPY (FINAL): YELLOW OWNER COPY (INITIAL): PINK

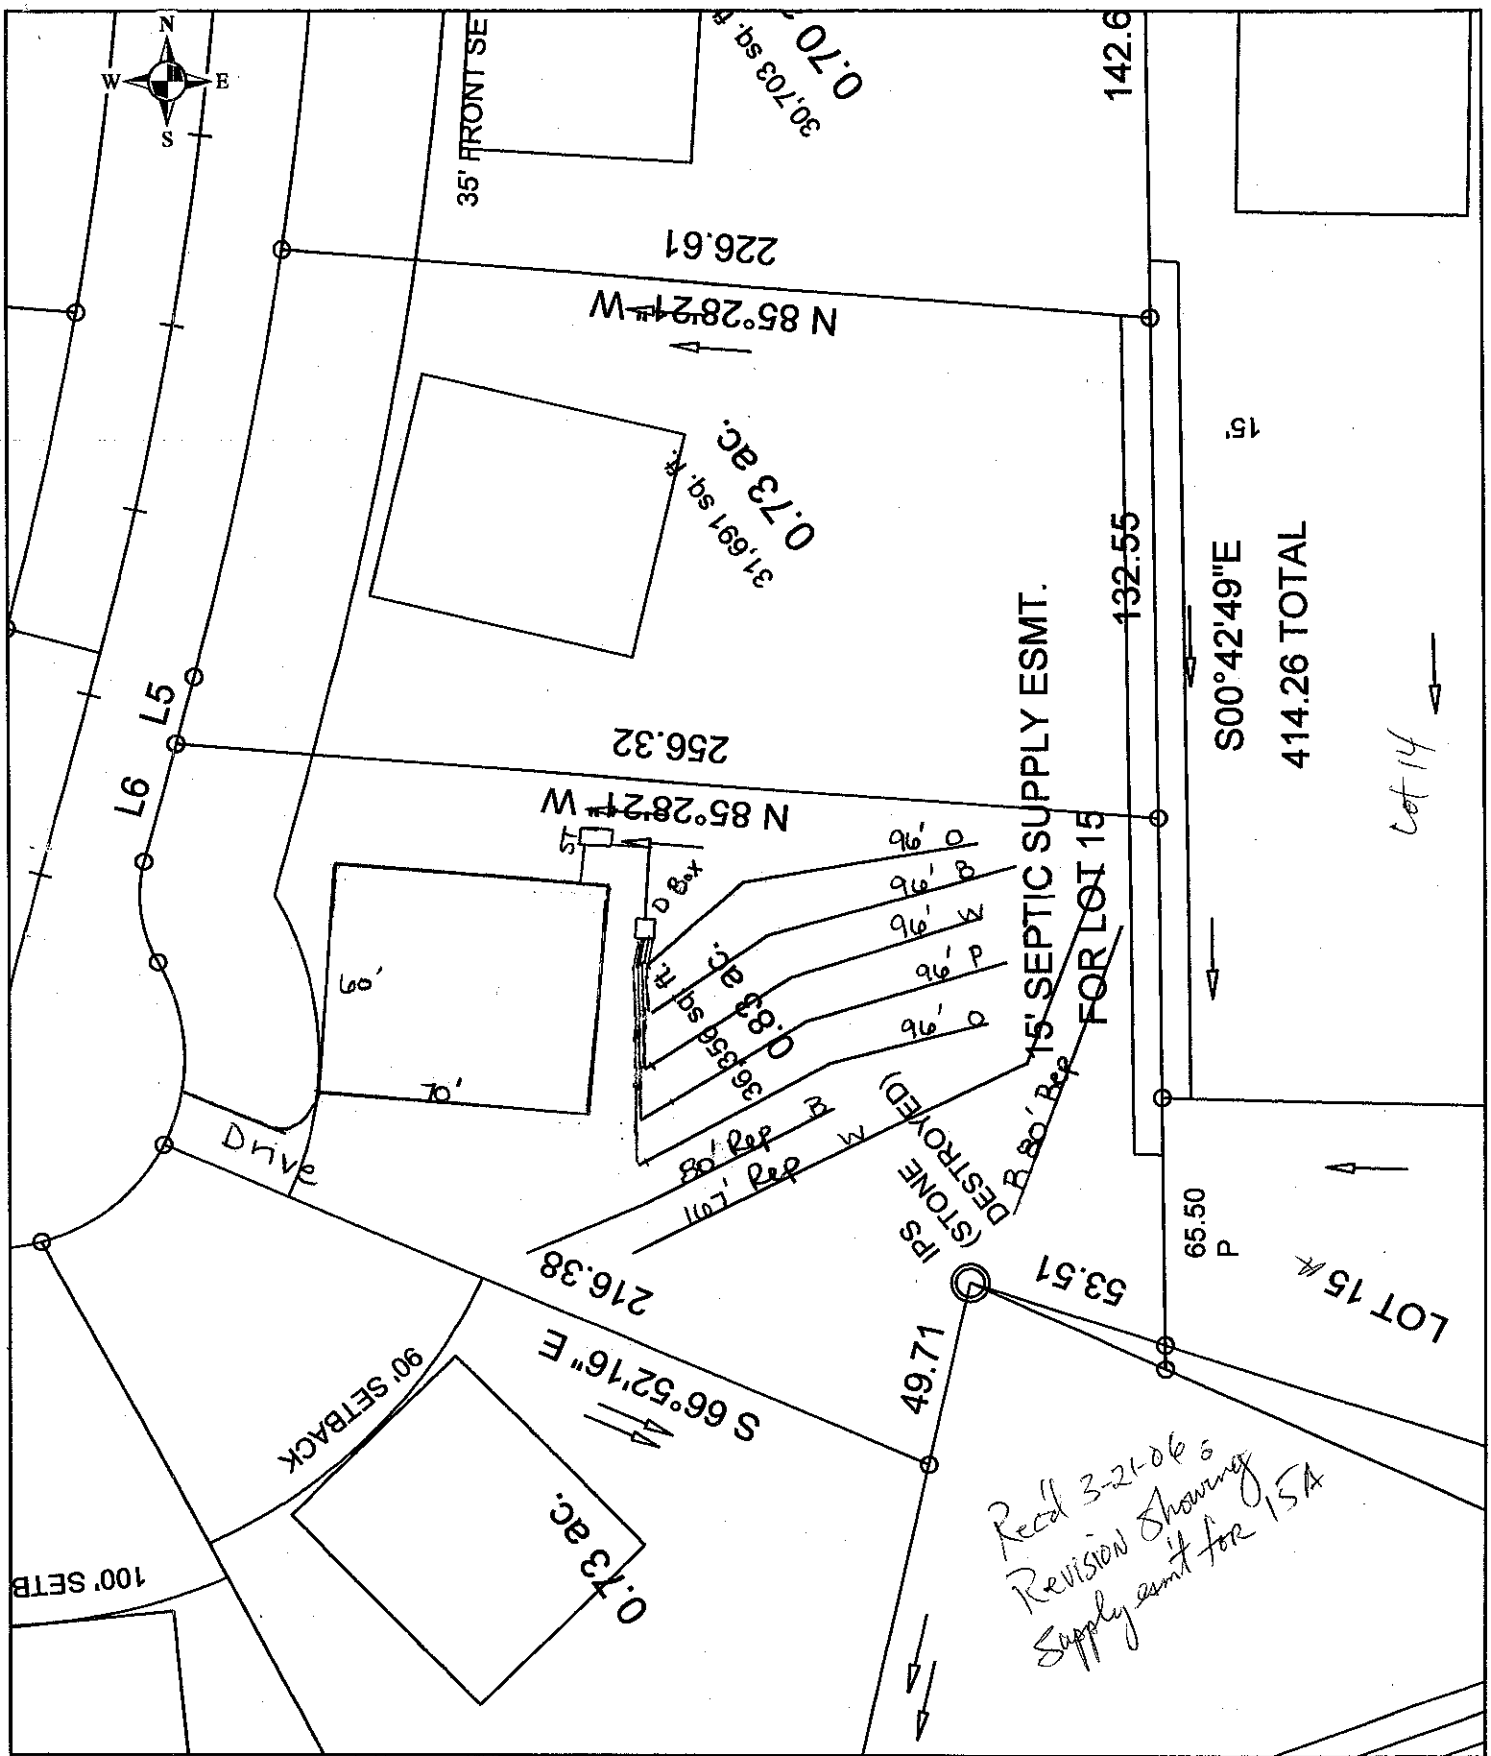

Scale: 1 inch equals 50 feet	S&ME	Rocky Ridge - Lot 17	FIGURE
Drawn by: JBP		Scaled Detailed Site Plan	1
Reviewed by: PGP		Iredell County, NC	
Date: March, 2006	ENVIRONMENTAL SERVICES • ENGINEERING • TESTING	S&ME Project #1588-05-081	

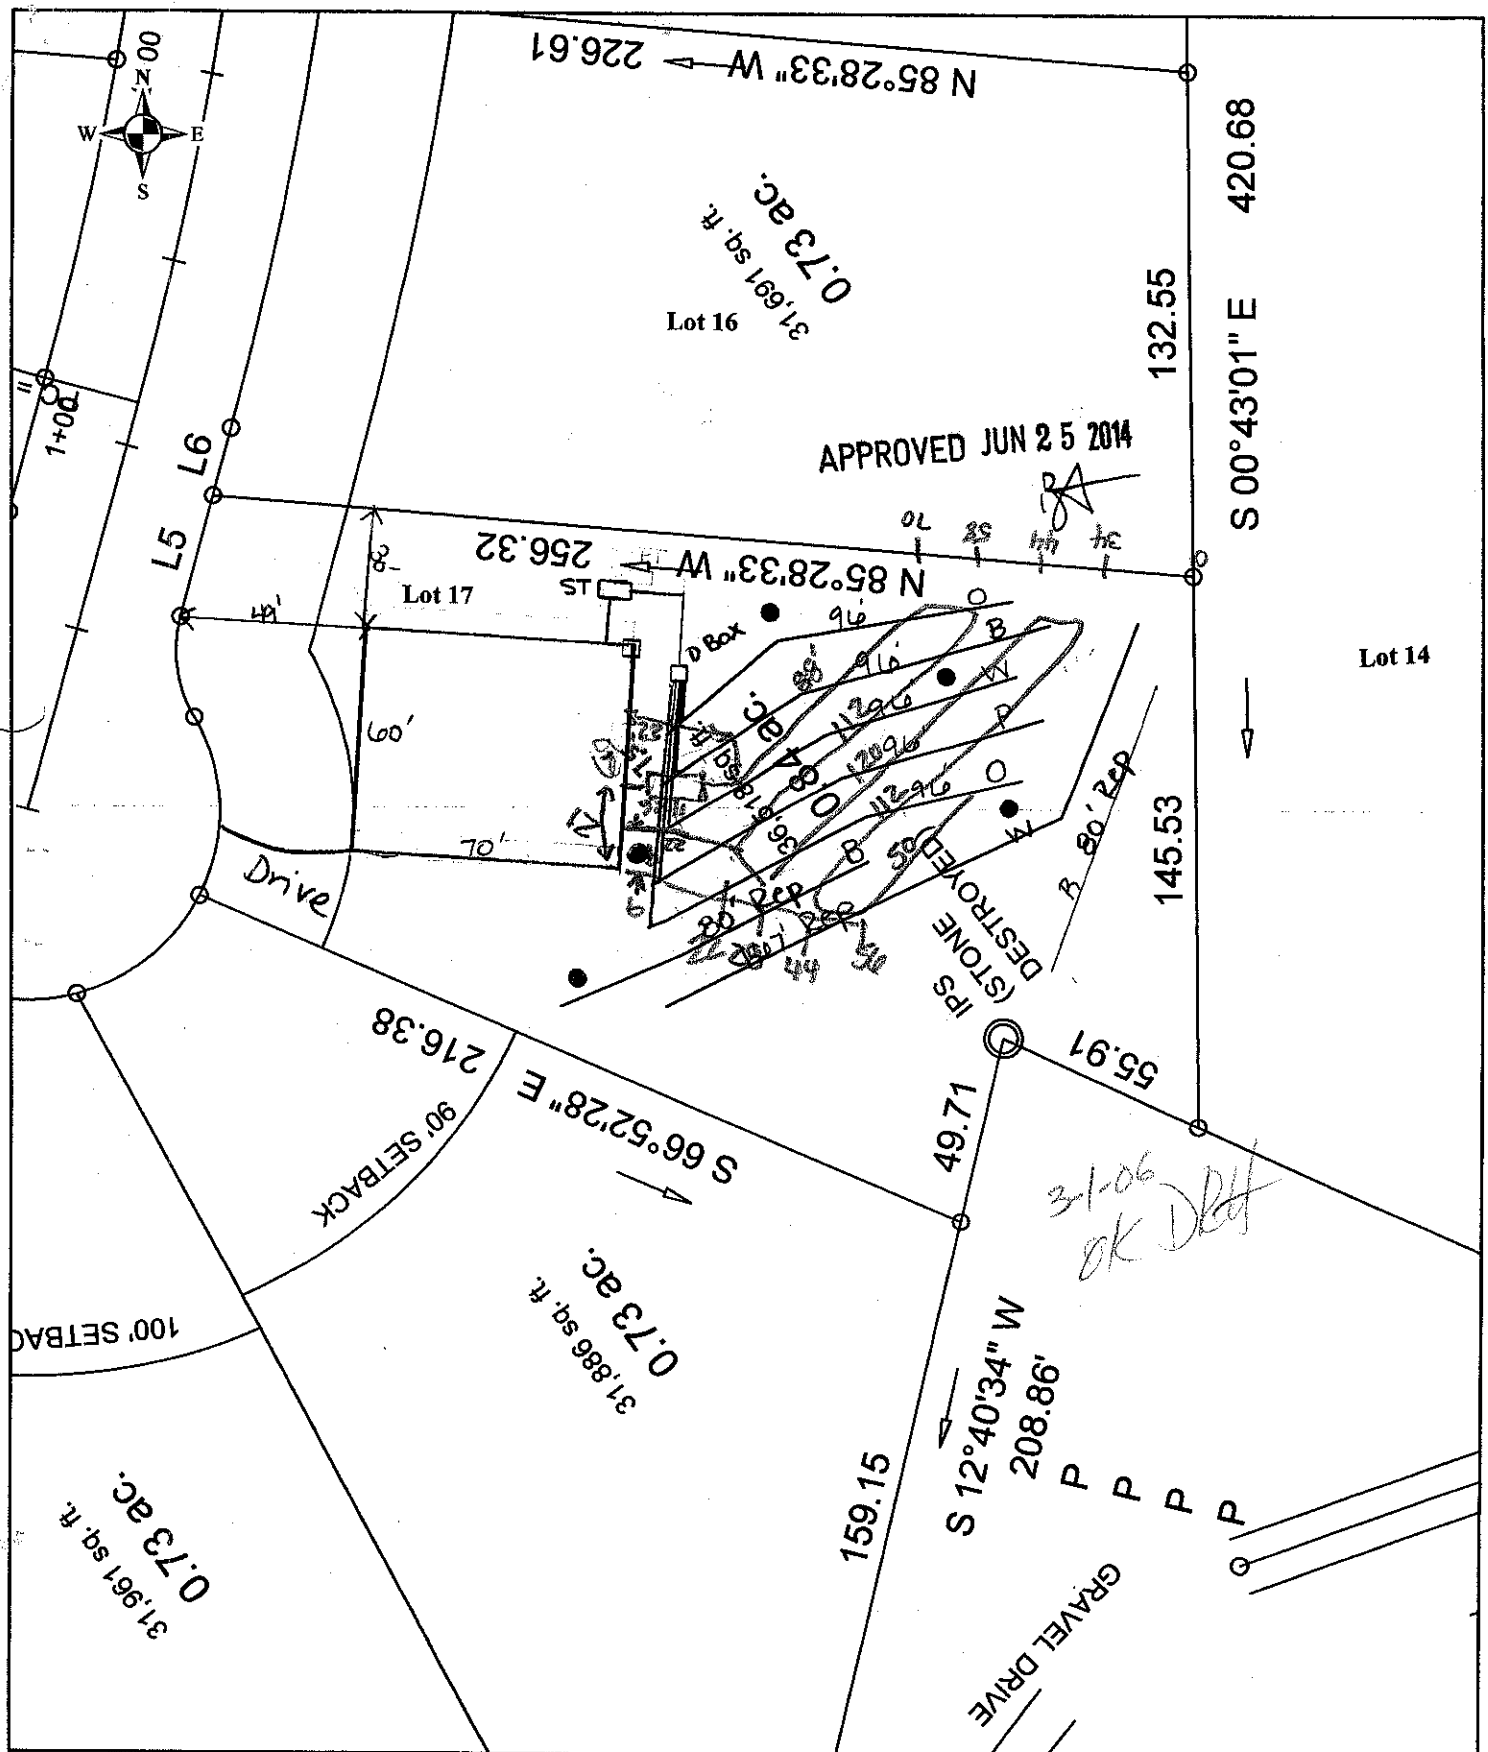

Scale: 1 inch equals 50 feet	S&ME	Rocky Ridge - Lot 17	FIGURE
Drawn by: JBP		Scaled, Detailed Site Plan	1
Reviewed by: PGP		Iredell County, NC	
Date: January, 2006	ENVIRONMENTAL SERVICES • ENGINEERING • TESTING	S&ME Project #1588-05-081	