$ 700

IREDELL COUNTY HEALTH DEPARTMENT

STATESVILLE 704-878-5305 MOORESVILLE 704-664-5281

IMPROVEMENT PERMIT / AUTHORIZATION TO CONSTRUCT / OPERATION PERMIT / EXISTING SYSTEM INSPECTION

PERMIT# 135059 PIN# 4636046059 9836132541 DATE 4-25-06

OWNER OR APPLICANT Chesapeake Pointe LLC / Orleans Homes PHONE: Business 704-942-1250 Home

ADDRESS 7380 McGinnis Ferry Rd Suwanee GA 30024

LOCATION Brawley School Rd TL Isle of Pines TP Cove Creek on left

SUBDIVISION Chesapeake Pt BLOCK / SECTION Ph 2 LOT 91 LOT AREA .69 Ac SITE CLASS. PS DESIGN FLOW 480gpd L.T.A.R. .25 gpd/ft²

Septic Tank: 1000 Gallons; STB 794 Date 4-30-13

Pump Tank: 1000 Gallons; PT 27 Date 8-24-13

Pump Make Hydromatic Model Shef 45 Serial No.

Nitrification Field: No Fields 1 Square Feet 1920 Linear Feet 320

No Lines 4@80' Trench Width 24" Max Trench Bottom Depth 36"

☒ New System ☐ Repair ☐ Expansion System Type: I II III (IV) V VI

System Description: LP PPBPS

Repair System Description: LP PPBPS

Maintenance Agreement Required: ☒ Yes ☐ No

☒ House/Mod. Home No. Bedrooms 4

☐ Mobile Home No. Persons

☐ Business No. Employees

☐ Other

Water Supply: ☐ Individual ☐ Public ☑ Community


Gravel Depth NA ☐ Gravity ☒ Pressure ☐ Slab ☒ Crawl Space ☐ Basement w/plumbing ☐ Basement wo/plumbing

Comments:/Conditions: 74 panels
6/19/13 Reviewed Floor plans, In Compliance with original
377 wide trenches


Comments:/Conditions: 10/22/13 Installed essentially As drawn. Checked tanks & lines & pressure
Drilled 3/16" hole.
11/18/13 Maint agreement rec.

1"=50'

INITIAL SITE SKETCH

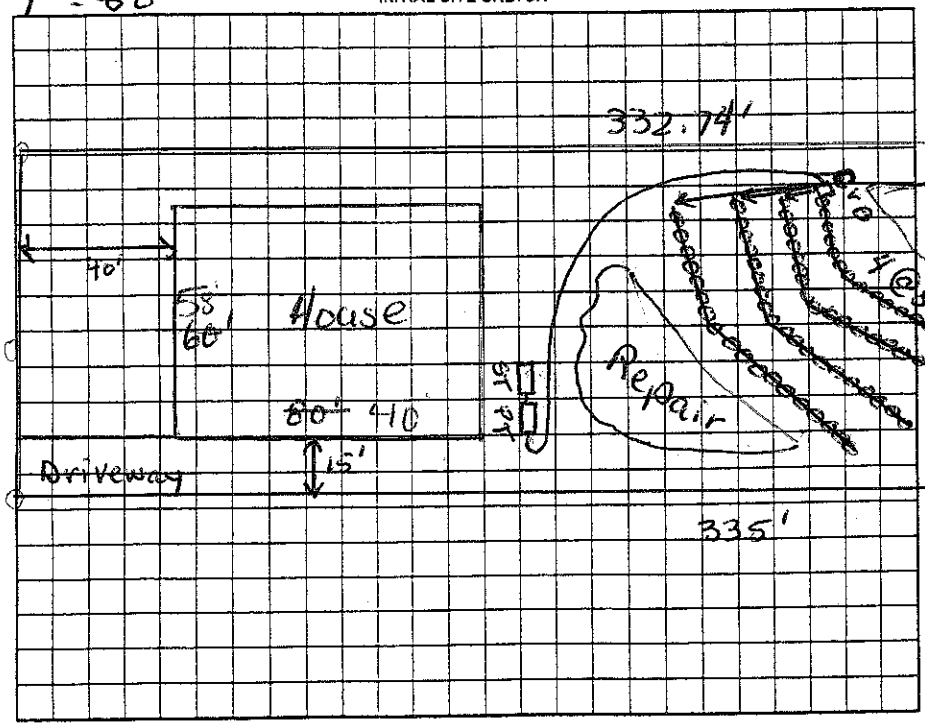

AS BUILT SKETCH

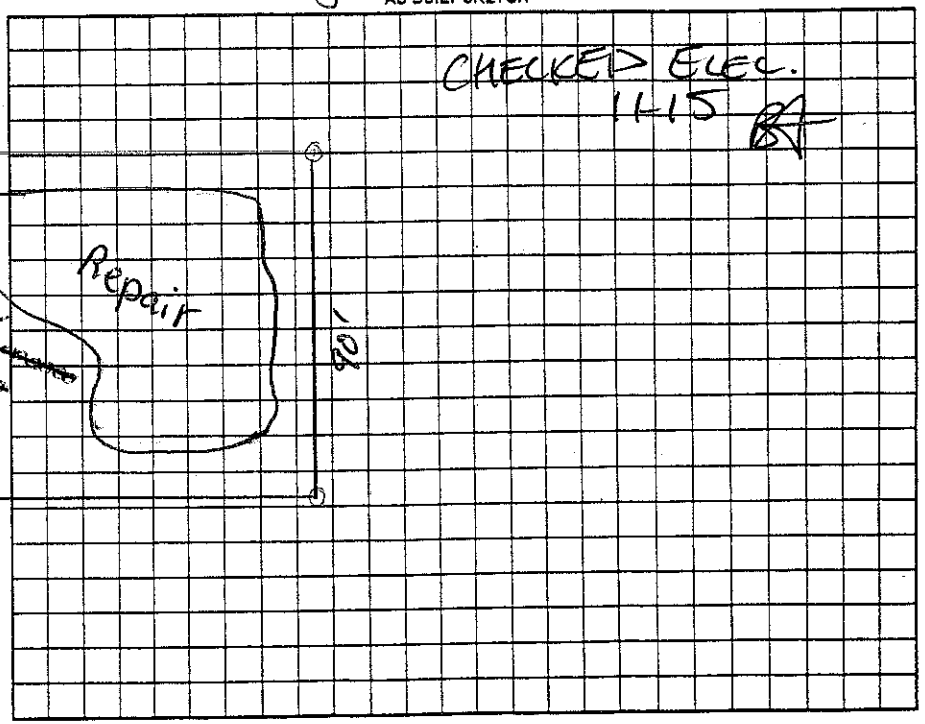

Permit can be suspended or revoked if any false information is supplied toward securing the permit/any unauthorized changes are made to the site/any unauthorized changes are made in the installation of the system. Improvement Permit with plat valid without expiration. ☐ Improvement Permit with site plan valid for sixty months ☐ Authorization to Construct is valid for a period equal to that of Improvement Permit – not to exceed sixty months.

Signed: [signature] date 4.27.06 Installed by: Willie Chambers BS

Improvement Permit by: Judy Melvill RS date 4-25-06 Operation Permit by: Maureen Dolan RS date 11/18/13

Authorization to Construct by: Maureen Dolan RS date 6-19-13 Existing System Inspection by: date

HEALTH DEPT. COPY: WHITE OWNER COPY (FINAL): YELLOW OWNER COPY (INITIAL): PINK