#700

IREDELL COUNTY HEALTH DEPARTMENT

STATESVILLE 704-878-5305 MOORESVILLE 704-664-5281

IMPROVEMENT PERMIT / AUTHORIZATION TO CONSTRUCT / OPERATION PERMIT / EXISTING SYSTEM INSPECTION

PERMIT# 135061 PIN# ~~4630004659~~ 4630132539 DATE 4-24-06

OWNER OR APPLICANT Chesapeake Pointe LLC / Orleans PHONE: Business 704-942-1250 Home

ADDRESS 7380 Mc Ginnis Ferry Rd Suwanee GA 30024

LOCATION Brawley School Rd TL Isle of Pines Rd TR Cove Creek Rd on left

SUBDIVISION Chesapeake Pt BLOCK / SECTION Ph 2 LOT 93 LOT AREA .69 Ac SITE CLASS. PS DESIGN FLOW 480gpd L.T.A.R. .3 gpd/ft²

Septic Tank: 1000 Gallons; STB 312 Date 6-23-08
Pump Tank: 1000 Gallons; PT 27 Date 8-4-08
Pump Make: Myers Model ME50SI Serial No.
Nitrification Field: No. Fields 1 Square Feet 1600 Linear Feet 270
No Lines 3@90 Trench Width 24" Max Trench Bottom Depth 36"

☒ New System ☐ Repair ☐ Expansion System Type: I II III IV V VI
System Description: LP PPBPS
Repair System Description: LP PPBPS
Maintenance Agreement Required: ☒ Yes ☐ No
Gravel Depth NA ☐ Gravity ☒ Pressure

☒ House/Mod. Home No. Bedrooms 4
☐ Mobile Home No. Persons
☐ Business No. Employees
☐ Other

Water Supply: ☐ Individual ☐ Public ☒ Community


☐ Slab ☒ Crawl Space ☐ Basement w/plumbing ☐ Basement wo/plumbing

Comments/Conditions: 62 Panels
shave terraces/berms before installation


Comments/Conditions: 7/11/08 Reviewed Floor plans In Compliance with original permit
9/10/08 Checked tanks
9/15/08 Checked lines
12/17/08 Elect & Alarm checked

1" = 50'

INITIAL SITE SKETCH

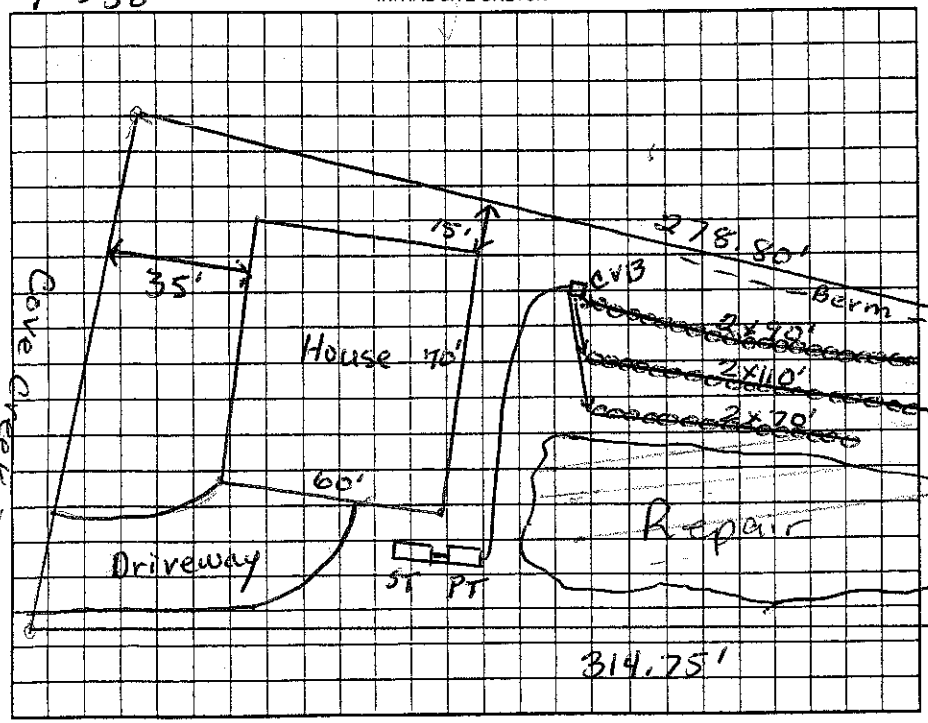

AS BUILT SKETCH

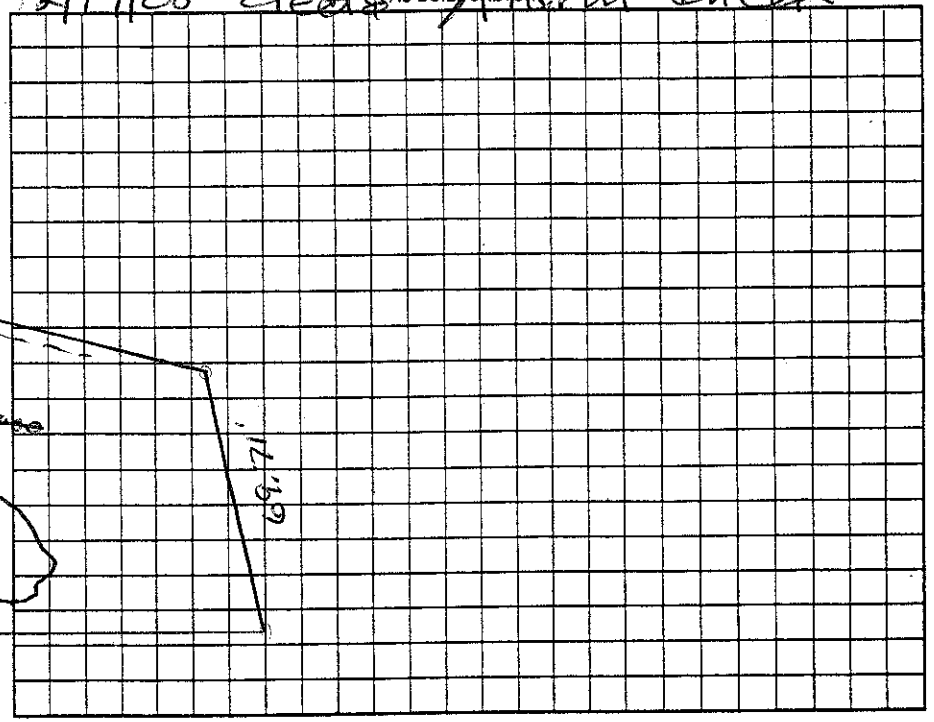

Permit can be suspended or revoked if any false information is supplied toward securing the permit/any unauthorized changes are made to the site/any unauthorized changes are made in the installation of the system. Improvement Permit with plat valid without expiration ☐ Improvement Permit with site plan valid for sixty months ☐ Authorization to Construct is valid for a period equal to that of Improvement Permit, not to exceed sixty months.

Signed: [signature] date 4-27-06 Installed by: Willie Christenbury

Improvement Permit by: Judy McNeill date 4-24-06 Operation Permit by: Maria H. Dotson RS date 12/17/08

Authorization to Construct by: Maria H. Dotson RS date 7-11-08 Existing System Inspection by: date

HEALTH DEPT. COPY: WHITE OWNER COPY (FINAL): YELLOW OWNER COPY (INITIAL): PINK