IREDELL COUNTY HEALTH DEPARTMENT

Statesville Office (704) 878-5305 Mooresville Office (704) 660-3625

IMPROVEMENT PERMIT / AUTHORIZATION TO CONSTRUCT / OPERATION PERMIT / EXISTING SYSTEM

PERMIT # 219204

PIN # 4636132657

APPLICANT: Stephen Russell

APPLICANT ADDRESS: 358 Cove Creek Lp Mooresville, NC 28117

SITE ADDRESS: 358 Cove Creek Lp, MRSVL

PHONE:

ALT. PHONE: 704 682-6562

SITE DIRECTIONS: Brawley School Rd TL Isle of Pines TR Cove Creek Lp house on left

SUBDIVISION: Chesapeake Pt

SECTION: 2 LOT # 93 LOT AREA: .69 Acre DESIGN FLOW: 480gpd L.T.A.R.: .3

Septic Tank	1000 (gal)	STB	Date		
Pump Tank	1000 (gal)	PT	Date		
Pump Make		Model	Serial #		
# Nitrification Fields	1	# Lines	3	Linear Ft:	270
Trench Width	24-36"	Max. Trench Bottom Depth	36"	Gravel Depth	

☐ New System ☐ Repair ☐ Expansion System Type: I II III IV V VI

System Description: Existing LPPBPS

Repair System Description: Same

Maintenance Agreement Required: ☒ YES ☐ NO ☐ GRAVITY ☒ PRESSURE

☒ Residence ☐ Business ☐ Other ☐ Slab ☐ Basement w/plumbing

No. Bedrooms 4 No. Persons 8 No. Employees


☒ Crawl Space ☐ Basement w/o plumbing

Water Supply: ☐ Private ☐ Public ☒ Community


Comments / Conditions: OK to Cantilever deck but must keep footers at least 5ft from Septic System. Deck can't extend over Septic System

* Current Septic Maintenance Agreement attached

INITIAL SITE SKETCH

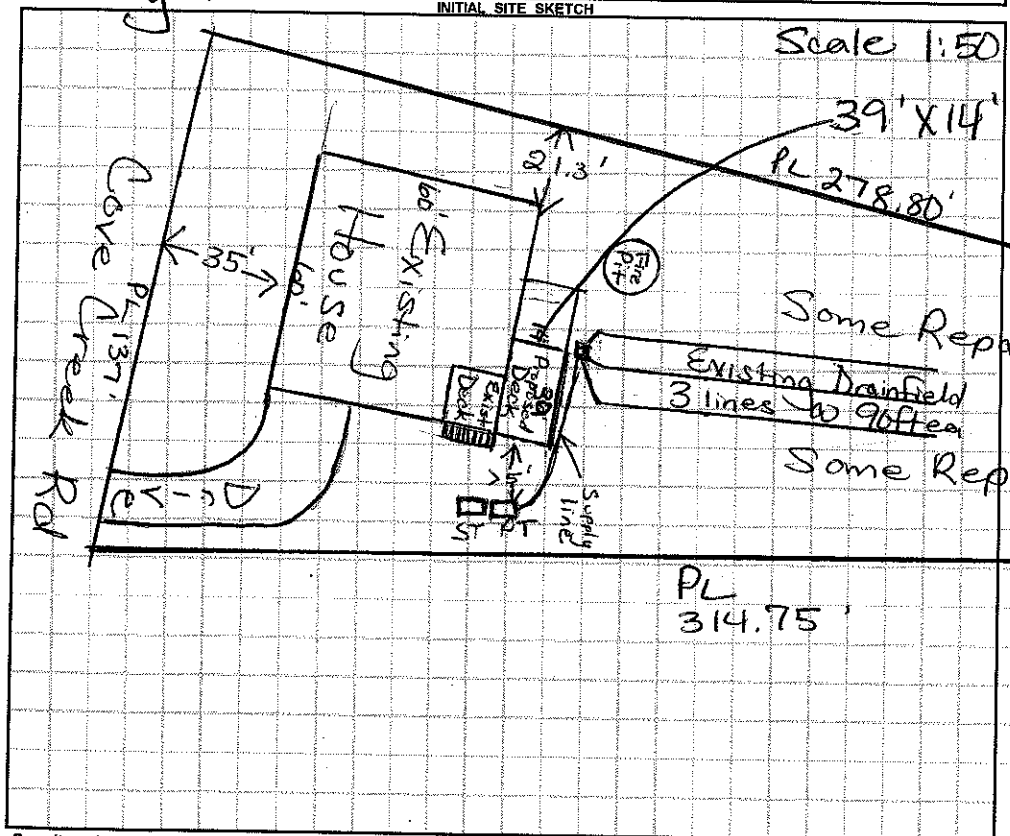

AS BUILT SKETCH

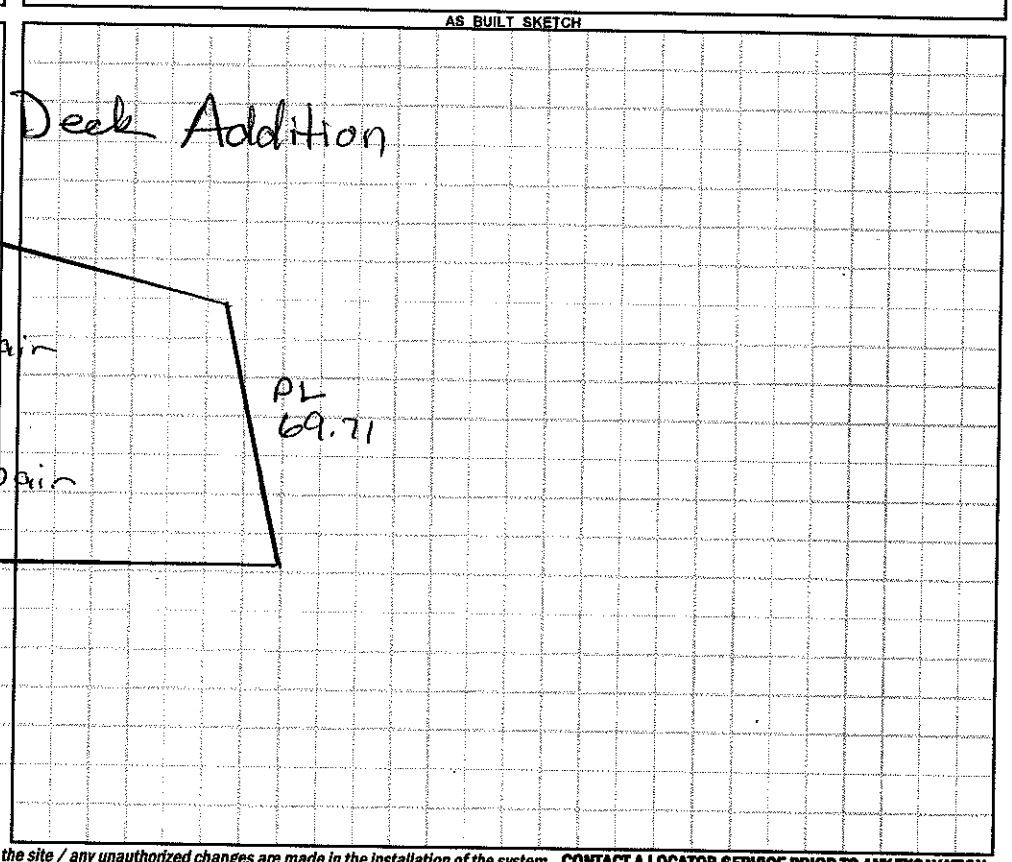

Permit can be suspended or revoked if any false information is supplied toward securing the permit / any unauthorized changes are made to the site / any unauthorized changes are made in the installation of the system. **CONTACT A LOCATOR SERVICE PRIOR TO ANY EXCAVATION**

☐ **IMPROVEMENT PERMIT** *with plat valid without expiration.* ☐ **IMPROVEMENT PERMIT** *with site plan valid for 60 mos.* ☐ **AUTHORIZATION TO CONSTRUCT** *valid for period equal to IMPROVEMENT PERMIT--not to exceed 60 mo.*

Owner / Applicant Signature: Laura Russell Date: 7-11-16

Installed by:

IMPROVEMENT PERMIT by: Date:

OPERATION PERMIT by: Date:

AUTHORIZATION TO CONSTRUCT by: Date:

Existing System Inspected by: Maria Dotson RS Date: 7/9/16

Health Dept. Copy - WHITE Applicant (Final Approval) - YELLOW Applicant (Conditional Approval) - PINK