IREDELL COUNTY HEALTH DEPARTMENT

Statesville Office (704) 878-5305 Mooresville Office (704) 660-3625 PERMIT # 208734

IMPROVEMENT PERMIT / AUTHORIZATION TO CONSTRUCT / OPERATION PERMIT / EXISTING SYSTEM

PIN # 4636-13-5048

APPLICANT: True Homes APPLICANT ADDRESS: 2649 Brekonridge Center Dr. Monroe, NC

SITE ADDRESS: 117 Farm Knoll Way Mooresville, NC PHONE: 704 283-1229 ALT. PHONE:

SITE DIRECTIONS: Brawley School Rd TL Isle of Pines TR Rock Ridge Pt TL Farm Knoll Way

SUBDIVISION: Rock Ridge Pt SECTION: LOT # 25 LOT AREA: .694c DESIGN FLOW: 600 gpd L.T.A.R.: .3

Septic Tank 1500 (gal) STB IM-1530 Date
Pump Tank 1500 (gal) PT IM-1530 Date
Pump Make Model Serial #
Nitrification Fields 1 # Lines 60 Linear Ft: 340
Trench Width min. 24" Max. Trench Bottom Depth 36" Gravel Depth N/A

☒ New System ☐ Repair ☐ Expansion System Type: I II III (IV) V VI
System Description: LP PPBPS
Repair System Description: LP PPBPS
Maintenance Agreement Required: ☒ YES ☐ NO
☐ GRAVITY ☒ PRESSURE


☒ Residence No. Bedrooms 5
☐ Business No. Persons 10
☐ Other No. Employees
☐ Slab ☐ Crawl Space
☒ Basement w/plumbing ☐ Basement w/o plumbing

Water Supply: ☐ Private ☐ Public ☒ Community


Comments / Conditions:

INITIAL SITE SKETCH

See attached / approved plan by Septic Environmental Solutions, Inc. (dated 2/11/16, approved 2/24/16)

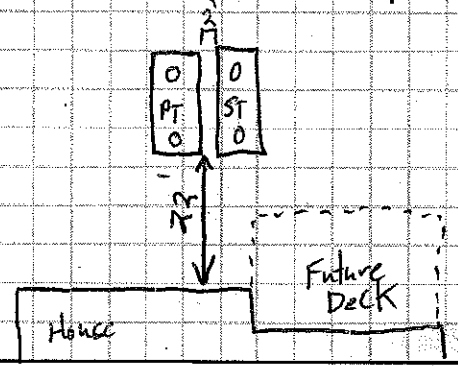

AS BUILT SKETCH

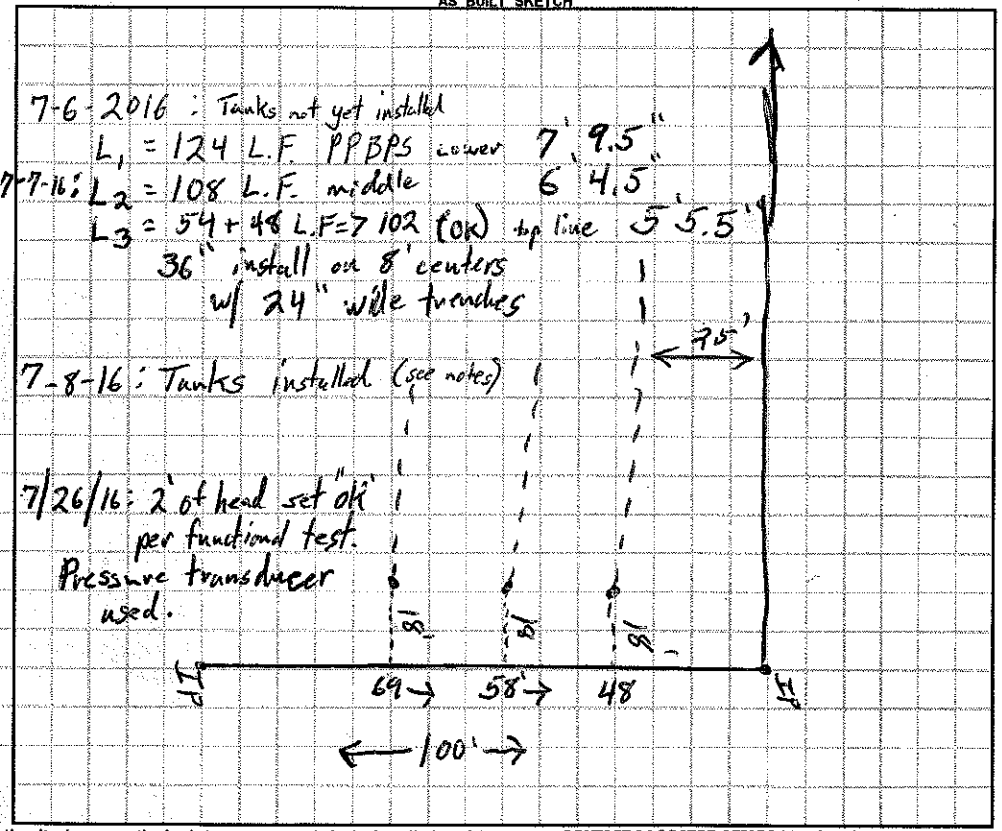

Permit can be suspended or revoked if any false information is supplied toward securing the permit / any unauthorized changes are made to the site / any unauthorized changes are made in the installation of the system. **CONTACT A LOCATOR SERVICE PRIOR TO ANY EXCAVATION**


☐ **IMPROVEMENT PERMIT** *with plat* valid without expiration. ☒ **IMPROVEMENT PERMIT** *with site plan* valid for 60 mos. ☒ **AUTHORIZATION TO CONSTRUCT** valid for period equal to IMPROVEMENT PERMIT--not to exceed 60 mo.

Owner / Applicant Signature: Date: 3-3-16 Installed by: Sid Gaskins

IMPROVEMENT PERMIT by: Date: 2/24/16 OPERATION PERMIT by: Date: 8-3-16

AUTHORIZATION TO CONSTRUCT by: Date: 2/24/16 Existing System Inspected by: Date:

Health Dept. Copy - WHITE Applicant (Final Approval) - YELLOW Applicant (Conditional Approval) - PINK

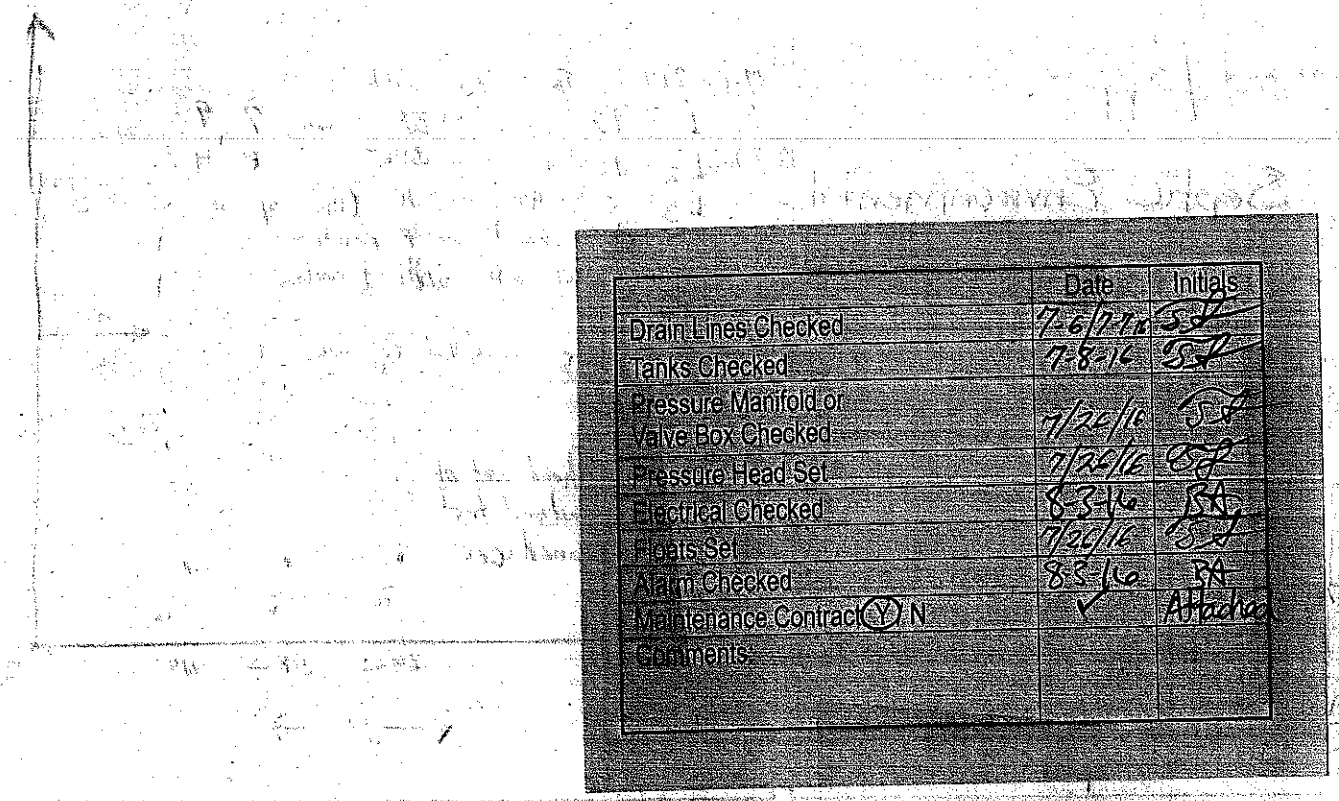

	Date	Initials
Drain Lines Checked	7-6/7-12	SH
Tanks Checked	7-8-16	SH
Pressure Manifold or Valve Box Checked	7/22/16	SH
Pressure Head Set	7/22/16	SH
Electrical Checked	8-3-16	BA
Floats Set	7/20/16	SH
Alarm Checked	8-3-16	BA
Maintenance Contract (Y) N	✓	Attached
Comments:		

ROCKRIDGE POINT SUBDIVISION

