IREDELL COUNTY HEALTH DEPARTMENT

Statesville Office (704) 878-5305 Mooresville Office (704) 660-3625 PERMIT # 208739

IMPROVEMENT PERMIT / AUTHORIZATION TO CONSTRUCT / OPERATION PERMIT / EXISTING SYSTEM

PIN # 4636135675 ✓

APPLICANT: True Homes APPLICANT ADDRESS: 2649 Brekonridge Ctr Dr Monroe, NC

✓ SITE ADDRESS: 147 Farm Knoll Way Mooresville, NC PHONE: ALT. PHONE: 704-283-1229

SITE DIRECTIONS: Brawley School Rd TL Isle of Pines TR Rock Ridge Pointe Dr.

✓ SUBDIVISION: Rock Ridge Pt. SECTION: LOT # 29 LOT AREA: .69 Acre DESIGN FLOW: 480gpd L.T.A.R.: .3

Septic Tank: Min. 1000 (gal)	SIB: 2111	Date: 5-9-16	☒ New System ☐ Repair ☐ Expansion	System Type: I II (III) IV V VI	☒ Residence	No. Bedrooms: 4	Water Supply: ☐ Private
Pump Tank: — (gal)	PT: —	Date: —	System Description: Gravity – 25% Reduction		☐ Business	No. Persons: 8	☒ Public
Pump Make: —	Model: —	Serial #: —	Repair System Description: LRJPPBPS		☐ Other	No. Employees:	☐ Community
# Nitrification Fields: 1	# Lines: 5	Linear Ft: 400'	Maintenance Agreement Required: ☐ YES ☒ NO		☐ Slab	☒ Crawl Space	
Trench Width: 36"	Max. Trench Bottom Depth: 36"	Gravel Depth: N/A	☒ GRAVITY ☐ PRESSURE		☐ Basement w/ plumbing	☐ Basement w/o plumbing	

Comments / Conditions: Shave off old berms in Septic area
* 1500 gallon tank required per plan *
Recommend septic tank be pumped every 3-5 years


INITIAL SITE SKETCH

See attached/approved design by Septic Environmental Solutions (dated 3-28-16)

AS BUILT SKETCH

9-15-16: 1000-gallon top seam Gamewell septic tank w/ a Polylok PL-68 Filter

L_1 = 83 4'6" OK
L_2 = 88 5'8" OK
L_3 = 82 3'6" ← moved laser OK
L_4 = 78 5'0" OK
L_5 = 76 6'5" OK

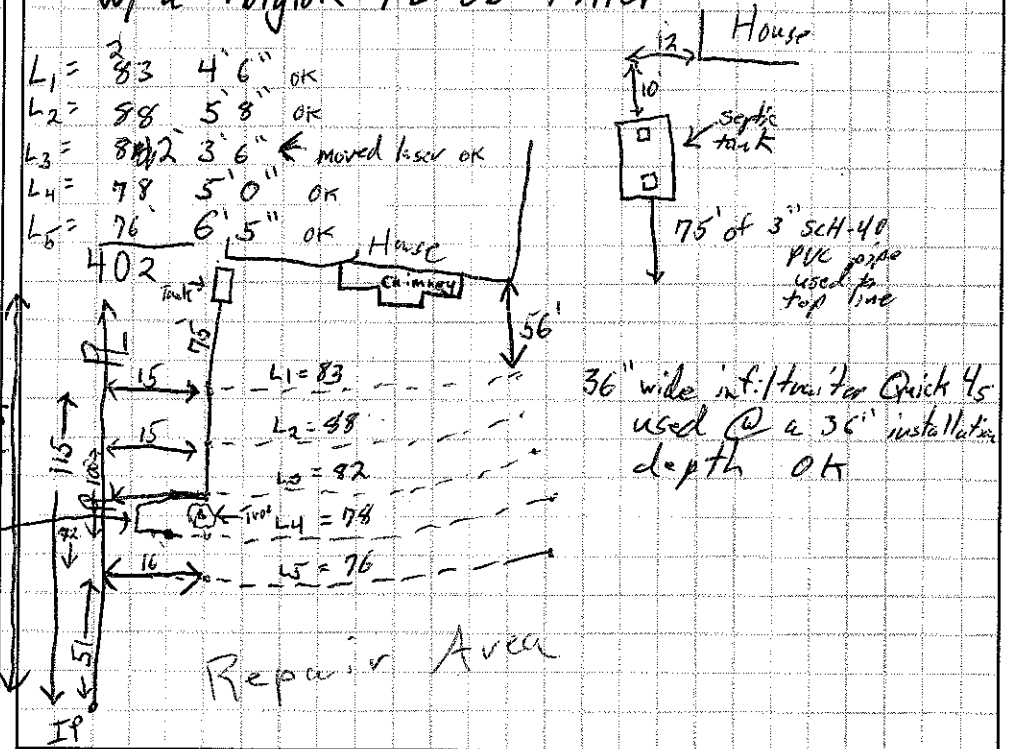

Permit can be suspended or revoked if any false information is supplied toward securing the permit / any unauthorized changes are made to the site / any unauthorized changes are made in the installation of the system. **CONTACT A LOCATOR SERVICE PRIOR TO ANY EXCAVATION**

☐ **IMPROVEMENT PERMIT** *with plat valid without expiration.* ☒ **IMPROVEMENT PERMIT** *with site plan valid for 60 mos.* ☒ **AUTHORIZATION TO CONSTRUCT** *valid for period equal to IMPROVEMENT PERMIT--not to exceed 60 mo.*


Owner / Applicant Signature: Date: 4/19/16 Installed by: Sid Gaskins

IMPROVEMENT PERMIT by: Date: 4/8/16 OPERATION PERMIT by: Tom Shuck Date: 9-20-2016

AUTHORIZATION TO CONSTRUCT by: Date: 6-13-16 Existing System Inspected by: Date:

Health Dept. Copy - WHITE Applicant (Final Approval) - YELLOW Applicant (Conditional Approval) - PINK

ROCKRIDGE POINT SUBDIVISION

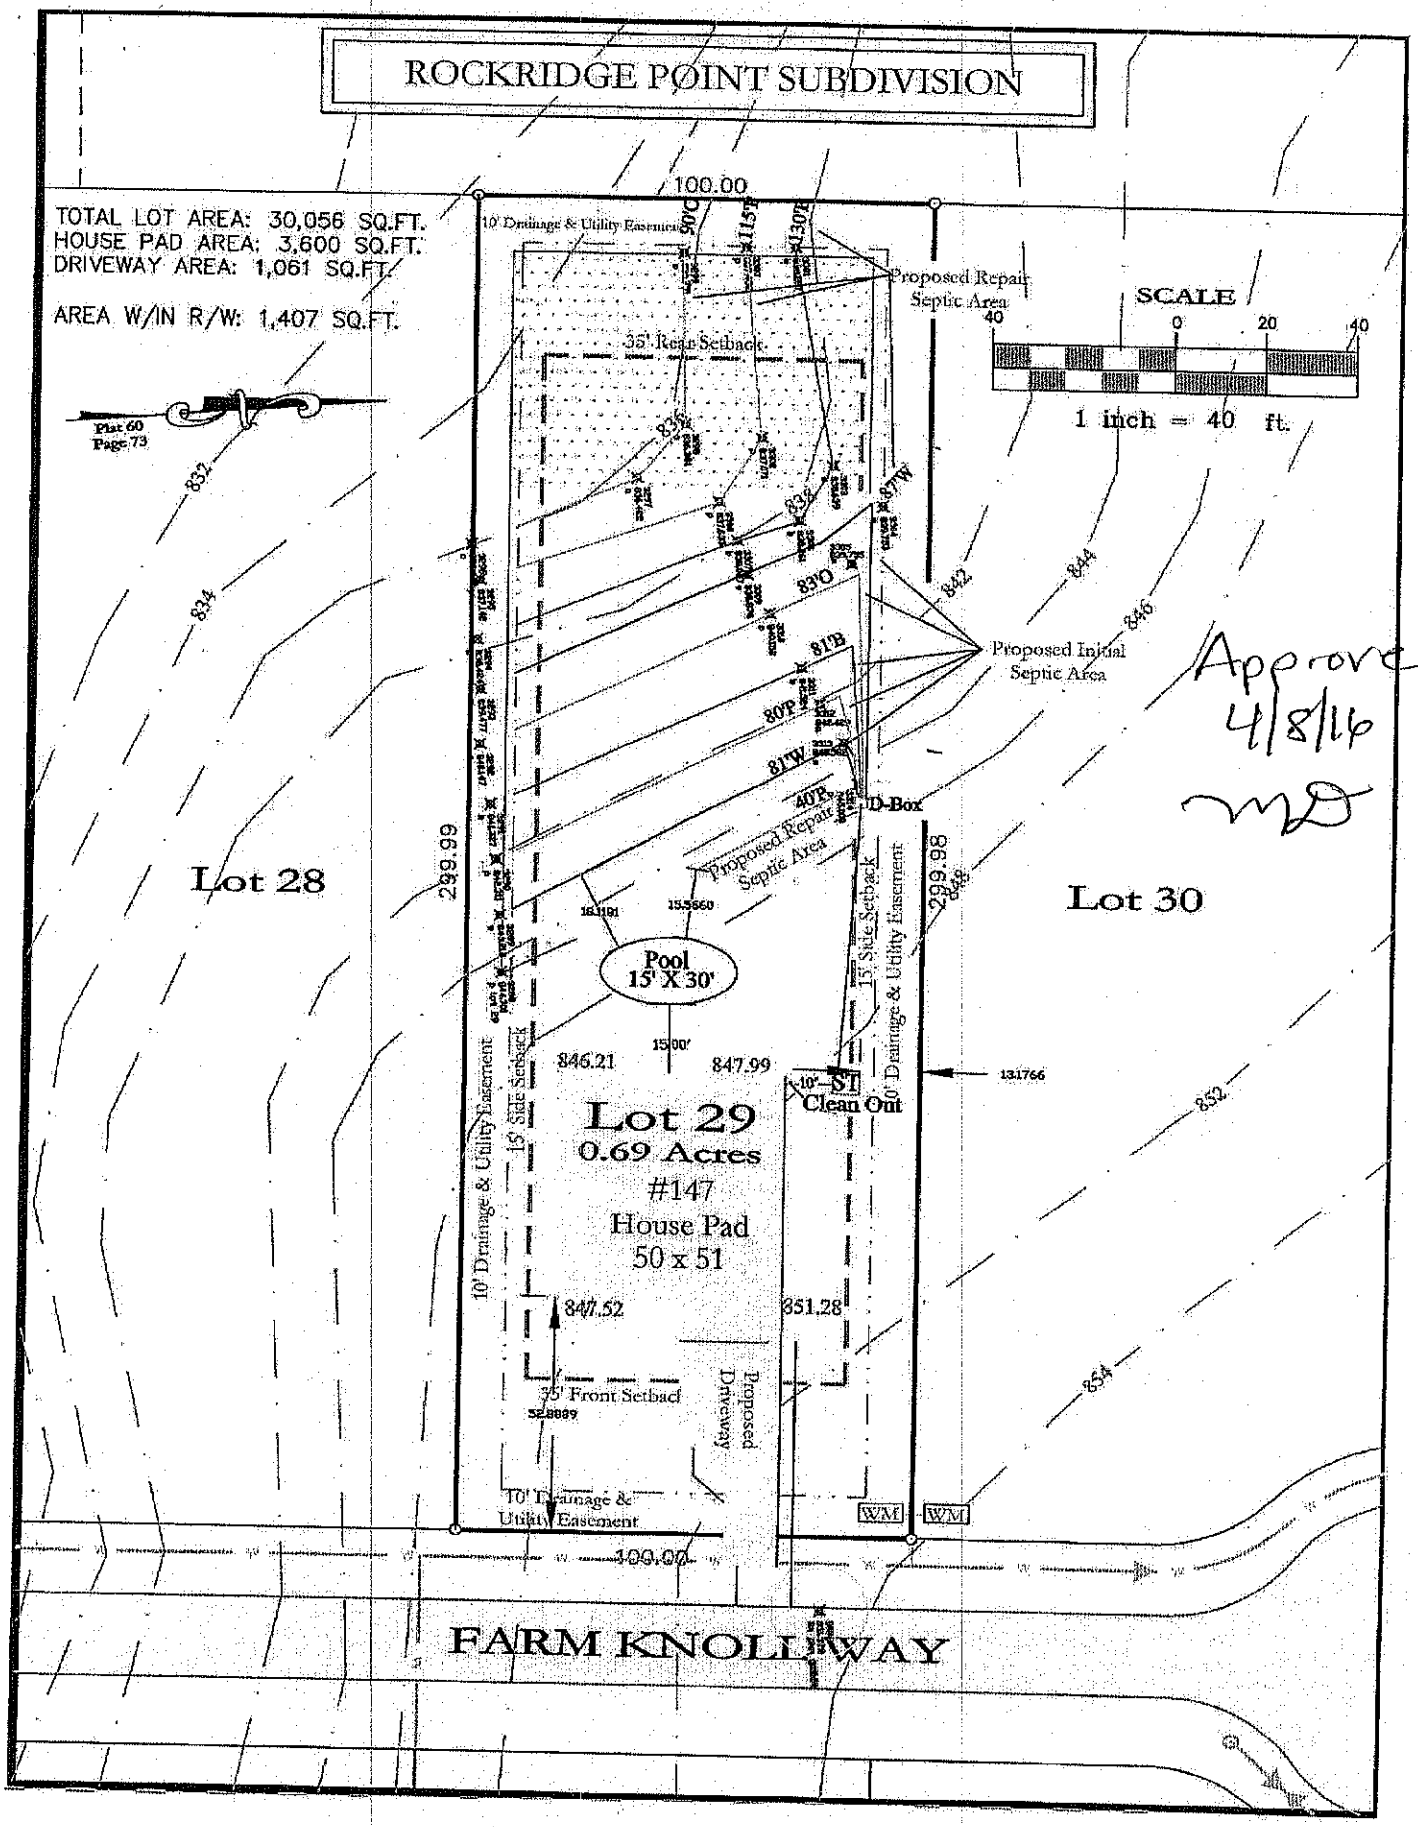

Approved
4/8/16
MD