IREDELL COUNTY HEALTH DEPARTMENT

Statesville Office (704) 878-5305 Mooresville Office (704) 660-3625

Old # 133695

PERMIT # 208740

IMPROVEMENT PERMIT / AUTHORIZATION TO CONSTRUCT / OPERATION PERMIT / EXISTING SYSTEM

PIN # 4636-13-5785

APPLICANT: True Homes APPLICANT ADDRESS: 2649 Beekon Ridge Centra Dr.

SITE ADDRESS: 151 Farm Knoll Way - Mooresville PHONE: 704-283-1229 ALT. PHONE:

SITE DIRECTIONS: Isle of Pines, TR Rock Ridge, TR Farm Knoll, on L

SUBDIVISION: Rock Ridge Point SECTION: — LOT # 30 LOT AREA: .171 AC DESIGN FLOW: 480 L.T.A.R.: .3

Septic Tank 1500 (gal) STB 2111 Date 2-1-16

Pump Tank 1500 (gal) PT 2111 Date

Pump Make Model Serial #

Nitrification Fields 1 # Lines 2@140' Linear Ft: 280'

Trench Width 24" Max. Trench Bottom Depth 36" Gravel Depth —

☒ New System ☐ Repair ☐ Expansion System Type: I II III (IV) V VI

System Description: LP- Panel Block

Repair System Description: Same

Maintenance Agreement Required: ☒ YES ☐ NO

☐ GRAVITY ☒ PRESSURE

☒ Residence No. Bedrooms 4

☐ Business No. Persons

☐ Other No. Employees

☐ Slab ☒ Crawl Space

☐ Basement w/plumbing ☐ Basement w/o plumbing

Water Supply: ☐ Private ☐ Public ☒ Community

Comments / Conditions:


7/1/16 Checked tanks & lower drainline MD

INITIAL SITE SKETCH

See Plan From Kenny Owens

AS BUILT SKETCH

7/6/16 L1 39' + 83' => 122' -5' ✱
L2 checked by Maria [150' per installer]
ST is a double precast top-seam conc tank. IP
w/a PL-68 Filter.

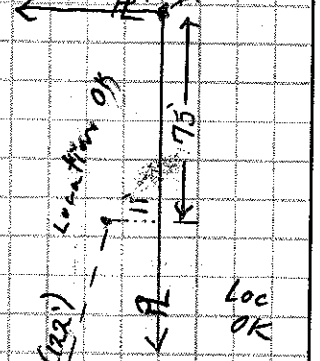

7/26/16: 2' Pressure head set on lines

✱ Power must be run to electrical box

7/28/16: Electrical Failed (2x). Electrical Box OK.

7/29/16: Alarm OK. Floats OK. Control Panel OK. -5

Permit can be suspended or revoked if any false information is supplied toward securing the permit / any unauthorized changes are made to the site / any unauthorized changes are made in the installation of the system. **CONTACT A LOCATOR SERVICE PRIOR TO ANY EXCAVATION**

☐ **IMPROVEMENT PERMIT** *with plat valid without expiration.* ☒ **IMPROVEMENT PERMIT** *with site plan valid for 60 mos.* ☒ **AUTHORIZATION TO CONSTRUCT** *valid for period equal to IMPROVEMENT PERMIT--not to exceed 60 mo.*

Owner / Applicant Signature:

IMPROVEMENT PERMIT by: Date: 4/11/16

AUTHORIZATION TO CONSTRUCT by: APPROVED Date: MAR 28 2016

APPROVED MAR 29 2016 Date:


Installed by: Sid Gaskins

OPERATION PERMIT by: Tom Shuck Date: 7/29/16

Existing System Inspected by: Date:

Health Dept. Copy - WHITE Applicant (Final Approval) - YELLOW Applicant (Conditional Approval) - PINK

ROCKRIDGE POINT SUBDIVISION

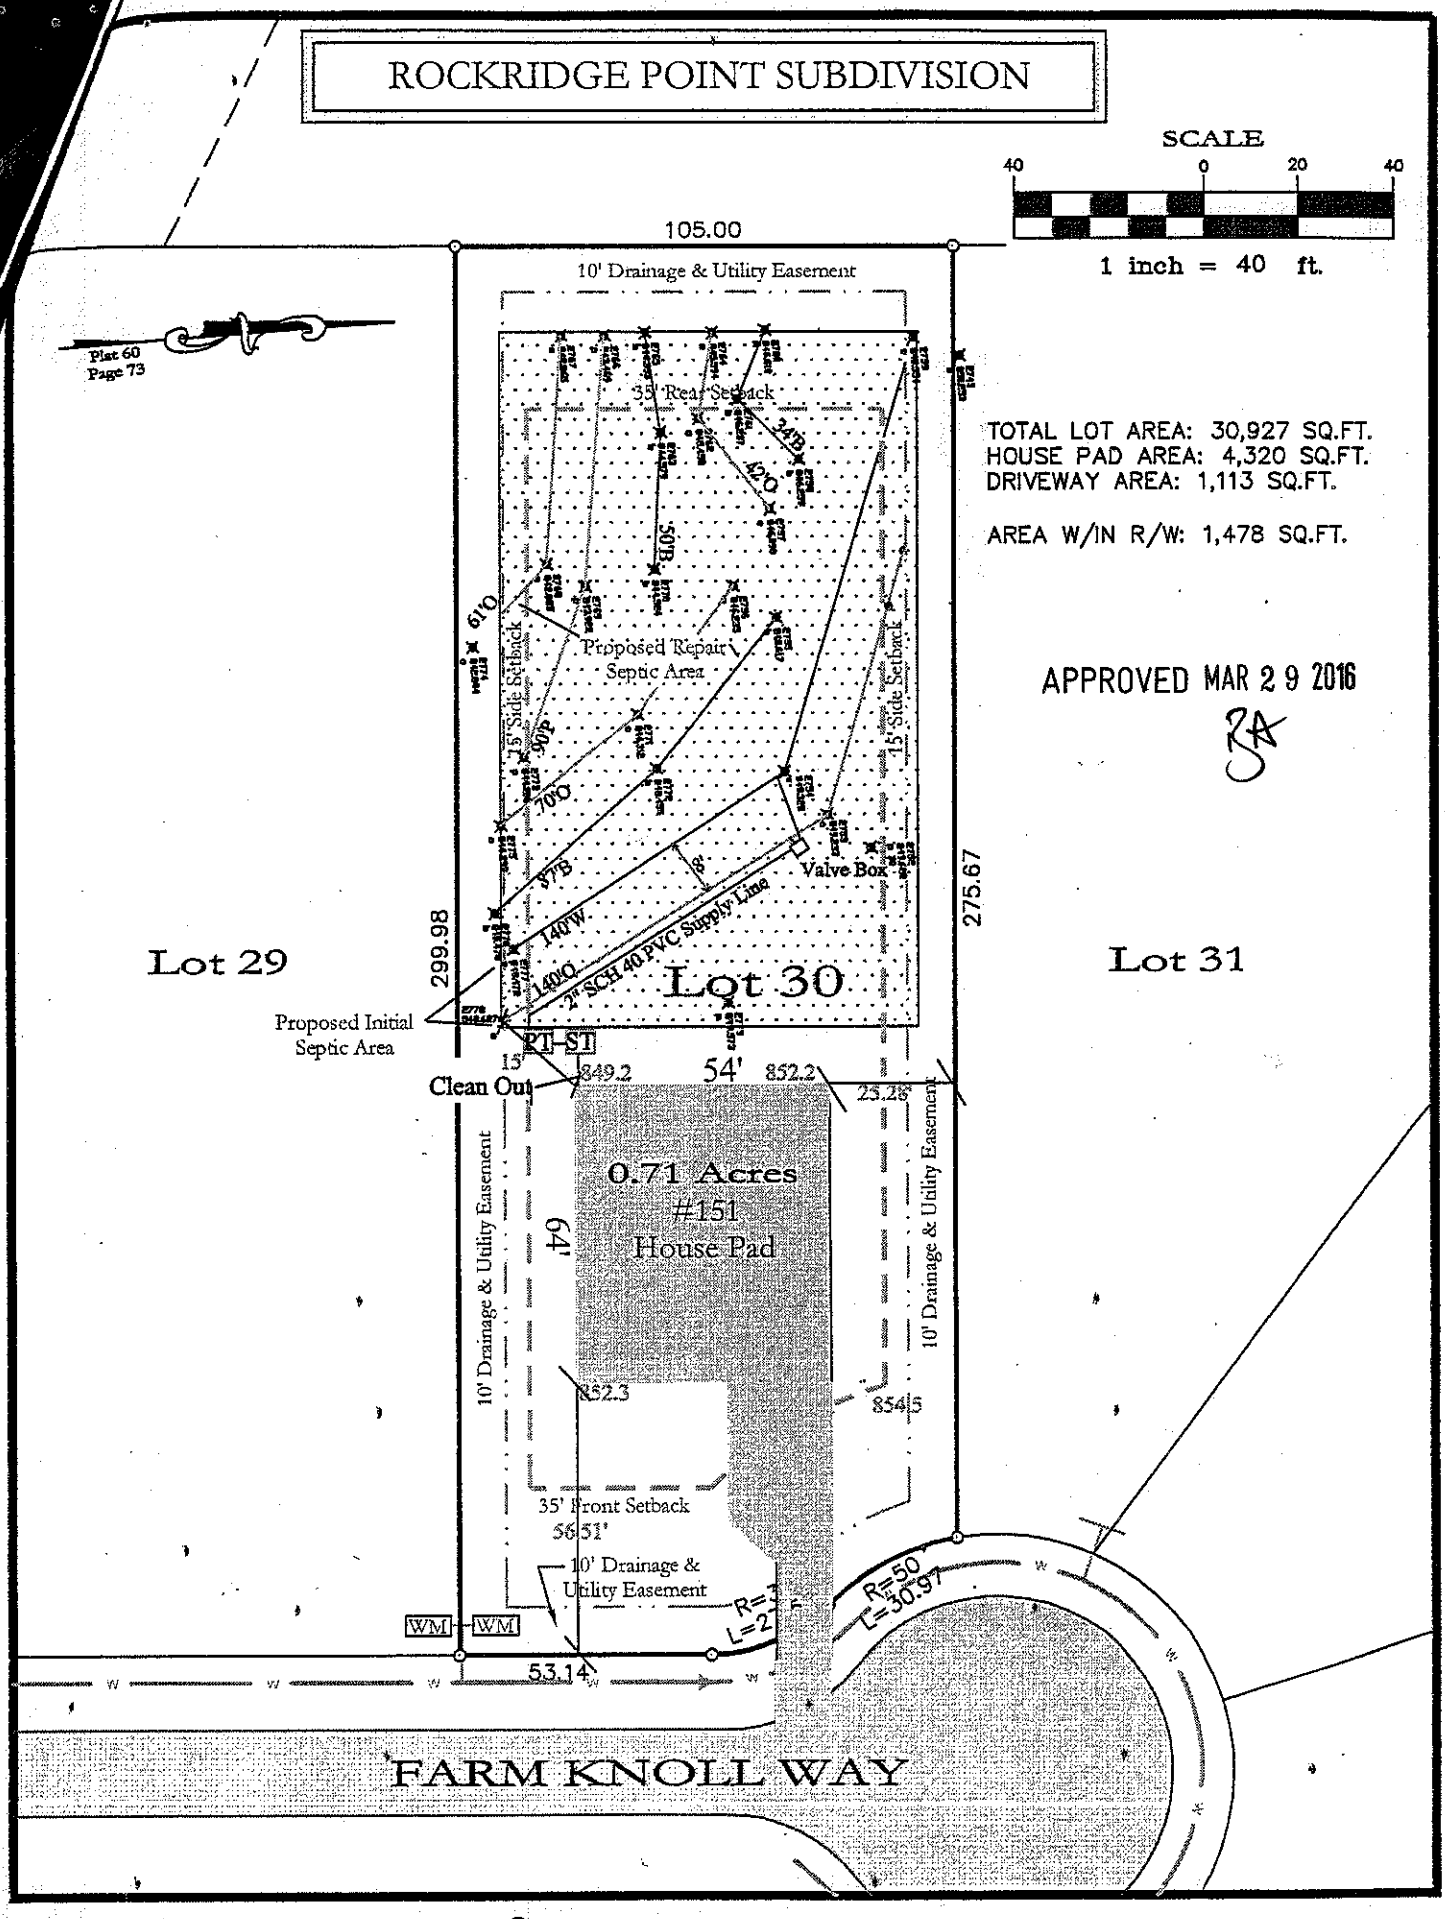

Revised 3-14-16