IREDELL COUNTY HEALTH DEPARTMENT

STATESVILLE 704-878-5305 MOORESVILLE 704-664-5281

IMPROVEMENT PERMIT / AUTHORIZATION TO CONSTRUCT / OPERATION PERMIT / EXISTING SYSTEM INSPECTION

PERMIT# 133705 PIN# ~~4636-23-3131.034~~ 4636 138995 DATE March 24, 06

OWNER OR APPLICANT Digest Enterprises PHONE: Business 704 309 0123 Home

ADDRESS 2125 Sharon Ln. Charlotte, N.C. 28211

LOCATION Brawley Sch Rd. TL Lake of Pines TR Rocky Farm Rd e to end TR Farm Knoll Ln. to end L 154 Farm Knoll Way

SUBDIVISION Rocky Ridge PI BLOCK / SECTION LOT 34 LOT AREA .69 Ac SITE CLASS. RS DESIGN FLOW 460 gpd L.T.A.R. .025

Septic Tank: * 1500 Gallons; STB 338 Date 3-10-14

Pump Tank: * 1500 Gallons; PT 477 Date 3-10-14

Pump Make: ZOELLER Model N152 Serial No.

Nitrification Field: No Fields 1 Square Feet 640 Linear Feet 320

No Lines 5 Trench Width 24" min 8'oc Max Trench Bottom Depth 36"

☒ New System ☐ Repair ☐ Expansion System Type: I II III IV V VI

System Description: LPP RBPS

Repair System Description: LPP RBPS

Maintenance Agreement Required: ☒ Yes ☐ No

☒ House/Mod. Home No. Bedrooms 4

☐ Mobile Home No. Persons

☐ Business No. Employees

☐ Other

Water Supply: ☐ Individual ☒ Public ☒ Community

Gravel Depth NA ☐ Gravity ☒ Pressure ☐ Slab ☒ Crawl Space ☐ Basement w/plumbing ☐ Basement wo/plumbing


Comments/Conditions: * PER Plan Specs
Show if any old burnt in septic system area

Comments/Conditions:

INITIAL SITE SKETCH

SEE Plan from S&ME

AS BUILT SKETCH

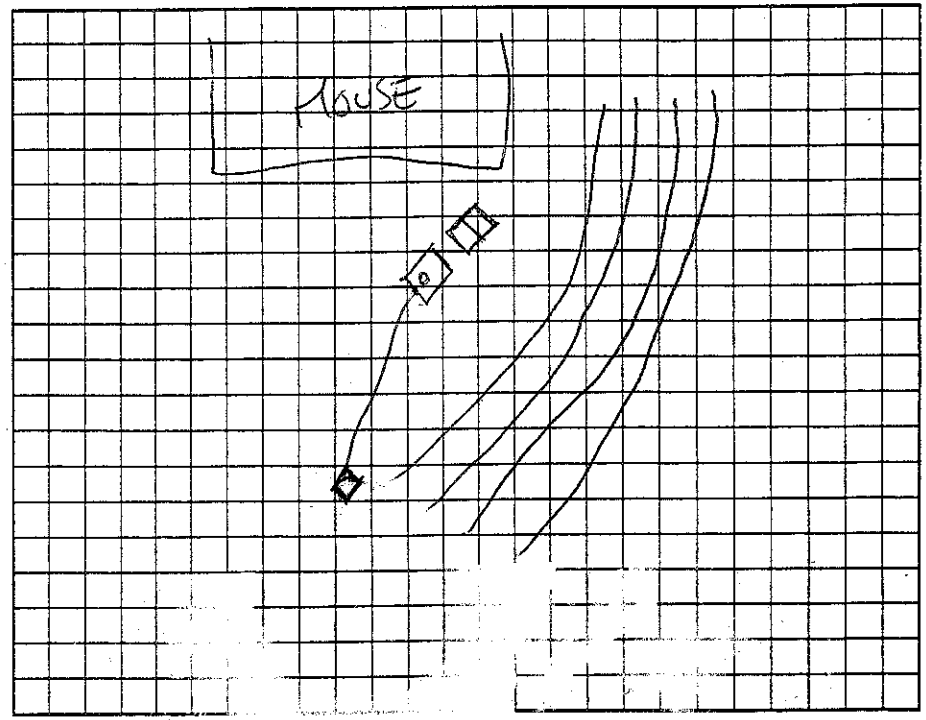

Permit can be suspended or revoked if any false information is supplied toward securing the permit/any unauthorized changes are made to the [illegible] in the installation of the system. Improvement Permit with plat valid without expiration ☐ Improvement Permit with site plan valid for sixty months ☒ Authorization to Construct is valid for a period equal to that of Improvement Permit – not to exceed sixty months.

Signed: Robert B. Frost date 4/11/06

Improvement Permit by: [signature] date 3-24-06


Authorization to Construct by: [signature] date 9/4/14

Installed by: OVERBY

Operation Permit by: [signature] for BA date 6-18-14

Existing System Inspection by: date

HEALTH DEPT. COPY: WHITE OWNER COPY (FINAL): YELLOW OWNER COPY (INITIAL): PINK

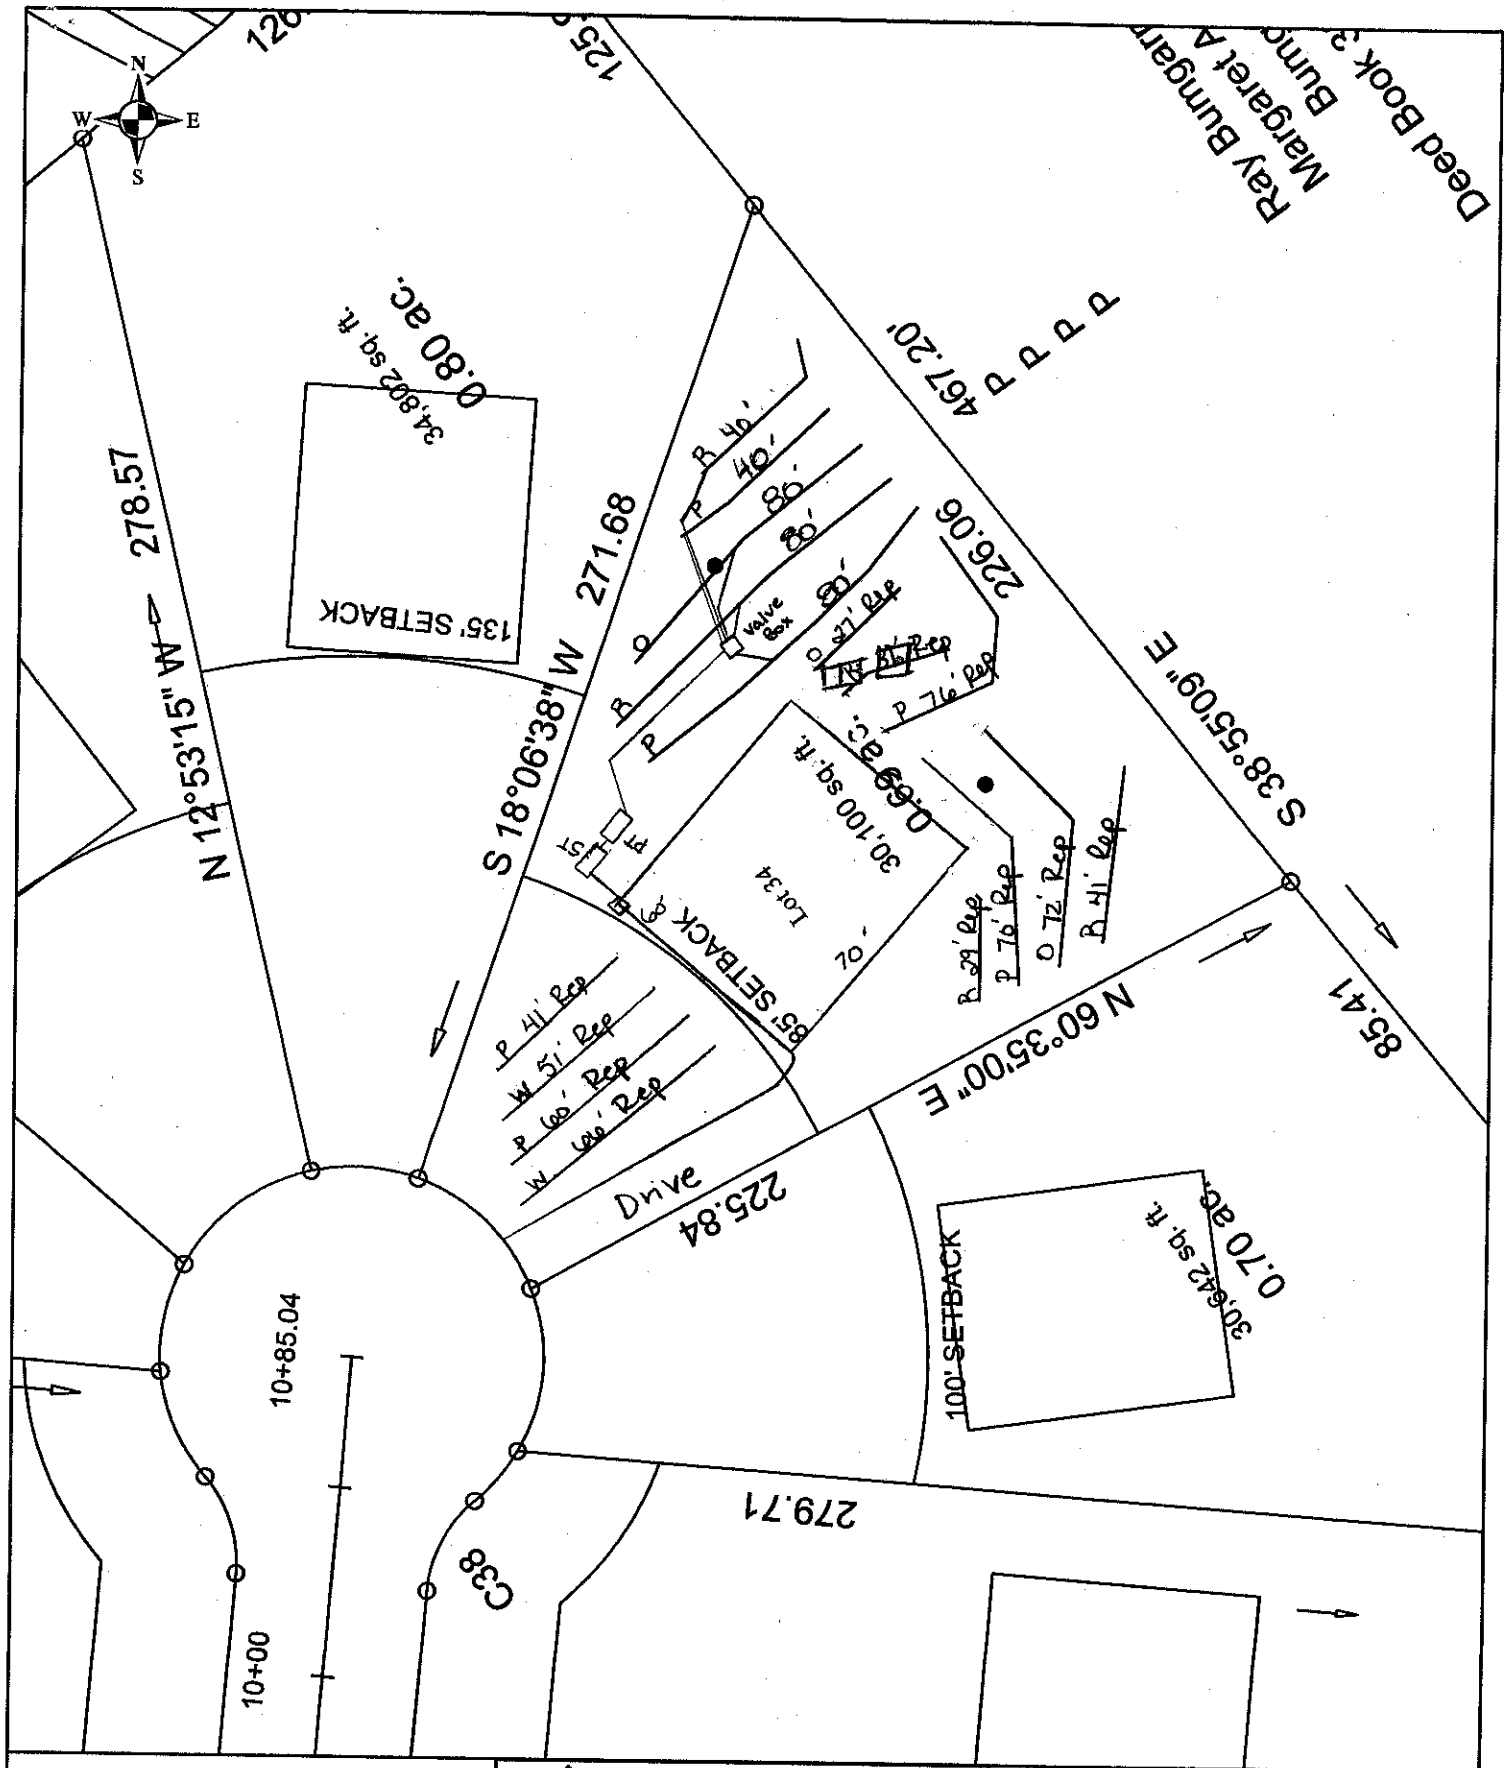

Scale: 1 inch equals 50 feet	S&ME	Rocky Ridge - Lot 34	FIGURE
Drawn by: JBP		Scaled Detailed Site Plan	1
Reviewed by: PGP		Iredell County, NC	
Date: February, 2006	ENVIRONMENTAL SERVICES • ENGINEERING • TESTING	S&ME Project #1588-05-081	

ROCKRIDGE POINT SUBDIVISION

TOTAL LOT AREA: 30,056 SQ.FT.
HOUSE PAD AREA: 4,320 SQ.FT.
DRIVEWAY AREA: 1,847 SQ.FT.

AREA W/IN R/W: 333 SQ.FT.

SCALE
40 0 20 40
1 inch = 40 ft.

