IREDELL COUNTY HEALTH DEPARTMENT

STATESVILLE 704-878-5305 MOORESVILLE 704-664-5281

IMPROVEMENT PERMIT / AUTHORIZATION TO CONSTRUCT / OPERATION PERMIT / EXISTING SYSTEM INSPECTION

PERMIT# 13394 20911 PIN# 4636233131.039 4636139401 DATE March 21, 06

OWNER OR APPLICANT Joseph Enterprises PHONE: Business 704 309 0123 Home

ADDRESS 2125 Sharon Rd, Charlotte N.C. 28211

LOCATION Brawley School Rd to end of Pines TR Rocky Farm Rd to end TR Farm Knoll Ln. 3rd lot on Right

SUBDIVISION Rocky Ridge PT BLOCK / SECTION LOT 39 LOT AREA .67 ac SITE CLASS. PS DESIGN FLOW 480 gpd L.T.A.R. .3

Septic Tank: 1500 * Gallons; STB 444 Date 3-10-14
Pump Tank: 1500 * Gallons; PT 477 Date 7-9-14
Pump Make: ZOELLER Model N152 Serial No.
Nitrification Field: No Fields 1 Square Feet 1200 Linear Feet 400
No Lines 3@80' Trench Width 36" Max Trench Bottom Depth 36" Gravel Depth NA ☐ Gravity ☒ Pressure

☒ New System ☐ Repair ☐ Expansion System Type: I II IIIa IV V VI
System Description: pm 25% Reduction
Repair System Description: LPPPBRS
Maintenance Agreement Required: ☐ Yes ☒ No Initially

☒ House/Mod. Home No. Bedrooms 4
☐ Mobile Home No. Persons
☐ Business No. Employees
☐ Other

Water Supply: ☐ Individual ☒ Public ☒ Community

☐ Slab ☒ Crawl Space ☐ Basement w/plumbing ☐ Basement wo/plumbing

Comments:/Conditions: * PER Plan Specs
Shave off any old burnes in septic system area.

Comments:/Conditions:

INITIAL SITE SKETCH

SEE Plan from State

AS BUILT SKETCH

INSTALLED QUICK-I WITH GRAVEL ALONG THE SIDES.

CHECKED TANKS & LINES

CHECKED PM 4-17-14

PENDING


Permit can be suspended or revoked if any false information is supplied toward securing the permit/any unauthorized changes are made to the site/any unauthorized changes are made in the installation of the system. Improvement Permit with plat valid without expiration ☐ Improvement Permit with site plan valid for sixty months ☒ Authorization to Construct is valid for a period equal to that of Improvement Permit – not to exceed sixty months.

Signed: Robert B. Thrust date 4/11/06 Installed by: OVERBY


Improvement Permit by: date 3-21-06 Operation Permit by: date APPROVED MAY 14 2014

Authorization to Construct by: date 1-8-14 Existing System Inspection by: date

HEALTH DEPT. COPY: WHITE OWNER COPY (FINAL): YELLOW OWNER COPY (INITIAL): PINK

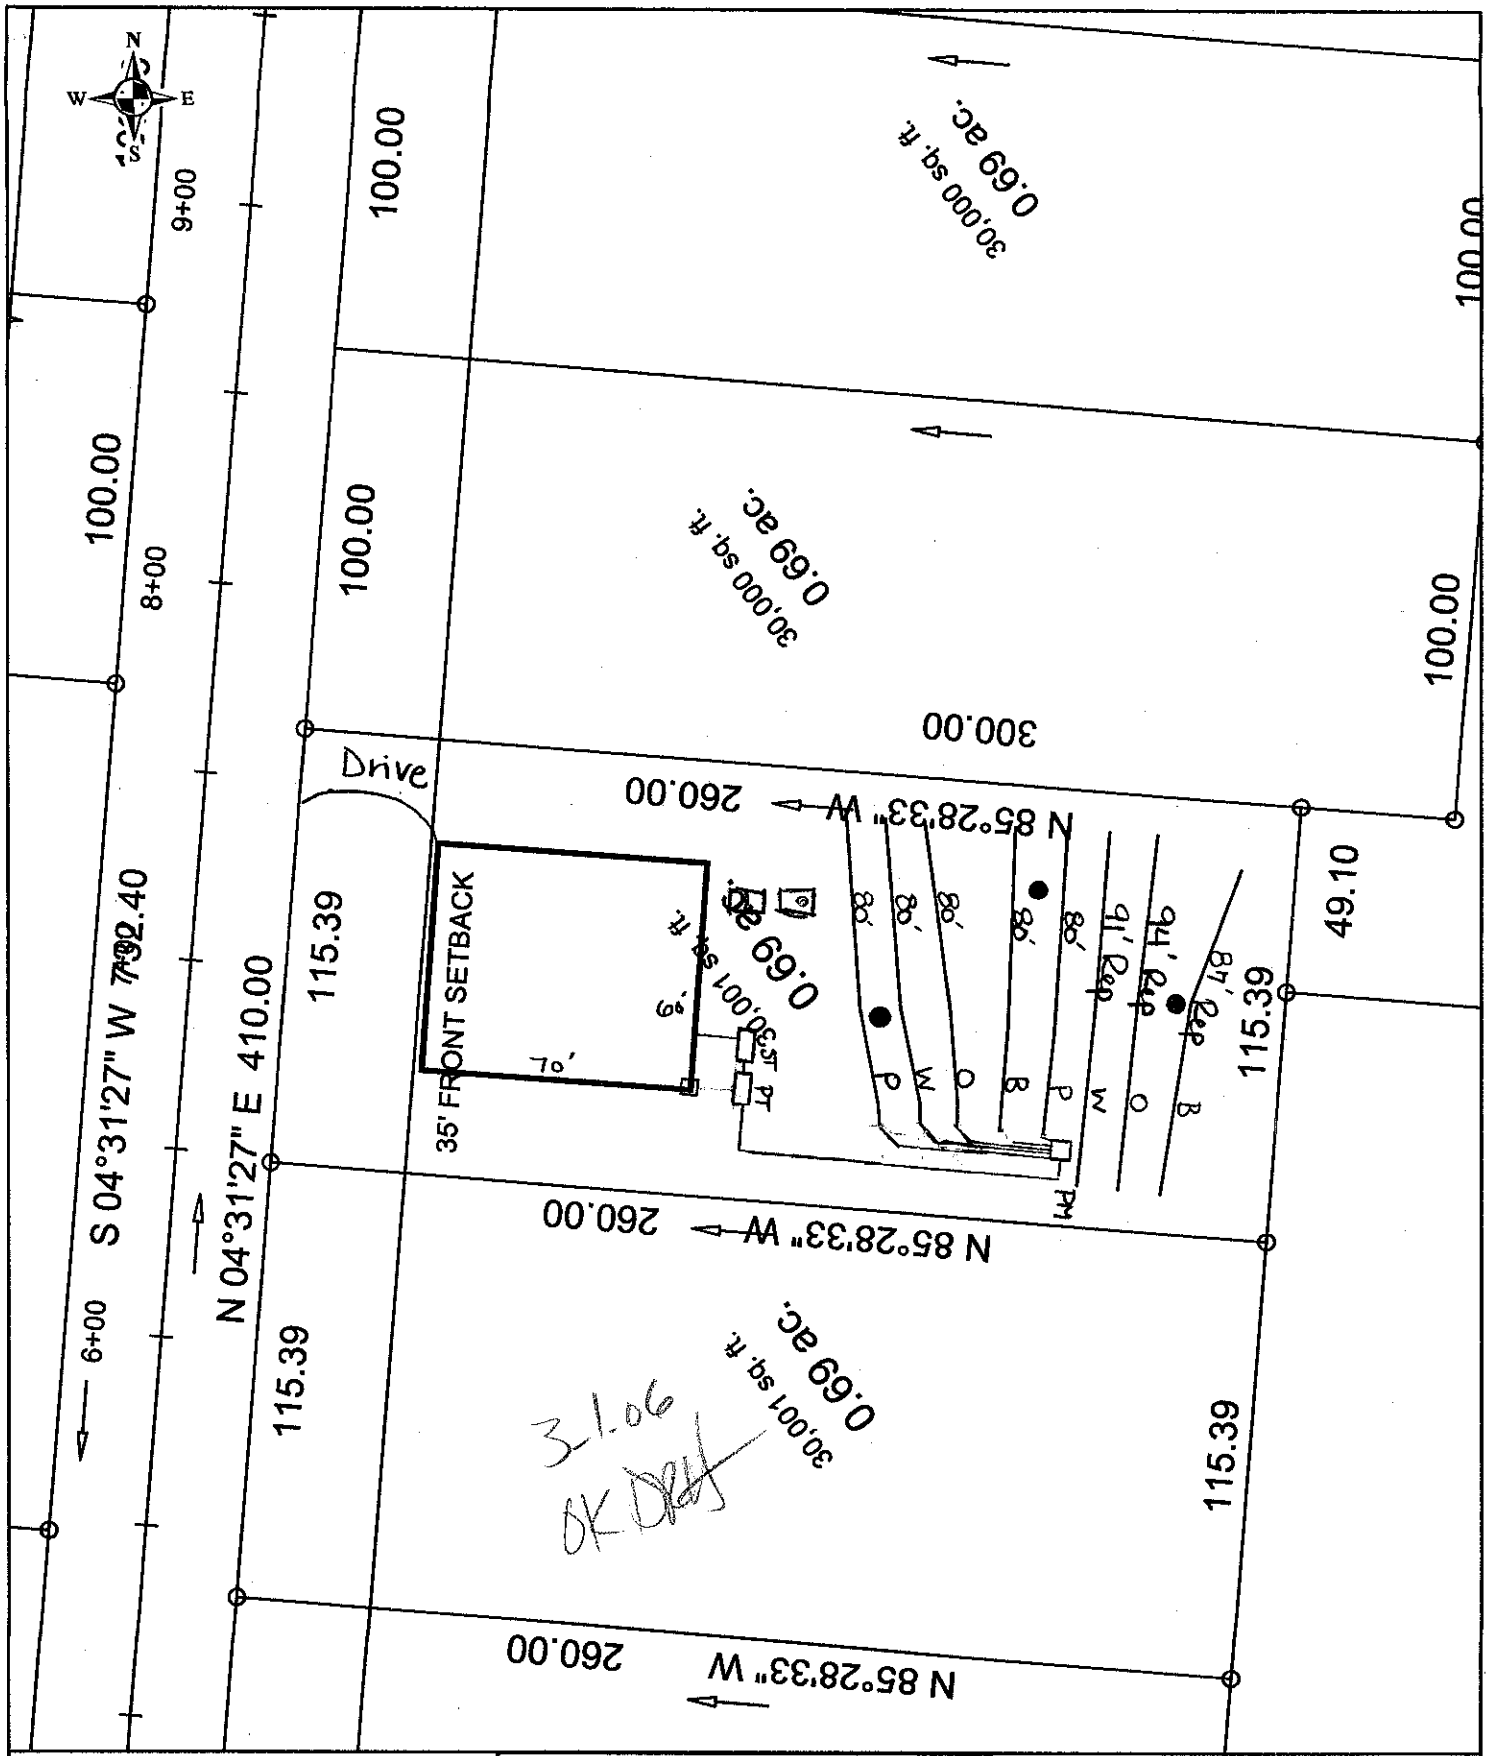

Scale: 1 inch equals 50 feet	S&ME	Rocky Ridge - Lot 39	FIGURE
Drawn by: JBP		Scaled Detailed Site Plan	1
Reviewed by: PGP		Iredell County, NC	
Date: January, 2006	ENVIRONMENTAL SERVICES • ENGINEERING • TESTING	S&ME Project #1588-05-081	

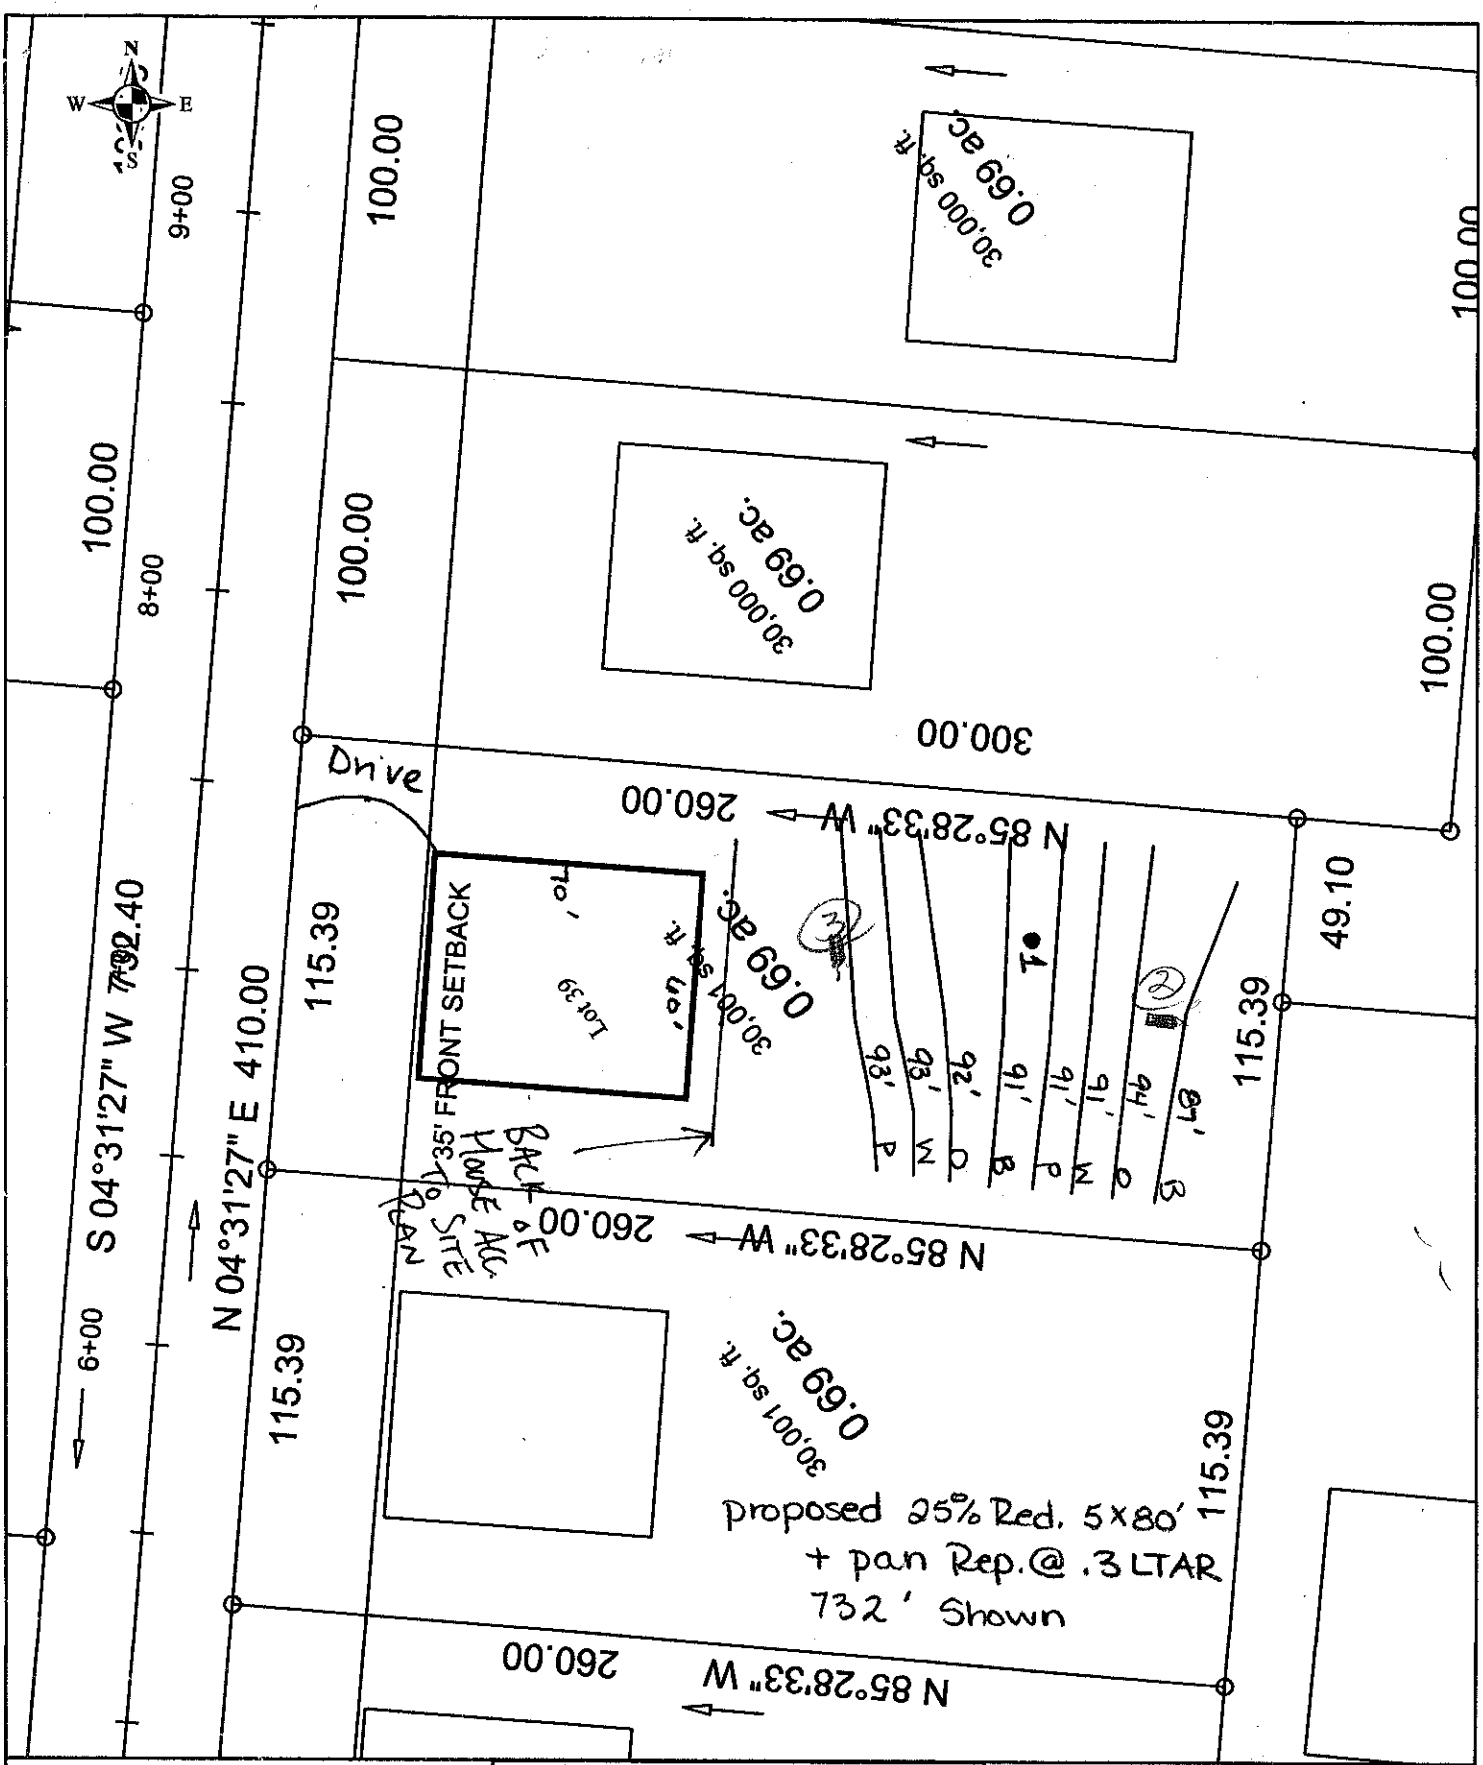

Scale: 1 inch equals 50 feet	S&ME	Rocky Ridge - Lot 39	FIGURE
Drawn by: JBP		Scaled Detailed Site Plan	1
Reviewed by: PGP		Iredell County, NC	
Date: January, 2006	ENVIRONMENTAL SERVICES • ENGINEERING • TESTING	S&ME Project #1588-05-081	