IREDELL COUNTY HEALTH DEPARTMENT

Statesville Office (704) 878-5305 Mooresville Office (704) 660-3625 PERMIT # 208 745

IMPROVEMENT PERMIT / AUTHORIZATION TO CONSTRUCT / OPERATION PERMIT / EXISTING SYSTEM

PIN # 4636-13-9631

APPLICANT: True Homes APPLICANT ADDRESS: 2649 Breckenridge Drive Monroe NC

SITE ADDRESS: 146 Farm Knoll Way Mooresville, NC PHONE: 704-283-1229 ALT. PHONE:

SITE DIRECTIONS: I-77 towards Lake Norman → Left on Isle of Pines → Right on Rockridge Point Rd → Right on Farm Knoll Way

SUBDIVISION: Rock Ridge Point SECTION: — LOT # 37 LOT AREA: 0.69 acres DESIGN FLOW: 480 gal/day L.T.A.R.: 0.25

Septic Tank 1500 (gal) STB 338 Date 11-18-15
Pump Tank 1500 (gal) PT 477 Date 12-18-15
Pump Make ____ Model ____ Serial # ____
Nitrification Fields 1 # Lines 6 Linear Ft: 322
Trench Width 24" Max. Trench Bottom Depth 36" Gravel Depth ____

☒ New System ☐ Repair ☐ Expansion System Type: I II III (IV) V VI
System Description: LP-PPBPS (50% reduction)
Repair System Description: same
Maintenance Agreement Required: ☒ YES ☐ NO
☐ GRAVITY ☒ PRESSURE

☒ Residence No. Bedrooms 4
☐ Business No. Persons 8
☐ Other No. Employees ____
☐ Slab ☒ Crawl Space
☐ Basement w/plumbing ☐ Basement w/o plumbing

Water Supply: ☐ Private ☐ Public ☒ Community

Comments / Conditions: Septic + pump tanks installed 1-20-2016 + inspected by SE.

INITIAL SITE SKETCH


See attached design by Septic Environmental Solutions [Kenneth Avens] LSS # 1134

Approved: APPROVED MAR 17 2016

Amended 3-17-16 [site plan]

AS BUILT SKETCH

3-22-16

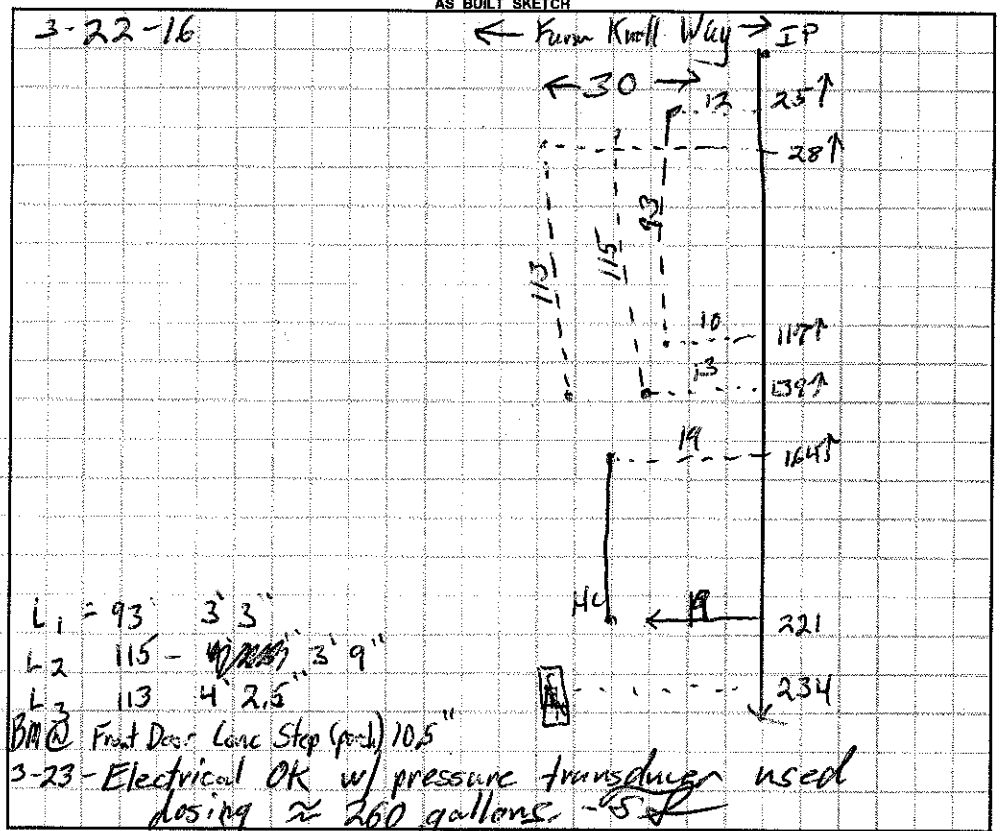

Permit can be suspended or revoked if any false information is supplied toward securing the permit / any unauthorized changes are made to the site / any unauthorized changes are made in the installation of the system. **CONTACT A LOCATOR SERVICE PRIOR TO ANY EXCAVATION**

☐ **IMPROVEMENT PERMIT** *with plat valid without expiration.* ☒ **IMPROVEMENT PERMIT** *with site plan valid for 60 mos.* ☒ **AUTHORIZATION TO CONSTRUCT** *valid for period equal to IMPROVEMENT PERMIT--not to exceed 60 mo.*

Owner / Applicant Signature: Michael Tolar Date: 3-22-16 Installed by: Sid Gaskins (tanks)

IMPROVEMENT PERMIT by: Tom Shuck Date: 3-17-16 OPERATION PERMIT by: Tom Shuck Date: 3-23-16

AUTHORIZATION TO CONSTRUCT by: Tom Shuck Date: 3-17-16 Existing System Inspected by: ____ Date: ____

Health Dept. Copy - WHITE Applicant (Final Approval) - YELLOW Applicant (Conditional Approval) - PINK

ROCKRIDGE POINT SUBDIVISION

