IREDELL COUNTY HEALTH DEPARTMENT

STATESVILLE 704-878-5305 MOORESVILLE 704-664-5281

IMPROVEMENT PERMIT / AUTHORIZATION TO CONSTRUCT / OPERATION PERMIT / EXISTING SYSTEM INSPECTION

PERMIT# 133708 PIN# ~~4636-23-3131.036~~ 4636-13-9731 DATE March 20, 2006

OWNER OR APPLICANT Dienst Enterprises PHONE: Business 704-309-0123 Home

ADDRESS 2125 Johnson Ln Charlotte N.C. 28211

LOCATION Brawley School Rd TR right side of Diner TR Rocky Farm Rd. to end TR Farmstead Ct. on right near end

SUBDIVISION Rocky Ridge PH BLOCK / SECTION LOT 36 LOT AREA .69ac SITE CLASS. B5 DESIGN FLOW 480gpd L.T.A.R. .25

Septic Tank: 1500 * Gallons; STB 445 Date 11-12-13

Pump Tank: 1500 * Gallons; PT 477 Date 11-19-13

Pump Make: Model Serial No.

Nitrification Field: No Fields 1 Square Feet 640 Linear Feet 320

No Lines 3 CF Trench Width 24" min & bc Max Trench Bottom Depth 36" Gravel Depth NA ☐ Gravity ☒ Pressure ☐ Slab ☒ Crawl Space ☐ Basement w/plumbing ☐ Basement wo/plumbing

☒ New System ☐ Repair ☐ Expansion System Type: I II III IV V VI

System Description: LPPBDS

Repair System Description: LPPBDS

Maintenance Agreement Required: ☒ Yes ☐ No

☒ House/Mod. Home No. Bedrooms 4

☐ Mobile Home No. Persons

☐ Business No. Employees

☐ Other

Water Supply: ☐ Individual ☒ Public ☒ Community

Comments:/Conditions: * PER Plan Specs

Shave off any old berms in septic system area

Comments:/Conditions: * 24" trenches

* 74 panels 27, 24, 23

* 5/32 hole

INITIAL SITE SKETCH

AS BUILT SKETCH

* Installed as Drawn

* Tanks Shifted to Parallel with Side P/L

Permit can be suspended or revoked if any false information is supplied toward securing the permit/any unauthorized changes are made to the site/any unauthorized changes are made in the installation of the system. Improvement Permit with plat valid without expiration. Improvement Permit with site plan valid for sixty months. Authorization to Construct is valid for a period equal to that of Improvement Permit – not to exceed sixty months.

Signed: Robert B. Dienst date 4/11/06

Improvement Permit by: date 3-20-06

Authorization to Construct by: date 10-2-13

Installed by: Stevens Trucking and Septic

Operation Permit by: date 3-31-14

Existing System Inspection by: date

HEALTH DEPT. COPY: WHITE OWNER COPY (FINAL): YELLOW OWNER COPY (INITIAL): PINK

IREDELL COUNTY HEALTH DEPARTMENT

Statesville Office (704) 878-5305 Mooresville Office (704) 660-3625 PERMIT # 133708

IMPROVEMENT PERMIT / AUTHORIZATION TO CONSTRUCT / OPERATION PERMIT / EXISTING SYSTEM

PIN # 4636-13-9731

APPLICANT: True Homes LLC APPLICANT ADDRESS: 2649 Brecknridge Centre Dr Monroe NC 28110

SITE ADDRESS: 150 Farm Knoll Way Mooresville PHONE: 704-238-1229 ALT. PHONE:

SITE DIRECTIONS: Brawley Sch Rd, TL on Isle of Pines, TR on Rocky Farm Rd, TR on Farm Knoll Lot at end on R

SUBDIVISION: Rocky Ridge Pt SECTION: LOT # 36 LOT AREA: 0.69 ac DESIGN FLOW: 480 gpd L.T.A.R.:

Septic Tank 1500 (gal) STB 333 Date 2-13-14
Pump Tank 1500 (gal) PT 477 Date 2-13-14
Pump Make Model Serial #
Nitrification Fields # Lines Linear Ft:
Trench Width Max. Trench Bottom Depth Gravel Depth

☐ New System ☐ Repair ☐ Expansion System Type: I II III IV V VI
System Description: EXISTING LP PPBPS
Repair System Description: LP PPBPS
Maintenance Agreement Required: ☐ YES ☐ NO ☐ GRAVITY ☐ PRESSURE

☑ Residence ☐ Business ☐ Other ☐ Slab ☑ Crawl Space ☐ Basement w/plumbing ☐ Basement w/o plumbing
No. Bedrooms 4 No. Persons 8 No. Employees

Water Supply: ☐ Private ☐ Public ☑ Community

Comments / Conditions: * Follow Plans *, * Existing Septic & Pump Tanks to be moved Approx. 3 FT closer to Property Line * If existing tanks are moved a 24 hr water tightness test will be required.

INITIAL SITE SKETCH

SEE PLAN BY MICHAEL ATHANAS & ASSOCIATES

Approved by ICHD

AS BUILT SKETCH

* NEW TANKS INSTALLED

Permit can be suspended or revoked if any false information is supplied toward securing the permit / any unauthorized changes are made to the site / any unauthorized changes are made in the installation of the system. **CONTACT A LOCATOR SERVICE PRIOR TO ANY EXCAVATION**


☐ **IMPROVEMENT PERMIT** *with plat valid without expiration.* ☑ **IMPROVEMENT PERMIT** *with site plan valid for 60 mos.* ☑ **AUTHORIZATION TO CONSTRUCT** *valid for period equal to IMPROVEMENT PERMIT--not to exceed 60 mo.*

Owner / Applicant Signature: Date: 3-19-14 Installed by: STEVENS TRUCKING and SEPTIC

IMPROVEMENT PERMIT by: Date: 3-17-14 OPERATION PERMIT by: Date: 3-20-14

AUTHORIZATION TO CONSTRUCT by: Date: 3-17-14 Existing System Inspected by: Date:

Health Dept. Copy - WHITE Applicant (Final Approval) - YELLOW Applicant (Conditional Approval) - PINK

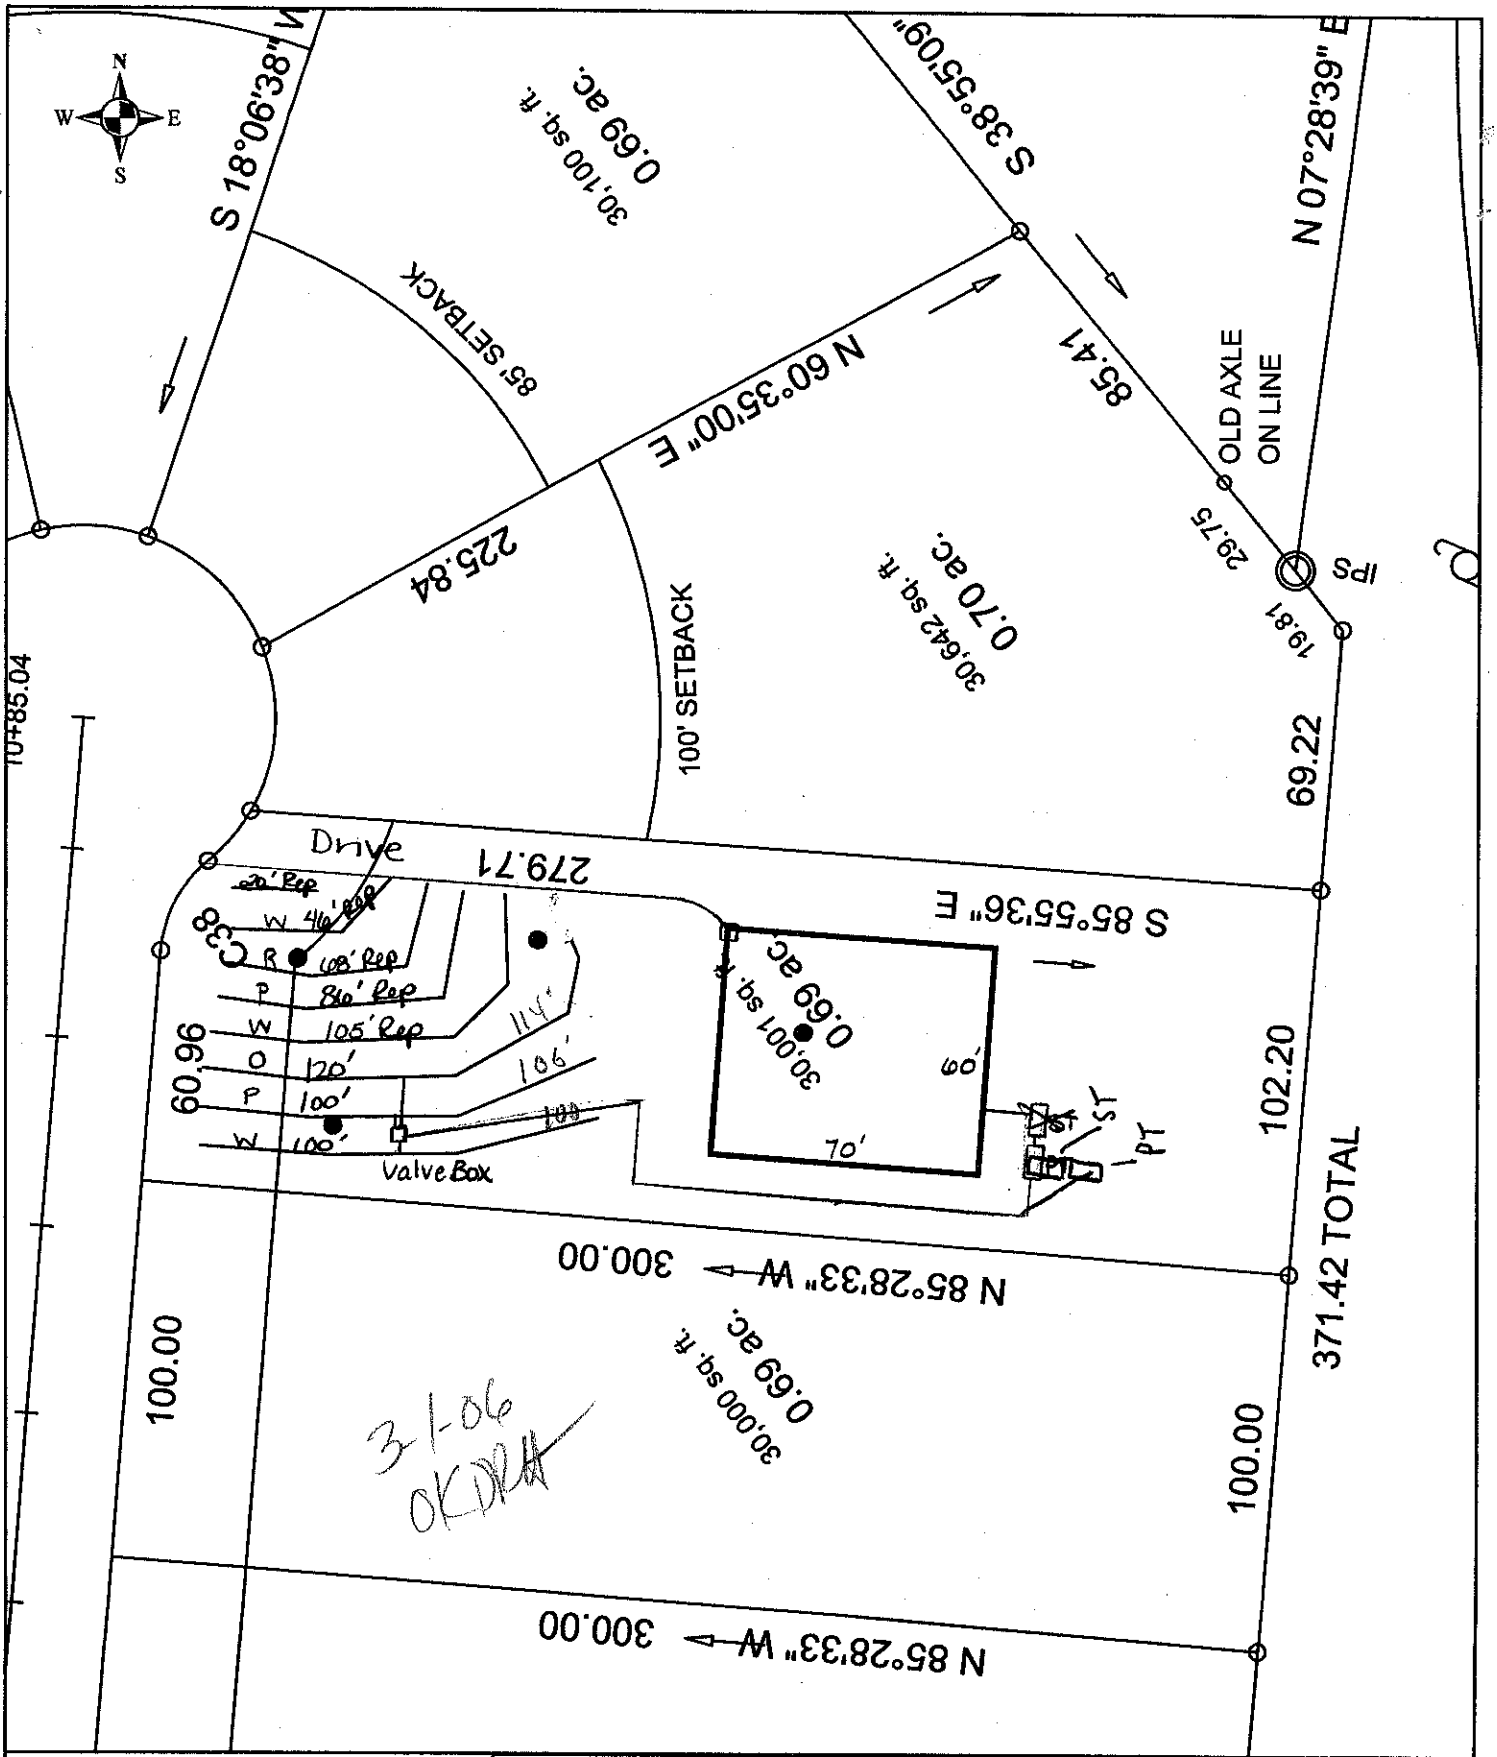

Scale: 1 inch equals 50 feet	S&ME	Rocky Ridge - Lot 30	FIGURE
Drawn by: JBP	ENVIRONMENTAL SERVICES • ENGINEERING • TESTING	Scaled Detailed Site Plan	1
Reviewed by: PGP		Iredell County, NC	
Date: February, 2006		S&ME Project #1588-05-081	