132298

IREDELL COUNTY HEALTH DEPARTMENT

STATESVILLE 704-878-5305 MOORESVILLE 704-664-5281

IMPROVEMENT PERMIT / AUTHORIZATION TO CONSTRUCT / OPERATION PERMIT / EXISTING SYSTEM INSPECTION

PERMIT# ~~132298~~ / ~~FP3667~~ PIN# 4636 14 ~~3649~~ 3636 DATE Nov. 16, 05

OWNER OR APPLICANT Chesapeake Pt. LLC / Orleans Homes PHONE: Business _____ Home _____

ADDRESS 7380 McGinnis Ferry Rd Suwanee Ga. 30024

LOCATION Brawley Sch Rd. TL Isle of Pines TR Cove Creek Rd on Right

SUBDIVISION Chesapeake Pt. BLOCK / SECTION I LOT 7 LOT AREA 1.08ac SITE CLASS RS DESIGN FLOW 440gpd L.T.A.R. 3 bedrooms

Septic Tank: 1000 Gallons; STB 794 Date 4-15-13
Pump Tank: 1000 Gallons; PT 27 Date 9-9-13
Pump Make: Hydroconal Model SHE45 Serial No. _____
Nitrification Field: No Fields 1 Square Feet 540 Linear Feet 270
No Lines 3 (CF) Trench Width 24" min 36" Max Trench Bottom Depth 36" Gravel Depth NA

☒ New System ☐ Repair ☐ Expansion System Type: I II III (IV) V VI
System Description: LPPPBPS
Repair System Description: LPPPBPS
Maintenance Agreement Required: ☒ Yes ☐ No

☒ House/Mod. Home ☐ Mobile Home ☐ Business ☐ Other
No. Bedrooms 4 No. Persons _____ No. Employees _____

Water Supply: ☐ Individual ☒ Public ☒ Community

☐ Gravity ☒ Pressure ☐ Slab ☒ Crawl Space ☐ Basement w/plumbing ☐ Basement wo/plumbing

Comments:/Conditions:

Original site evaluation and system design performed by Kat Wilcox and Kathleen Howell of S&ME

INITIAL SITE SKETCH

SEE Plan from S&ME

Comments:/Conditions:

7/29/13 Reviewed Floorplans & site plan, in compliance with original plans

3/16" noble drilled

AS BUILT SKETCH

10/16/13 Checked Tanks & lines & set PA pressure MD

Elect checked by BA 11/15/13

11/18/13 Received Maint Agreement

Chesapk Pt. #7

	Date	Initials
Drain Lines Checked	10/16/13	MD
Tanks Checked	10/16/13	MD
Pressure Manifold or Valve Box Checked		
Pressure Head Set	10/16/13	MD
Electrical Checked	11-15	BA
Floats Set		
Alarm Checked		
Maintenance Contract Y / N		


Permit can be suspended or revoked if any false information is supplied toward securing the permit/any unauthorized changes are made to the site/any unauthorized changes are made in the installation of the system. Improvement Permit with plat valid without expiration ☐ Improvement Permit with site plan valid for sixty months ☒ Authorization to Construct is valid for a period equal to that of Improvement Permit – not to exceed sixty months.

Signed: _____ date 11-2-05 Installed by: Willie Christenbury RS

Improvement Permit by: _____ RS date 11-16-05 Operation Permit: Maiah M Colson RS 11/18/13

Authorization to Construct by: Maiah M Colson RS date 7/29/13 Existing System Inspection: _____ date _____

HEALTH DEPT. COPY: WHITE OWNER COPY (FINAL): YELLOW OWNER COPY (INITIAL): PINK

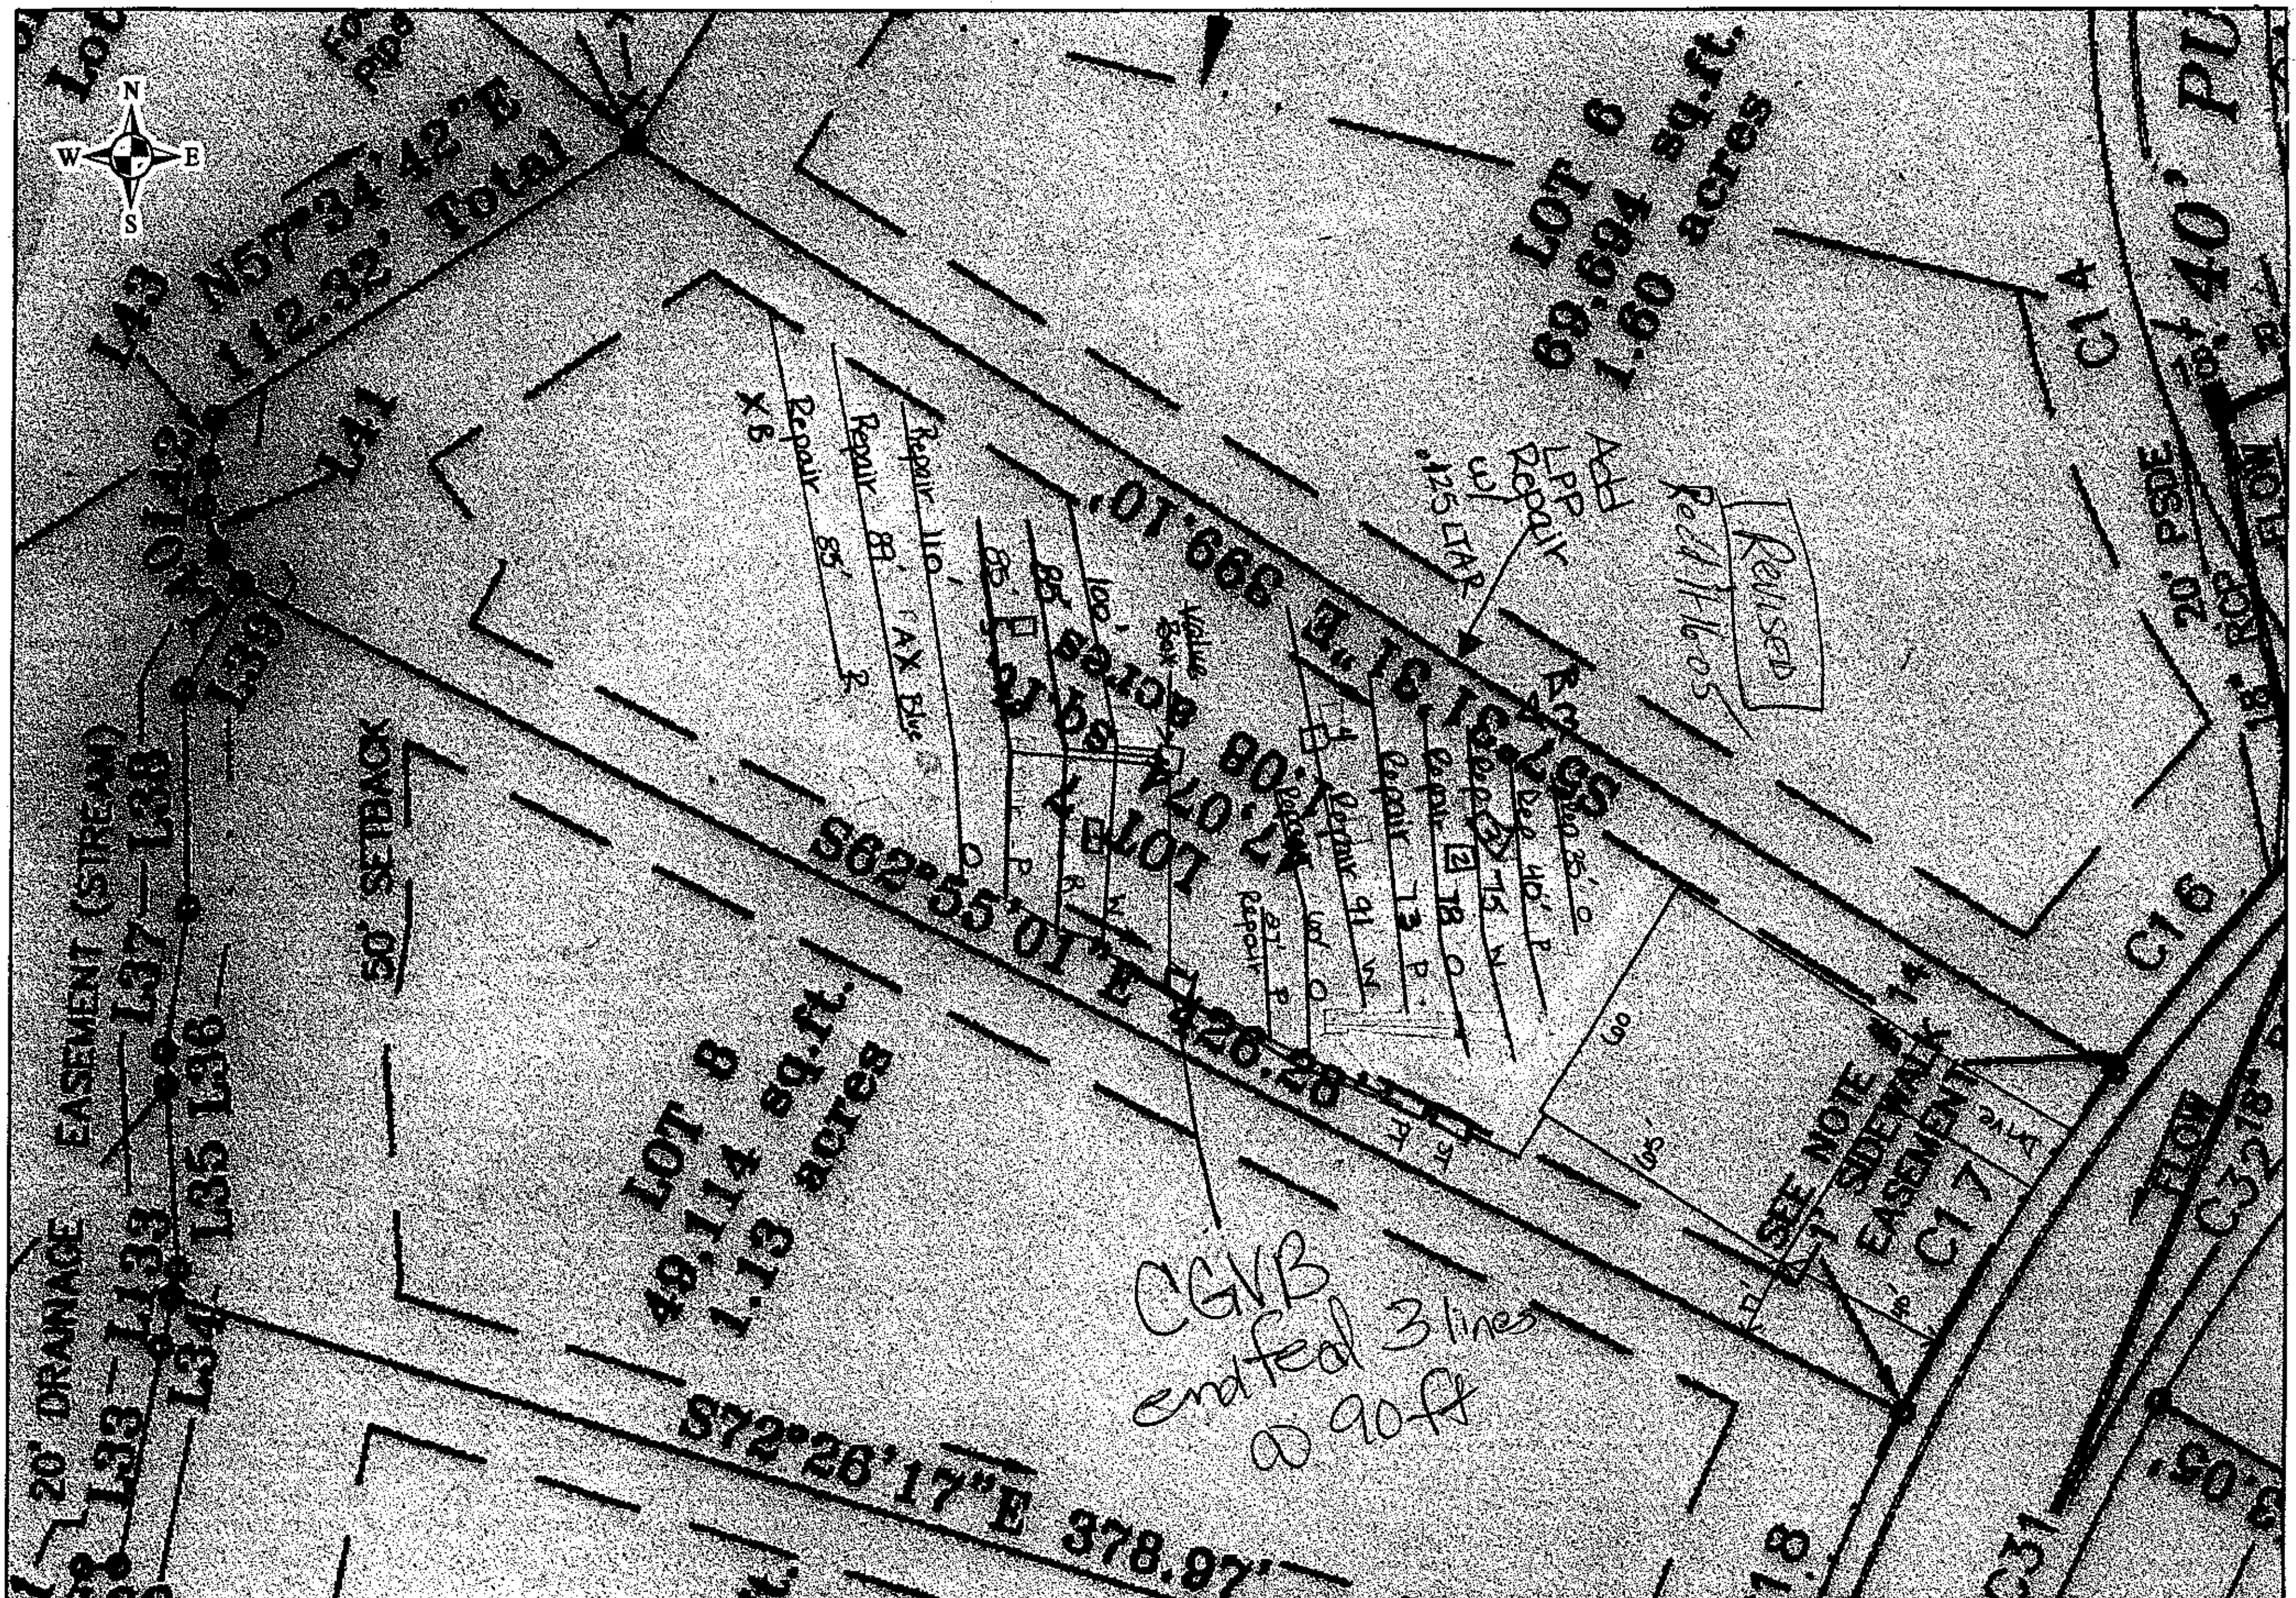

Scale: 1 inch equals 50 feet	S&ME	Lot 7 Chesapeke Pointe	FIGURE
Drawn by: JBP		Detailed, Scaled Site Plan	1
Reviewed by: MEM		Iredell County, NC	
Date: November, 2005	ENVIRONMENTAL SERVICES • ENGINEERING • TESTING	S&ME Project #1588-04-011	