IREDELL COUNTY HEALTH DEPARTMENT

STATESVILLE 704-878-5305 MOORESVILLE 704-664-5281

IMPROVEMENT PERMIT / AUTHORIZATION TO CONSTRUCT / OPERATION PERMIT / EXISTING SYSTEM INSPECTION

PERMIT# 132306 PIN# ~~4636147429~~ 4636147522 DATE Nov. 16, 05

OWNER OR APPLICANT Chesapeake Pointe LLC / Orleans PHONE: Business Home

ADDRESS 7380 McGinnis Ferry Rd. Suwanee, GA. 30024

LOCATION Brawley Sch Rd. / TL Isk of Pines TR Core Creek Rd. on left

SUBDIVISION Chesapeake Pt. BLOCK / SECTION LOT 99 LOT AREA .84Ac SITE CLASS. RS DESIGN FLOW 480gpd L.T.A.R. .025

Septic Tank: 1000 Gallons: STB 1921 Date 11-28-06
Pump Tank: 1000 Gallons: PT 283 Date 11-21-06
Pump Make: Goulds Model WE05111H Serial No. 5265418541
Nitrification Field: No Fields 1 Square Feet 640 Linear Feet 320
No Lines 3 (CF) Trench Width 24" min 36" Max Trench Bottom Depth 30"

☒ New System ☐ Repair ☐ Expansion System Type: I II III IV V VI
System Description: LPP PBPS
Repair System Description: LPP PBPS
Maintenance Agreement Required: ☒ Yes ☐ No

☒ House/Mod. Home No. Bedrooms 4
☐ Mobile Home No. Persons
☐ Business No. Employees
☐ Other

Water Supply: ☐ Individual ☒ Public ☒ Community

Gravel Depth NA ☐ Gravity ☒ Pressure ☐ Slab ☒ Crawl Space ☐ Basement w/plumbing ☐ Basement wo/plumbing

Comments:/Conditions: 11/2/07 Check tanks, lines & pressure. Critical site evaluation and system design performed by Rob Mileo and Kathleen Hare, SPME

INITIAL SITE SKETCH

3/14/07 Note: Large patio w/ walkway ~ 30sq ft behind house not approved by Health Dept. Cuts into repair area.

SEE Plan from SPME

Comments:/Conditions: Reviewed Building plans 3/28/06 essentially in Compliance with orginal permit.

* Use In line filter on PT

AS BUILT SKETCH

* Drive on other side. (5 lines)

3/16 ~ hole drilled


Permit can be suspended or revoked if any false information is supplied toward securing the permit/any unauthorized changes are made to the site/any unauthorized changes are made in the installation of the system. Improvement Permit with plat valid without expiration. ☐ Improvement Permit with site plan valid for sixty months ☒ Authorization to Construct is valid for a period equal to that of Improvement Permit – not to exceed sixty months.

Signed: date 11-21-05 Installed by: Willie Christenbury

Improvement Permit by: date 11-16-05 Operation Permit by: date 3/15/07

Authorization to Construct by: RS date 3/28/06 Existing System Inspection by: date

HEALTH DEPT. COPY: WHITE OWNER COPY (FINAL): YELLOW OWNER COPY (INITIAL): PINK

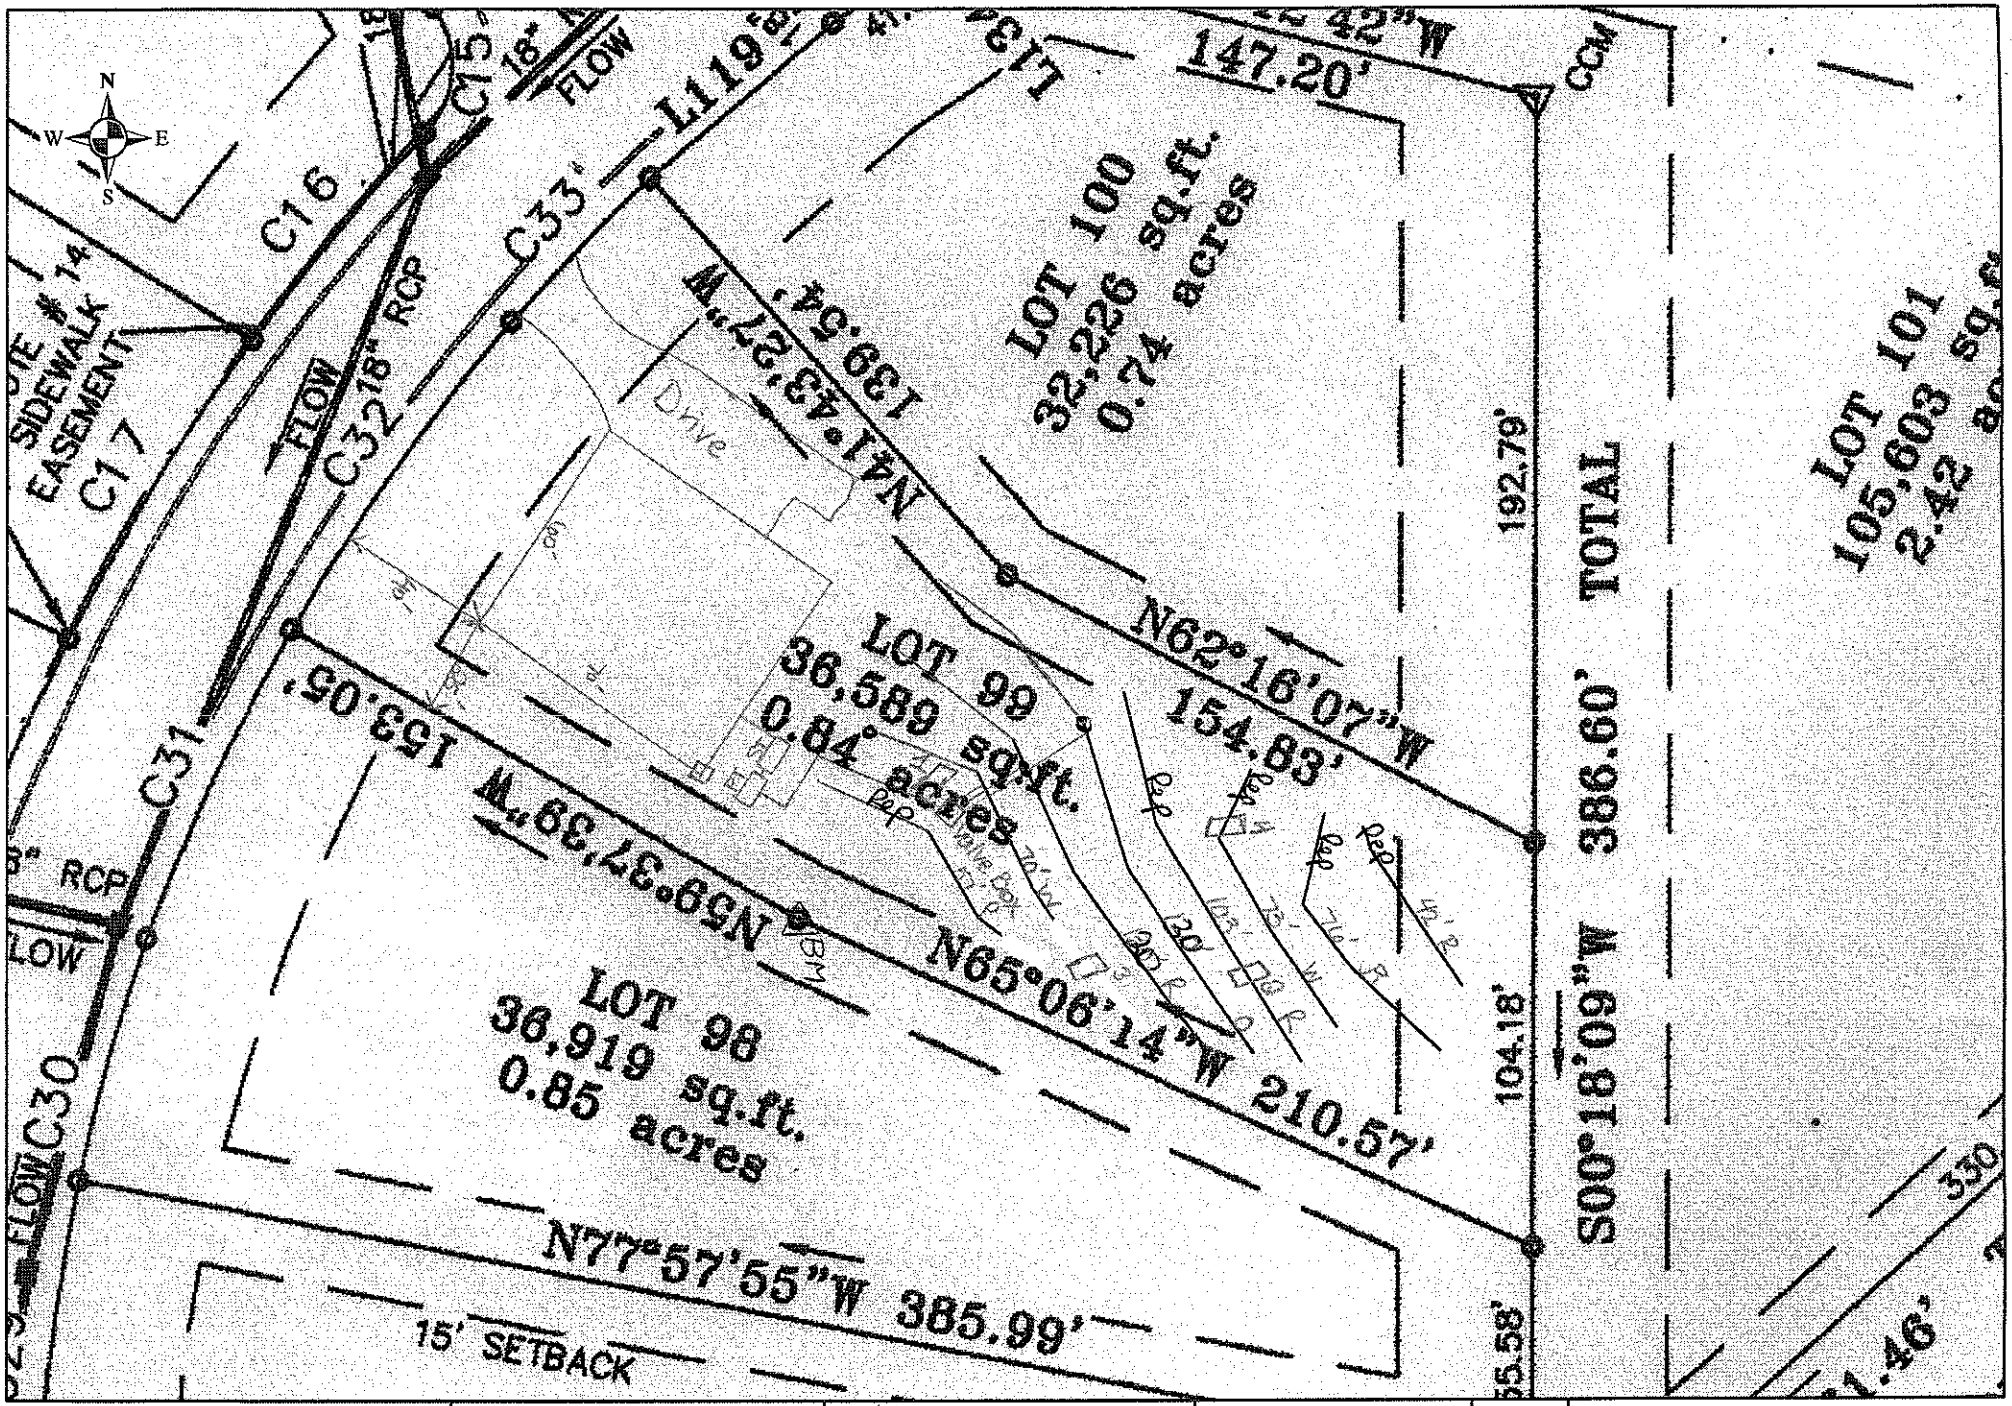

Scale: 1 inch equals 50 feet	S&ME	Lot 99 Chesapeke Pointe	FIGURE
Drawn by: JBP	ENVIRONMENTAL SERVICES • ENGINEERING • TESTING	Detailed, Scaled Site Plan	1
Reviewed by: MEM		Iredell County, NC	
Date: November, 2005		S&ME Project #1588-04-011	

263-0155