BF

IREDELL COUNTY HEALTH DEPARTMENT

Statesville Office (704) 878-5305 Mooresville Office (704) 660-3625 PERMIT # 200204

IMPROVEMENT PERMIT / AUTHORIZATION TO CONSTRUCT / OPERATION PERMIT / EXISTING SYSTEM

PIN # 4636-14-7522

APPLICANT: Carolina Outdoor Concepts APPLICANT ADDRESS: 10810 Backridge Rd Charlotte NC 28277

SITE ADDRESS: 404 Cove Creek Lp Mooresville NC 28117 PHONE: 704-341-5737 ALT. PHONE:

SITE DIRECTIONS: Brawley Sch Rd, TL on Isle of Pines, TR on Cove Creek Rd

SUBDIVISION: Chesapeake Pt SECTION: LOT # 99 LOT AREA: 0.84 ac DESIGN FLOW: 480 gpd L.T.A.R.: 0.25

Septic Tank EXISTING 1000 (gal) STB Date

Pump Tank EXISTING 1000 (gal) PT Date

Pump Make Model Serial #

Nitrification Fields 1 # Lines 5 Linear Ft: 320

Trench Width Max. Trench Bottom Depth 30" Gravel Depth N/A

☐ New System ☐ Repair ☐ Expansion System Type: I II III ☑ V VI

System Description: EXISTING LP PPBPS

Repair System Description: LP PPBPS

Maintenance Agreement Required: ☑ YES ☐ NO ☐ GRAVITY ☑ PRESSURE

☑ Residence No. Bedrooms 4

☐ Business No. Persons 8

☐ Other No. Employees

☐ Slab ☑ Crawl Space


☐ Basement w/plumbing ☐ Basement w/o plumbing

Water Supply: ☐ Private ☐ Public ☑ Community


Comments / Conditions:

* Paver Patio was already constructed before inspection date, if repair is needed patio will need to be removed.

INITIAL SITE SKETCH

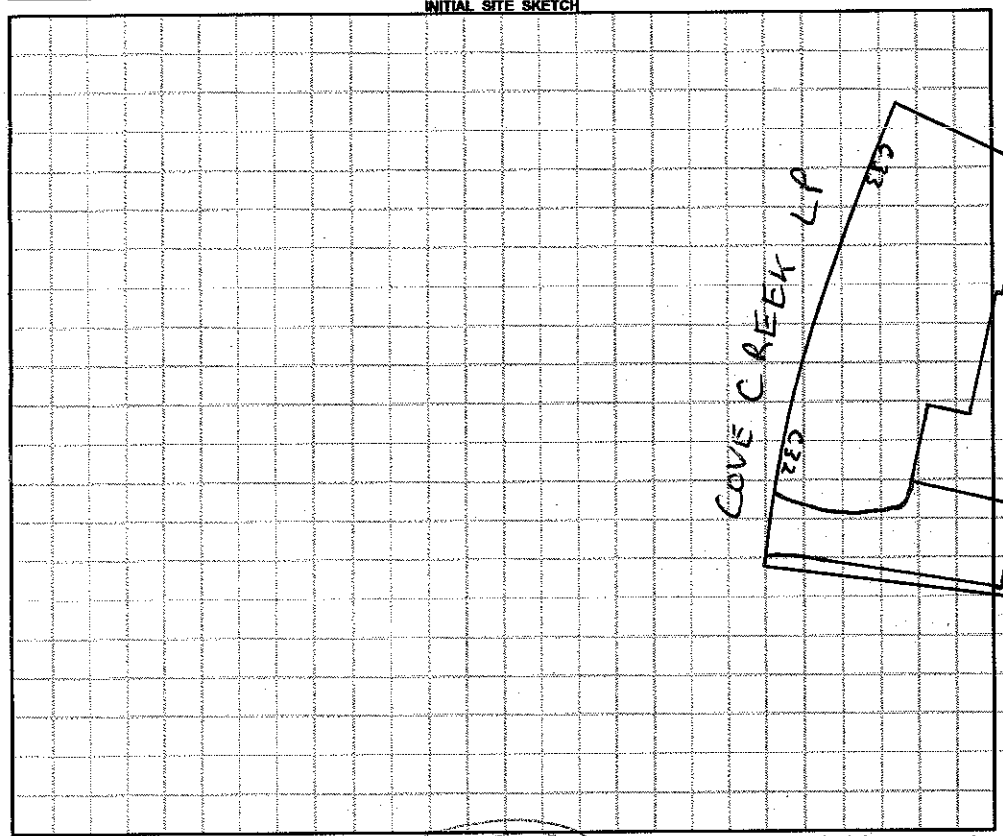

AS BUILT SKETCH

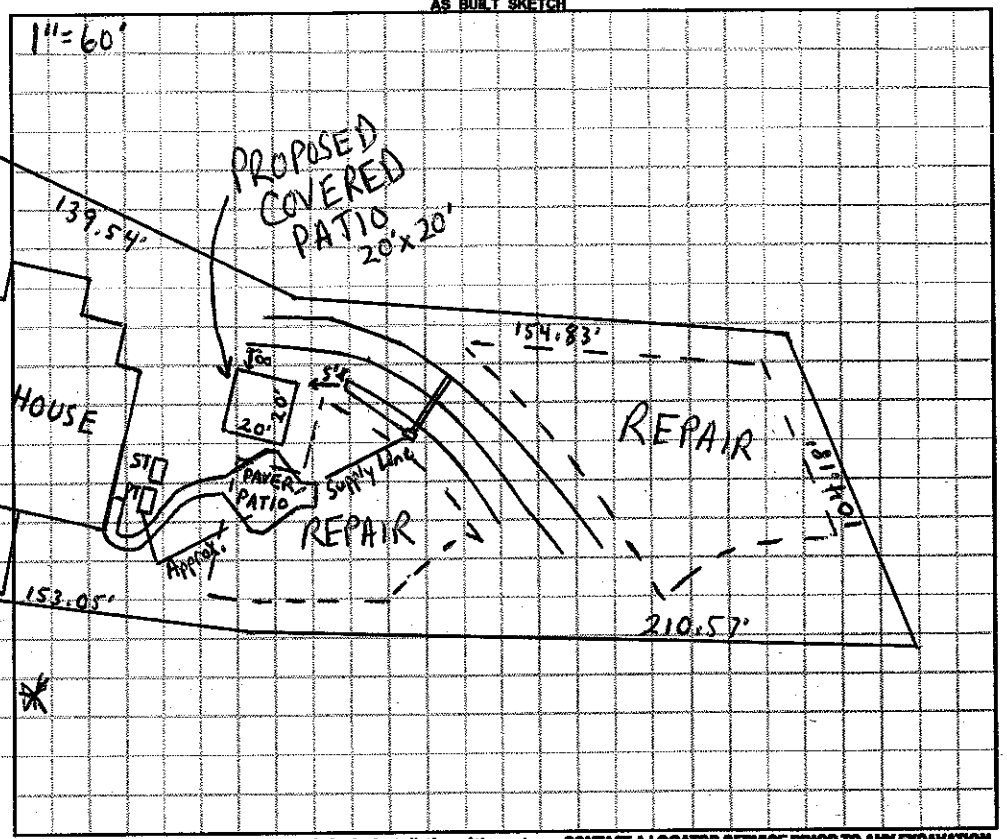

Permit can be suspended or revoked if any false information is supplied toward securing the permit / any unauthorized changes are made to the site / any unauthorized changes are made in the installation of the system. **CONTACT A LOCATOR SERVICE PRIOR TO ANY EXCAVATION**

☐ **IMPROVEMENT PERMIT** *with plat valid without expiration.* ☐ **IMPROVEMENT PERMIT** *with site plan valid for 60 mos.* ☐ **AUTHORIZATION TO CONSTRUCT** *valid for period equal to IMPROVEMENT PERMIT--not to exceed 60 mo.*

Owner / Applicant Signature: Date: Installed by:

IMPROVEMENT PERMIT by: Date: OPERATION PERMIT by: Date:

AUTHORIZATION TO CONSTRUCT by: Date: Existing System Inspected by: Date: 1-8-14

Health Dept. Copy - WHITE Applicant (Final Approval) - YELLOW Applicant (Conditional Approval) - PINK