IREDELL COUNTY HEALTH DEPARTMENT

Statesville Office (704) 878-5305 Mooresville Office (704) 660-3625 PERMIT # 212356

IMPROVEMENT PERMIT / AUTHORIZATION TO CONSTRUCT / OPERATION PERMIT / EXISTING SYSTEM

PIN # 4636-14-9680.000

APPLICANT: Bryan Clodfelter APPLICANT ADDRESS: 1824 Triplett Rd., Mt. Ulla NC 28125

SITE ADDRESS: 416 Cove Creek Lp. Mooresville NC PHONE: 704-663-4041 ALT. PHONE:


SITE DIRECTIONS: BSR, TL Isle of Pines, TR Cove Creek Lp (Chesapeake Point), Site on L

SUBDIVISION: Chesapeake Point SECTION: 1 LOT # 101 LOT AREA: 2.420 Acre DESIGN FLOW: Ex. 480 GPD L.T.A.R.: Existing


Septic Tank Existing	(gal)	STB	Date	☐ New System ☐ Repair ☐ Expansion	System Type: I II ☒ III IV V VI	☒ Residence	No. Bedrooms Ex 4	Water Supply
Pump Tank	(gal)	PT	Date	System Description: Existing 25% Red. Gravity		☐ Business	No. Persons Ex 8	☐ Private
Pump Make		Model	Serial #	Repair System Description: LP-PDIPS		☐ Other	No. Employees	☐ Public
# Nitrification Fields Ex	# Lines Existing 3	Linear Ft: Ex.		Maintenance Agreement Required:	☐ YES ☒ NO	☐ Slab	☒ Crawl Space	☒ Community
Trench Width Ex.	Max. Trench Bottom Depth Ex.		Gravel Depth Ex.	☒ GRAVITY	☐ PRESSURE	☐ Basement w/plumbing	☐ Basement w/o plumbing	

Comments / Conditions: System Appeared To Be Functioning @ Time Of Inspection. Maintain 5' Separation From Repair Area w/ Proposed Garage.

INITIAL SITE SKETCH

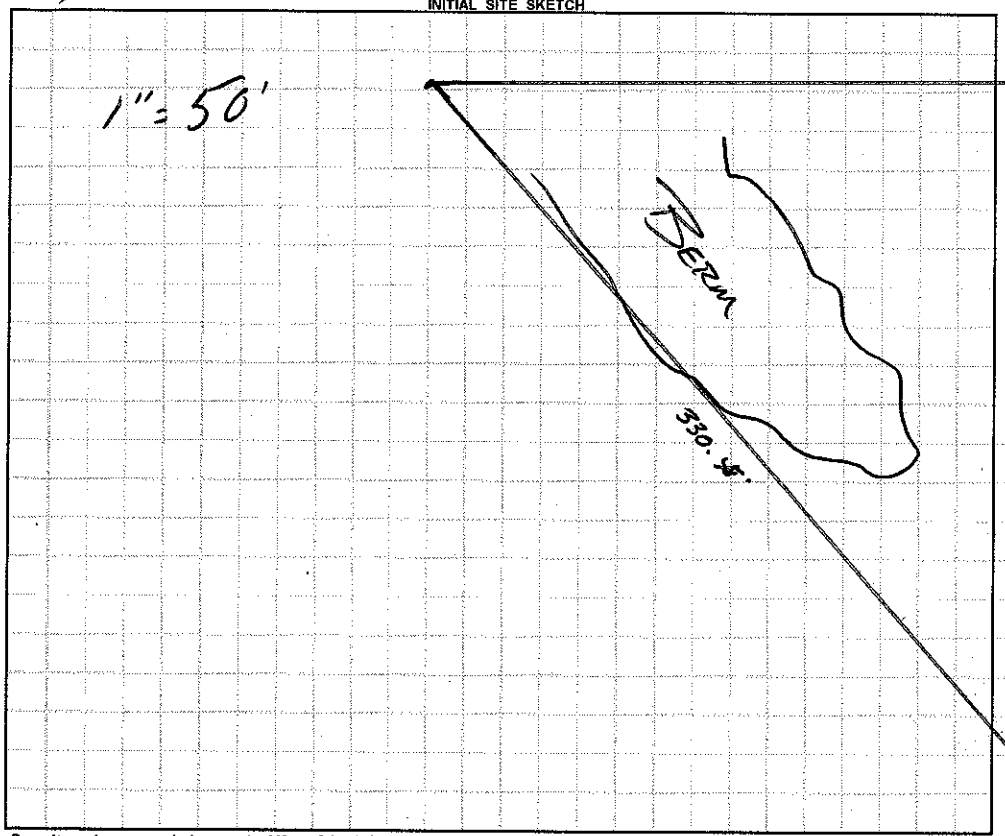

AS BUILT SKETCH

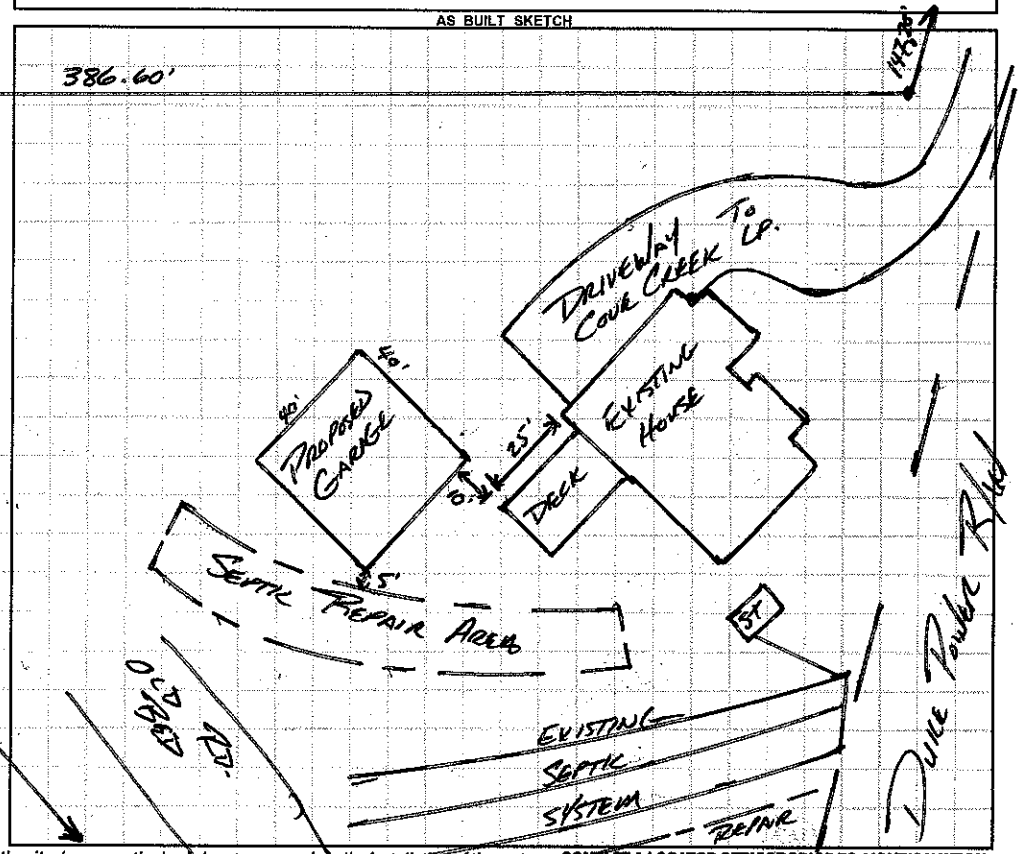

Permit can be suspended or revoked if any false information is supplied toward securing the permit / any unauthorized changes are made to the site / any unauthorized changes are made in the installation of the system. **CONTACT A LOCATOR SERVICE PRIOR TO ANY EXCAVATION**


☐ **IMPROVEMENT PERMIT** *with plat valid without expiration* ☐ **IMPROVEMENT PERMIT** *with site plan valid for 60 mos.* ☐ **AUTHORIZATION TO CONSTRUCT** *valid for period equal to IMPROVEMENT PERMIT--not to exceed 60 mo.*

Owner / Applicant Signature: Date: 9/2/15 Installed by:

IMPROVEMENT PERMIT by: Date: OPERATION PERMIT by: Date:

AUTHORIZATION TO CONSTRUCT by: Date: Existing System Inspected by: APPROVED SEP 01 2015

Health Dept. Copy - WHITE Applicant (Final Approval) - YELLOW Applicant (Conditional Approval) - PINK

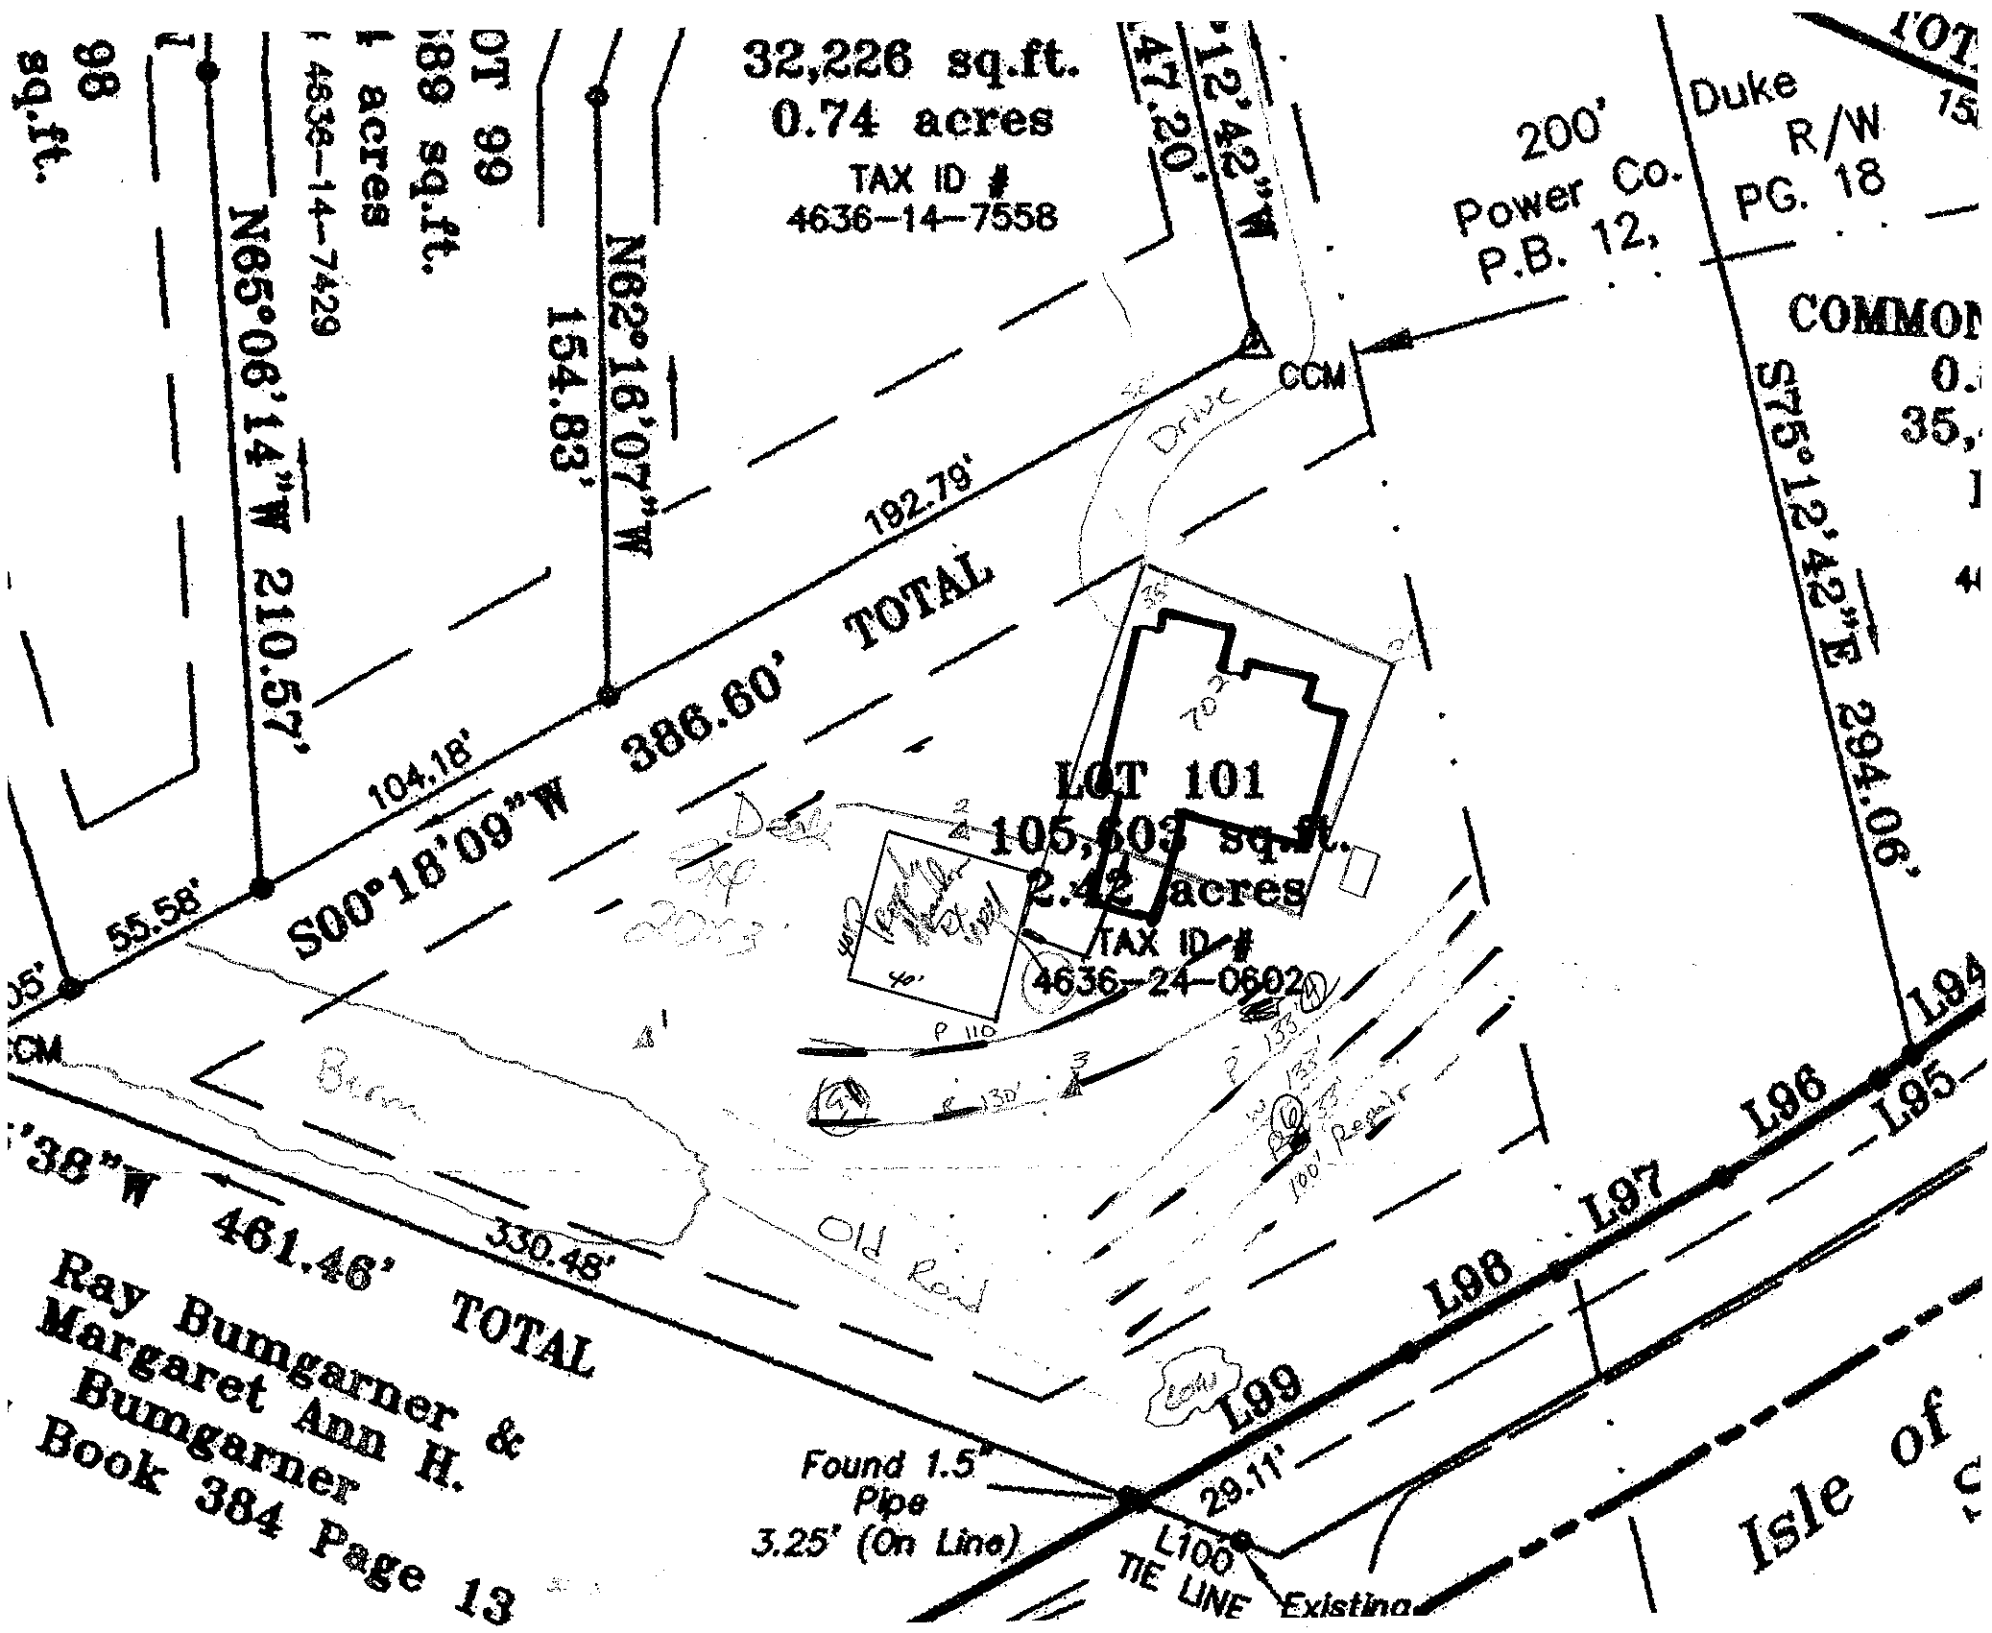
32,226 sq.ft.
0.74 acres
TAX ID #
4636-14-7558
N65°06'14"W 210.57'
N62°16'07"W
154.83'
192.79'
TOTAL
386.60'
S00°18'09"W
104.18'
55.58'
LOT 101
105,603 sq.ft.
2.42 acres
TAX ID #
4636-24-0602
200'
Power Co.
P.B. 12,
Duke
R/W
PG. 18
S75°12'42"E 294.06'
CCM
Drive
Old Road
330.48'
461.46' TOTAL
Ray Bumgarner &
Margaret Ann H.
Bumgarner
Book 384 Page 13
Found 1.5"
Pipe
3.25' (On Line)
29.11'
L100
TIE LINE
L99
L98
L97
L96
L95
L94
Isle of