IREDELL COUNTY HEALTH DEPARTMENT

STATESVILLE 704-878-5305 MOORESVILLE 704-664-5281

IMPROVEMENT PERMIT / CERTIFICATE OF COMPLETION / OPERATION PERMIT / EXISTING SYSTEM INSPECTION

PROPERTY DESCRIPTION NO. 14289 DATE 12/1/93 TAX MAP NO. 2L-9 A 1 Watershed: ☒ Yes ☐ No

OWNER OR CONTRACTOR C.W. BREWER PHONE: Business Home

ADDRESS MEADOW CREEK LN. OFF BEECHTREE LN. 4636184598

LOCATION SPRINGFIELD

SUBDIVISION Springfield BLOCK / SECTION LOT 1 LOT AREA SITE CLASS. P DESIGN FLOW ~~.25~~ 360 L.T.A.R. .25 = .3

Septic Tank: 1000 Gallons; STB 325 Date 10/25/93

Pump Tank: Gallons; PT Date

Pump Make: Model Serial No.

Nitrification Field: No Fields 1 Square Feet 1200 Linear Feet 400

No Lines 3 Trench Width 3' Max Trench Bottom Depth 3' Gravel Depth 12"

☒ New System ☐ Repair System Type: I, ☒ II, III, IV, V, VI

System Description: CONV - DROP BOXES

Repair System Description:

Maintenance Agreement Required: ☐ Yes ☒ No

☒ House/Mod. Home No. Bedrooms 3

☐ Mobile Home No. Bathrooms 2

☐ Business No. Employees

☐ Other

☐ Slab ☐ Crawl Space ☐ Basement w/plumbing ☐ Basement wo/plumbing


Water Supply: ☒ Individual ☐ Community ☐ Public

Comments:

Comments:

INITIAL SITE SKETCH

AS BUILT SKETCH

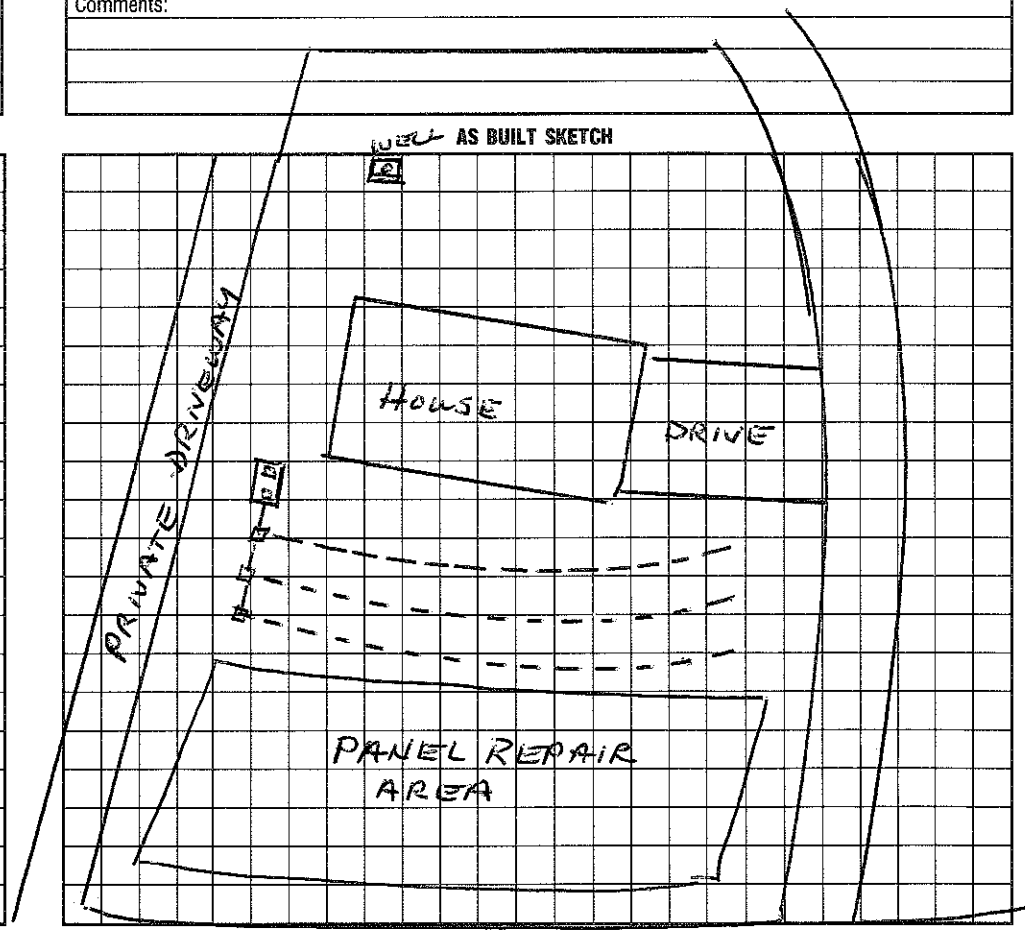

I understand that this permit can be suspended or revoked if any false information is supplied toward securing the permit/any unauthorized changes are made to the site/any unauthorized changes are made in the installation of the system. Improvement Permit is valid for 60 months from date of issuance.

Signed:

Improvement Permit by: date

Existing System Inspection by: date

Installed by: BEECHTREE RD. Richard Abernathy

Certificate of Completion by: Wesley Sparks RS. date 12/1/93

Operation Permit by: date

HEALTH DEPT. COPY: WHITE INSPECTION COPY (FINAL): GREEN OWNER COPY (FINAL): YELLOW INSPECTION COPY (INITIAL): PINK OWNER COPY (INITIAL): GOLD