4636187744

IREDELL COUNTY HEALTH DEPARTMENT

STATESVILLE 704-878-5305 MOORESVILLE 704-664-5281

IMPROVEMENT PERMIT / CERTIFICATE OF COMPLETION / OPERATION PERMIT / EXISTING SYSTEM INSPECTION

PROPERTY DESCRIPTION NO. 17574 DATE Jan. 6, '94 TAX MAP NO. 2L9A18 Watershed: ☑ Yes ☐ No

OWNER OR CONTRACTOR C W Brewer PHONE: Business 663-4669 Home L.N.

ADDRESS PO Box 69, Mt. Mourne

LOCATION 1100 TR Blume immediately TR Beechtree TR Meadow Creek Lane TR Beechfield on Right

SUBDIVISION Springfield BLOCK / SECTION _____ LOT 18 LOT AREA .82 Ac SITE CLASS. 5 DESIGN FLOW 360gpd L.T.A.R. .3

Septic Tank: 1000 Gallons; STB 825 RST Date 3-11-94

Pump Tank: _____ Gallons; PT _____ Date _____

Pump Make: _____ Model _____ Serial No. _____

Nitrification Field: No Fields 1 Square Feet 1200 Linear Feet 400

No Lines 4-5 Trench Width 36" Max Trench Bottom Depth 36" Gravel Depth 12"

☑ New System ☐ Repair System Type: I, II, III, IV, V, VI

System Description: gravity conventional

Repair System Description: gravity or pumped conv.

Maintenance Agreement Required: ☐ Yes ☑ No

☑ House/Mod. Home No. Bedrooms 3

☐ Mobile Home No. Bathrooms 2

☐ Business No. Employees _____

☐ Other _____


☐ Slab ☑ Crawl Space ☐ Basement w/plumbing ☐ Basement wo/plumbing

Water Supply: ☑ Individual ☐ Community ☐ Public


Comments: follow contour with laterals

Comments:

INITIAL SITE SKETCH

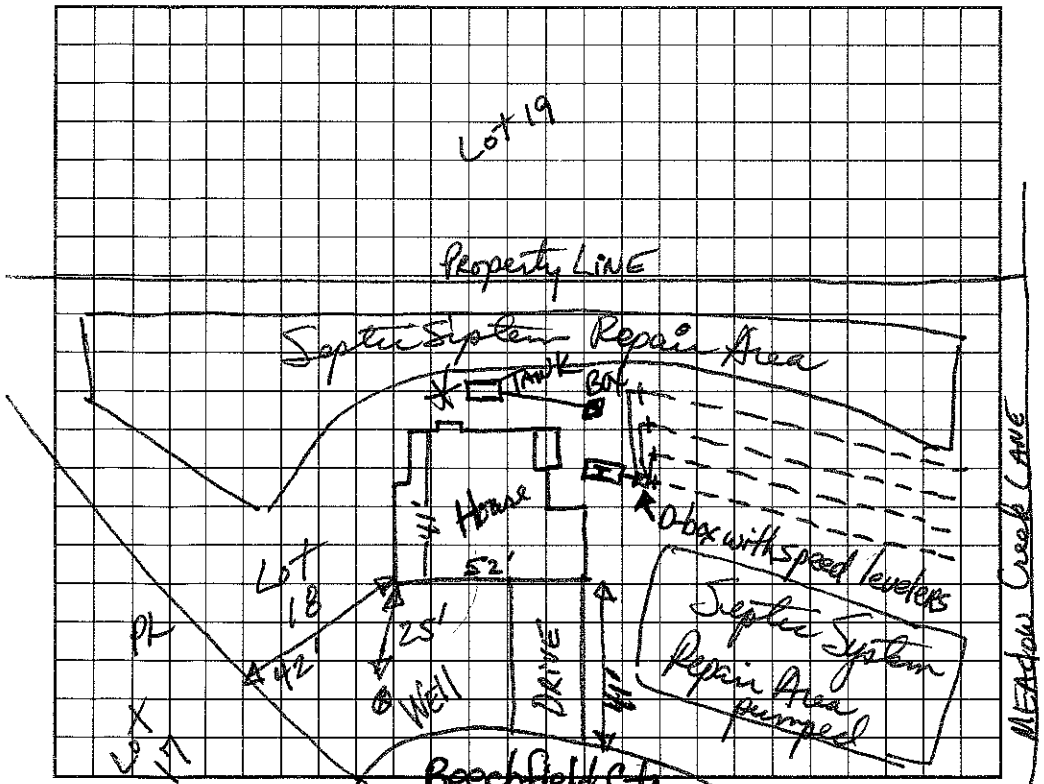

AS BUILT SKETCH

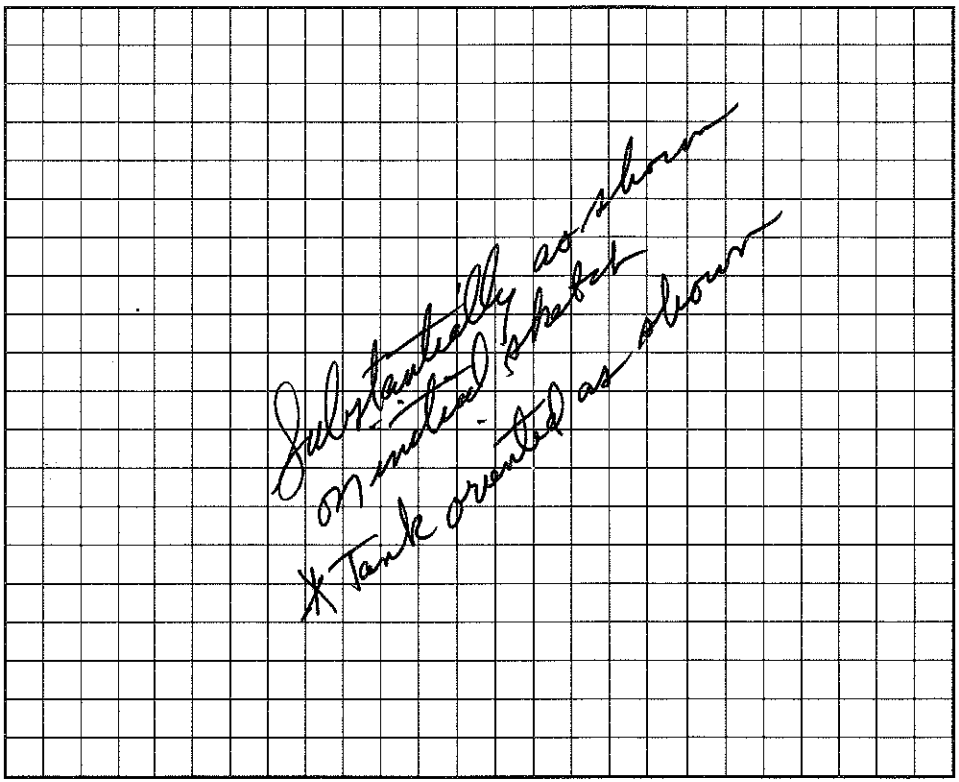

I understand that this permit can be suspended or revoked if any false information is supplied toward securing the permit/any unauthorized changes are made to the site/any unauthorized changes are made in the installation of the system. Improvement Permit is valid for 60 months from date of issuance.

Signed _____

Improvement Permit by: _____ date Jan 6, 194

Existing System Inspection by: _____ date _____

Installed by: Richard Abernathy

Certificate of Completion by: _____ date 5/24/94

Operation Permit by: _____ date _____

HEALTH DEPT. COPY: WHITE INSPECTION COPY (FINAL): GREEN OWNER COPY (FINAL): YELLOW INSPECTION COPY (INITIAL): PINK OWNER COPY (INITIAL): GOLD