# IREDELL COUNTY HEALTH DEPARTMENT

Authorization to Construct 4636190394

STATESVILLE 704-878-5305 MOORESVILLE 704-664-5281

## IMPROVEMENT PERMIT / ~~CERTIFICATE OF COMPLETION~~ / OPERATION PERMIT / EXISTING SYSTEM INSPECTION

PROPERTY DESCRIPTION NO. 22154 DATE 11/8/95 TAX MAP NO. 2L 9 A 7+8 Watershed: [X] Yes [ ] No

OWNER OR CONTRACTOR Joseph Bryant Tolton PHONE: Business _____ Home 664-6418

ADDRESS 312 Beatties Ford Rd. Mooresville, NC 28115

LOCATION Hwy 3 to TR Beaty Town Rd. TR on MacLon Creek Ln. at end of road at cul de sac

SUBDIVISION Springfield BLOCK / SECTION _____ LOT 7+8 LOT AREA 6.34 ac. SITE CLASS. RS DESIGN FLOW 360 L.T.A.R. .3

Septic Tank: 1000 Gallons; STB 825 Date 5/9/96
Pump Tank: _____ Gallons; PT _____ Date _____
Pump Make: _____ Model _____ Serial No. _____
Nitrification Field: No Fields 1 Square Feet 1200 Linear Feet ~~300~~ 360
No Lines 4 Trench Width 36" Max Trench Bottom Depth 36" Gravel Depth 6" STNO

[X] New System [ ] Repair System Type: I, II, (III), IV, V, VI
System Description: GRAV. INFILTRATOR
Repair System Description: SAME
Maintenance Agreement Required: [ ] Yes [X] No


[X] House/Mod. Home No. Bedrooms 3
[ ] Mobile Home No. Bathrooms 3
[ ] Business No. Employees _____
[ ] Other _____
[X] Slab [X] Crawl Space [ ] Basement w/plumbing [ ] Basement wo/plumbing

Water Supply: [X] Individual [ ] Community [ ] Public


Comments:

Comments:

INITIAL SITE SKETCH

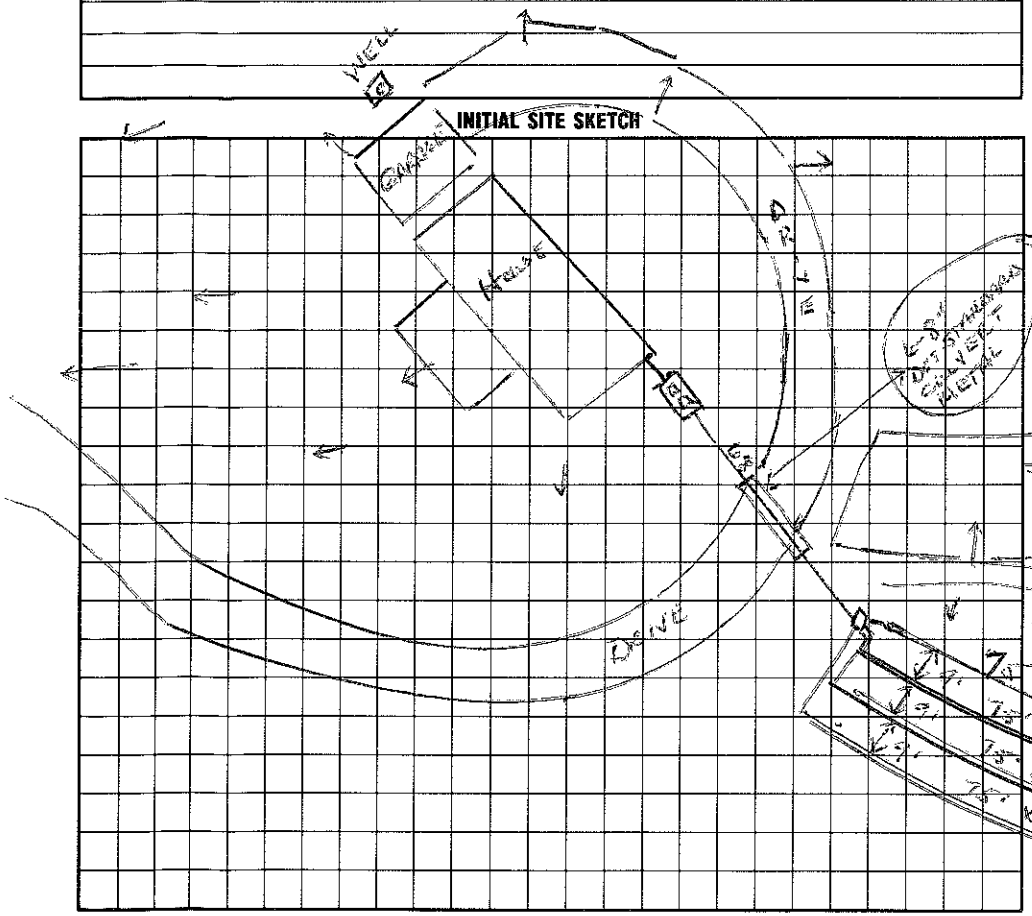


AS BUILT SKETCH

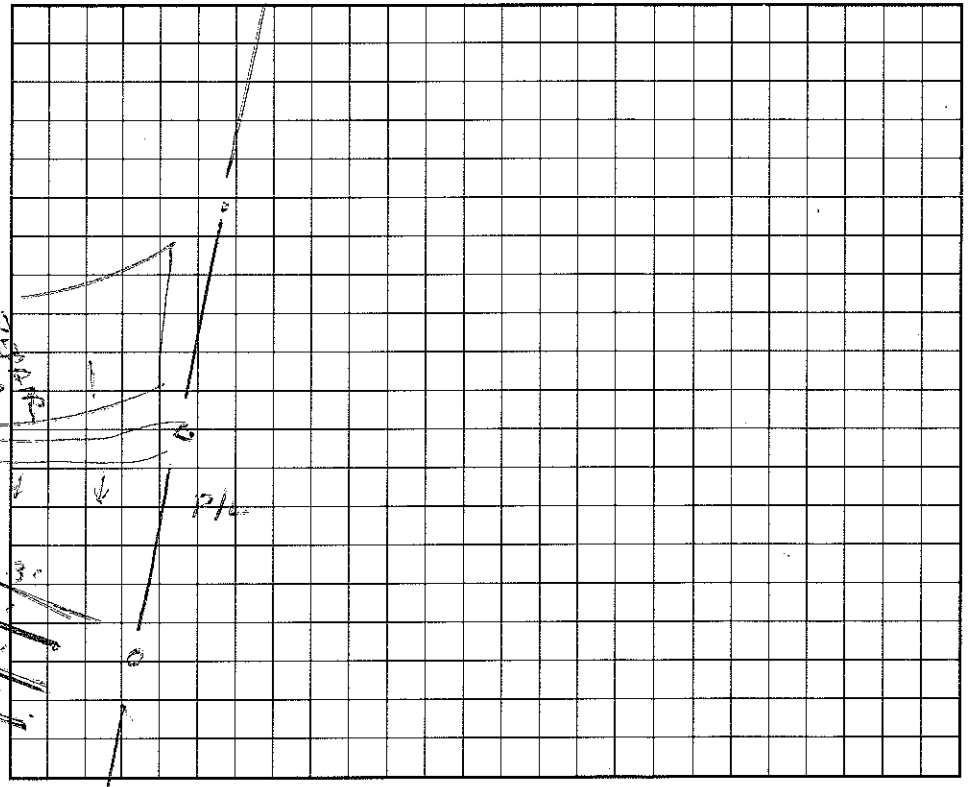


I understand that this permit can be suspended or revoked if any false information is supplied toward securing the permit/any unauthorized changes are made to the site/any unauthorized changes are made in the installation of the system.

Signed: X Joe Tolton

Improvement Permit by: Wesley Sparks RS. date 11/8/95

Existing System Inspection by: Wesley Sparks RS. date 11/8/95

Installed by: Barry Thompson

Certificate of Completion by: _____ date _____

Operation Permit by: Wesley Sparks RS. date 6/14/96

HEALTH DEPT. COPY: WHITE INSPECTION COPY (FINAL): GREEN OWNER COPY (FINAL): YELLOW INSPECTION COPY (INITIAL): PINK OWNER COPY (INITIAL): GOLD