IREDELL COUNTY HEALTH DEPARTMENT

STATESVILLE 704-878-5305 MOORESVILLE 704-664-5281

IMPROVEMENT PERMIT / CERTIFICATE OF COMPLETION / OPERATION PERMIT / EXISTING SYSTEM INSPECTION

PROPERTY DESCRIPTION NO. 16825 DATE Dec 14, '93 TAX MAP NO. 2L 9A 10 4636 193138 Watershed: ☑ Yes ☐ No

OWNER OR CONTRACTOR C.W. BREWER PHONE: Business 663-4669 Home L.N.

ADDRESS Rt 7, Box 839, Mooresville

LOCATION 1100 TR Blume TL Beechtree TR Meadow Creek Ln. on Right at Cul-d-Sac

SUBDIVISION Springfield BLOCK / SECTION ____ LOT 10 LOT AREA N102'X260' SITE CLASS RS DESIGN FLOW 360gpd L.T.A.R. .13

Septic Tank: 1000 Gallons; STB 825 RST Date 2-10-94

Pump Tank: 1000 Gallons; PT 47 RST Date 12-14-93

Pump Make: ____ Model ____ Serial No. ____

Nitrification Field: No Fields 1 Square Feet 1200 Linear Feet 400

No Lines 5 Trench Width 36" Max Trench Bottom Depth 36" Gravel Depth 12"

☑ New System ☐ Repair System Type: I, II, III, IV, V, VI

System Description: pumped to conventional

Repair System Description: SAME

Maintenance Agreement Required: ☐ Yes ☑ No

☑ House/Mod. Home No. Bedrooms 3

☐ Mobile Home No. Bathrooms 2

☐ Business No. Employees ____

☐ Other ____


☐ Slab ☑ Crawl Space ☐ Basement w/plumbing ☐ Basement wo/plumbing

Water Supply: ☑ Individual ☐ Community ☐ Public

Comments: Septic system installer to see me regarding any pump details. DRH

Comments: Liberty 3/4 HP pump used.

INITIAL SITE SKETCH

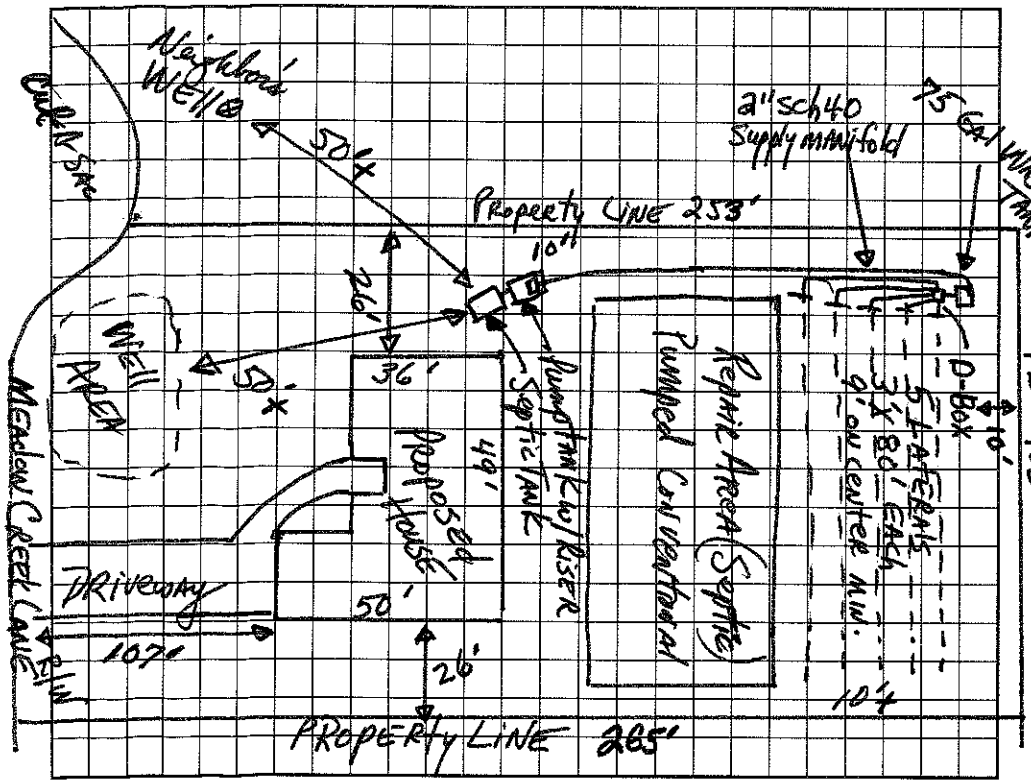

AS BUILT SKETCH

I understand that this permit can be suspended or revoked if any false information is supplied toward securing the permit/any unauthorized changes are made to the site/any unauthorized changes are made in the installation of the system. Improvement Permit is valid for 60 months from date of issuance.

Signed: Diana R. Shamburger

Improvement Permit by: Frank R. Hamm, RS date 12/14/93

Existing System Inspection by: ____ date ____

Installed by: ____

Certificate of Completion by: ____ date ____

Operation Permit by: Frank R. Hamm, RS date 4/28/94

HEALTH DEPT. COPY: WHITE INSPECTION COPY (FINAL): GREEN OWNER COPY (FINAL): YELLOW INSPECTION COPY (INITIAL): PINK OWNER COPY (INITIAL): GOLD