# IREDELL COUNTY HEALTH DEPARTMENT

STATESVILLE 704-878-5305 MOORESVILLE 704-664-5281

## IMPROVEMENT PERMIT / CERTIFICATE OF COMPLETION / OPERATION PERMIT / EXISTING SYSTEM INSPECTION

PROPERTY DESCRIPTION NO. 16109 DATE Sept. 10, '93 TAX MAP NO. part of 2F-B-10

OWNER OR CONTRACTOR Robert Chapperham Homes PHONE: Business 4656-20-0609 Home

ADDRESS 119 Cove Creek Rd.

LOCATION 100 ft. to 113 TR Cove Creek Road on left

SUBDIVISION North Shore at Pine Isle BLOCK / SECTION LOT 79/79A LOT AREA SITE CLASS 5 per 1956 L.T.A.R. .13

Water Supply: ☐ Individual ☑ Community ☐ Public Gould's IHP

Septic Tank: 1500 Gallons; STB 797 Dellinger Date 6-17-93 WE10124

Pump Tank: 1500 Gallons; PT 797 Dellinger Date 7-1-93 SN2607662

Nitrification Field: No Fields 1 Square Feet Linear Feet 270

No Lines 6 Trench Width 24" Trench Depth Gravel Depth NA

☑ New System ☐ Repair System Type: I, II, III, IV, V, VI

System Description: LPPPBPS

Repair System Description: SAME / LAKE

Maintenance Agreement Required: ☑ Yes ☐ No

☑ House/Mod. Home No. Bedrooms 4

☐ Mobile Home No. Bathrooms 2

☐ Business No. Employees

☐ Other

Garbage Disposal: ☑ Yes ☐ No

Auto. Dishwasher: ☑ Yes ☐ No


Auto. Washing Machine: ☐ Yes ☐ No

Other

☐ Slab ☑ Crawl Space ☐ Basement w/plumbing ☐ Basement wo/plumbing

Comments

INITIAL SITE SKETCH

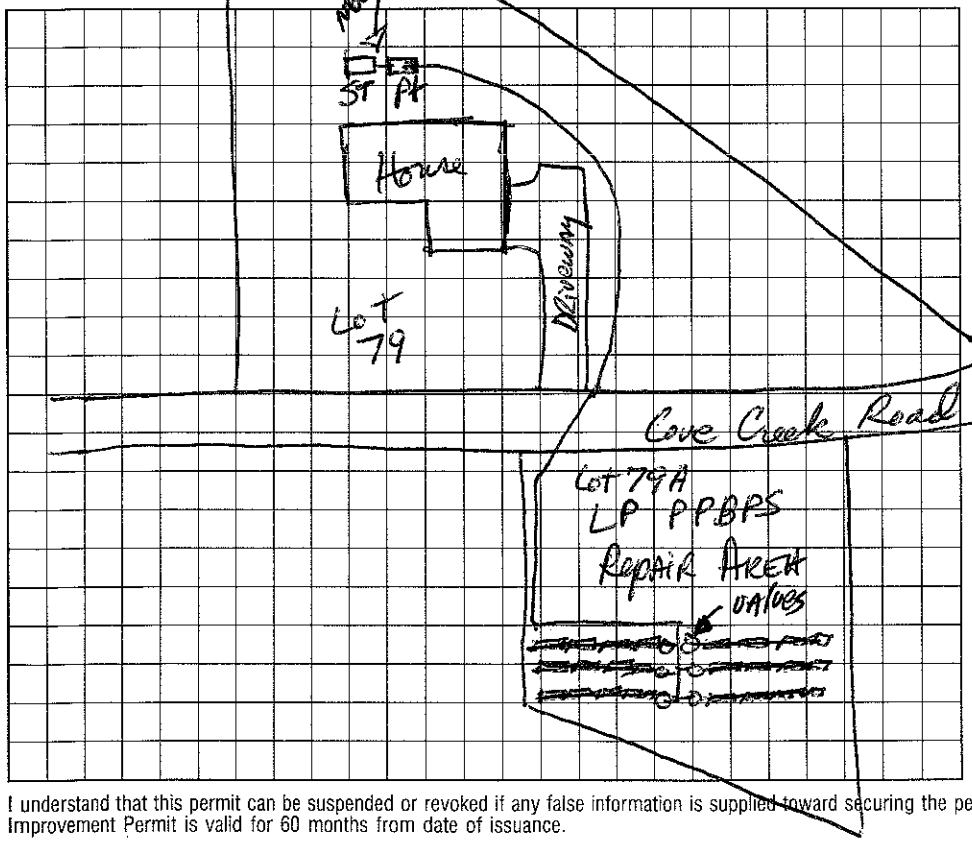


AS BUILT SKETCH

I understand that this permit can be suspended or revoked if any false information is supplied toward securing the permit/any unauthorized changes are made to the site/any unauthorized changes are made in the installation of the system. Improvement Permit is valid for 60 months from date of issuance.

Signed:

Improvement Permit by: date

Existing System Inspection by: date

Installed by: Ironhorse Grading

Certificate of Completion by: date

Operation Permit by: date 9/10/93

HEALTH DEPT. COPY: WHITE INSPECTION COPY (FINAL): GREEN OWNER COPY (FINAL): YELLOW INSPECTION COPY (INITIAL): PINK OWNER COPY (INITIAL): GOLD