IREDELL COUNTY HEALTH DEPARTMENT

STATESVILLE 704-878-5305 MOORESVILLE 704-664-5281

IMPROVEMENT PERMIT / CERTIFICATE OF COMPLETION / OPERATION PERMIT / EXISTING SYSTEM INSPECTION

PROPERTY DESCRIPTION NO. 17165 DATE Oct 27, '93 TAX MAP NO. 2623B 78 4636 20 3822 Watershed: ☑ Yes ☐ No

OWNER OR CONTRACTOR Robert Klingaman, Homes PHONE: Business 391-3715 Home LV

ADDRESS 2900 B [illegible] S. Skeenie Rd. Charlotte

LOCATION 1100 Tr 111.3 TR Cove Creek Rd. 6th lot on Rt.

SUBDIVISION North Shore BLOCK / SECTION II, 1 LOT 78 LOT AREA 3/4 Ac + SITE CLASS. PS DESIGN FLOW 360 gpd L.T.A.R. .3

Septic Tank: 1000 Gallons; STB 794 Date 12-24-93

Pump Tank: 1000 Gallons; PT 27 Date 12-24-93

Pump Make: Little Giant Model 1.65 CIM Serial No. 514620

Nitrification Field: No Fields 1 Square Feet 1200 Linear Feet 400

No Lines 3 Trench Width 36" Max Trench Bottom Depth 36" Gravel Depth 12"

☑ New System ☐ Repair System Type: I, II, III, IV, V, VI

System Description: pumped conventional

Repair System Description: SAME

Maintenance Agreement Required: ☐ Yes ☑ No

☑ House/Mod. Home No. Bedrooms 3

☐ Mobile Home No. Bathrooms 2½

☐ Business No. Employees

☐ Other


☐ Slab ☑ Crawl Space ☐ Basement w/plumbing ☐ Basement wo/plumbing

Water Supply: ☐ Individual ☑ Community ☐ Public


Comments: Follow contour with drainfield.
Dose 200 gal per 8 min cycle
Pump 5 feet @ 25 gal/min at 25' head.

Comments: Float tree, Zoeller float switches.

INITIAL SITE SKETCH

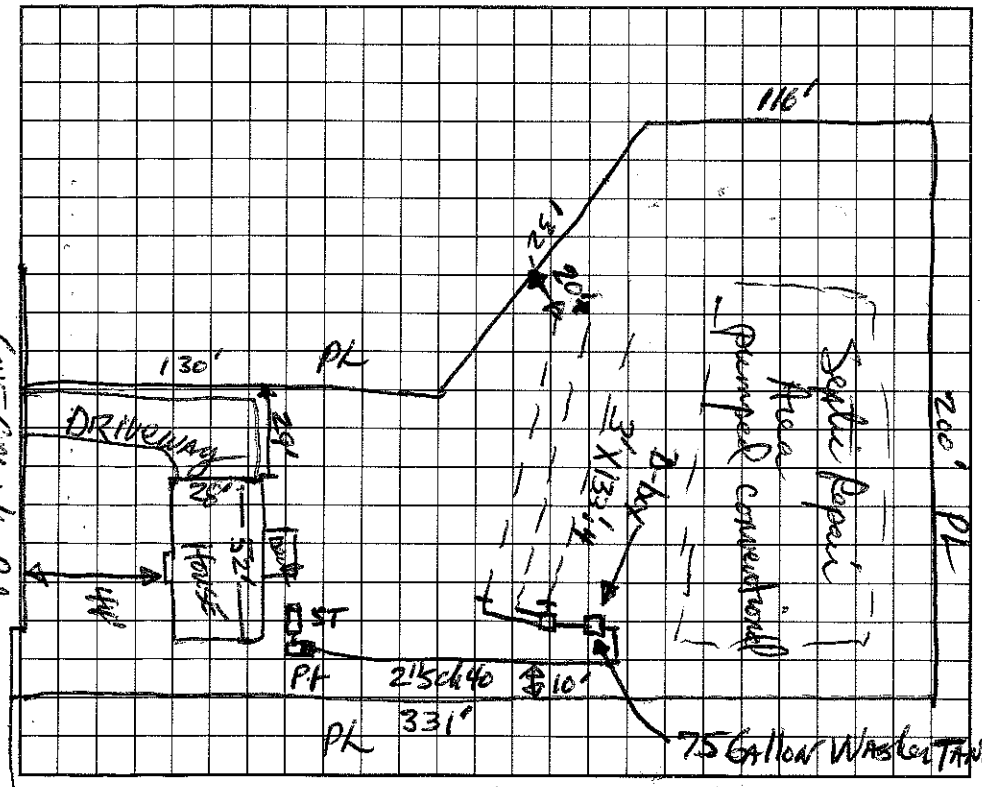

AS BUILT SKETCH

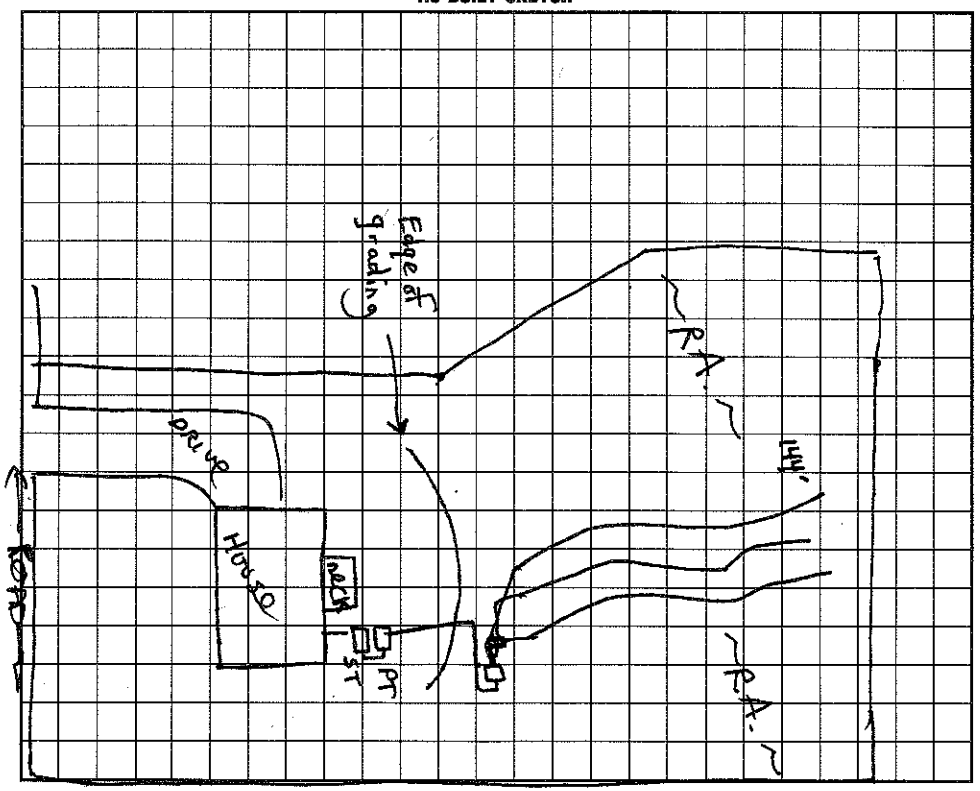

I understand that this permit can be suspended or revoked if any false information is supplied toward securing the permit/any unauthorized changes are made to the site/any unauthorized changes are made in the installation of the system. Improvement Permit is valid for 60 months from date of issuance.

Signed: [signature]

Improvement Permit by: [signature], RS date 10/27/93

Existing System Inspection by: _____ date _____

Installed by: _____

Certificate of Completion by: _____ date _____

Operation Permit by: [signature], RS date 2/10/94

HEALTH DEPT. COPY: WHITE INSPECTION COPY (FINAL): GREEN OWNER COPY (FINAL): YELLOW INSPECTION COPY (INITIAL): PINK OWNER COPY (INITIAL): GOLD