IREDELL COUNTY HEALTH DEPARTMENT

Statesville Office (704) 878-5305 Mooresville Office (704) 660-3825

(Repair) 2100 ✓

PERMIT # 203364

IMPROVEMENT PERMIT / AUTHORIZATION TO CONSTRUCT / OPERATION PERMIT / EXISTING SYSTEM

PIN # 4636207483

APPLICANT: Jarrid Lentz/Nancy Wurtz APPLICANT ADDRESS:

SITE ADDRESS: 102 High Sail Ct Mooresville NC PHONE: ALT. PHONE:

SITE DIRECTIONS: Brawley School Rd TL Isle of Pines TR 2nd Cove Creek Rd 1st lot on right

SUBDIVISION: Pine Isle SECTION: 1 LOT # 1 LOT AREA: Type II DESIGN FLOW: 480gpd L.T.A.R.: @ High Soil


Initial 1080

Existing


Septic Tank 1080 (gal)	STB 1060	Date	☒ New System	☐ Repair	☐ Expansion	System Type: I (II) III IV V VI	☐ Residence	No. Bedrooms 4	Water Supply						
Pump Tank (gal)	PJC 1060	Date	System Description: Gravity-Conventional				☐ Business	No. Persons 8	☐ Private						
Pump Make	Model	Serial #	Repair System Description: LRJPPBES				☐ Other	No. Employees	☐ Public						
# Nitrification Fields 1	# Lines 5	Linear Ft: 540ft	Maintenance Agreement Required:	☐ YES	☒ NO		☐ Slab	☒ Crawl Space	☒ Community						
Trench Width 36"	Max. Trench Bottom Depth 24-36"	Gravel Depth 12"	☒ GRAVITY	☐ PRESSURE			☐ Basement w/ plumbing		☐ Basement w/o plumbing						

Comments / Conditions: * Replace ST only hook up to existing d-box and 1 drainfield

INITIAL SITE SKETCH

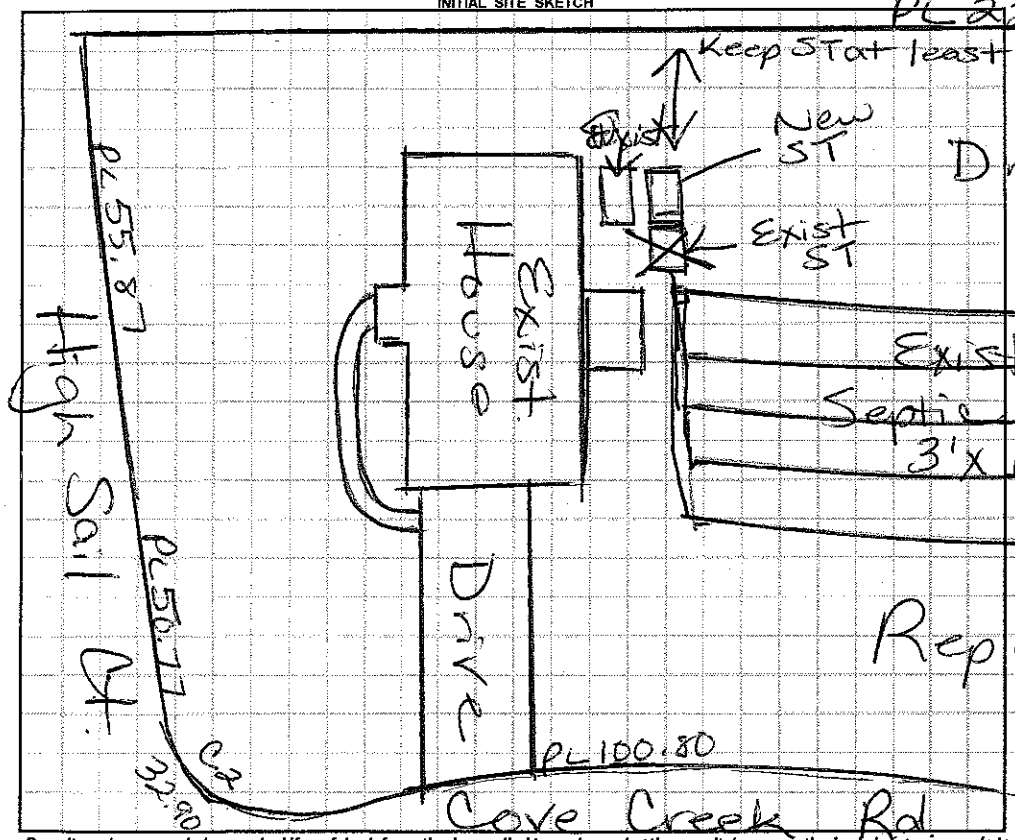

AS BUILT SKETCH

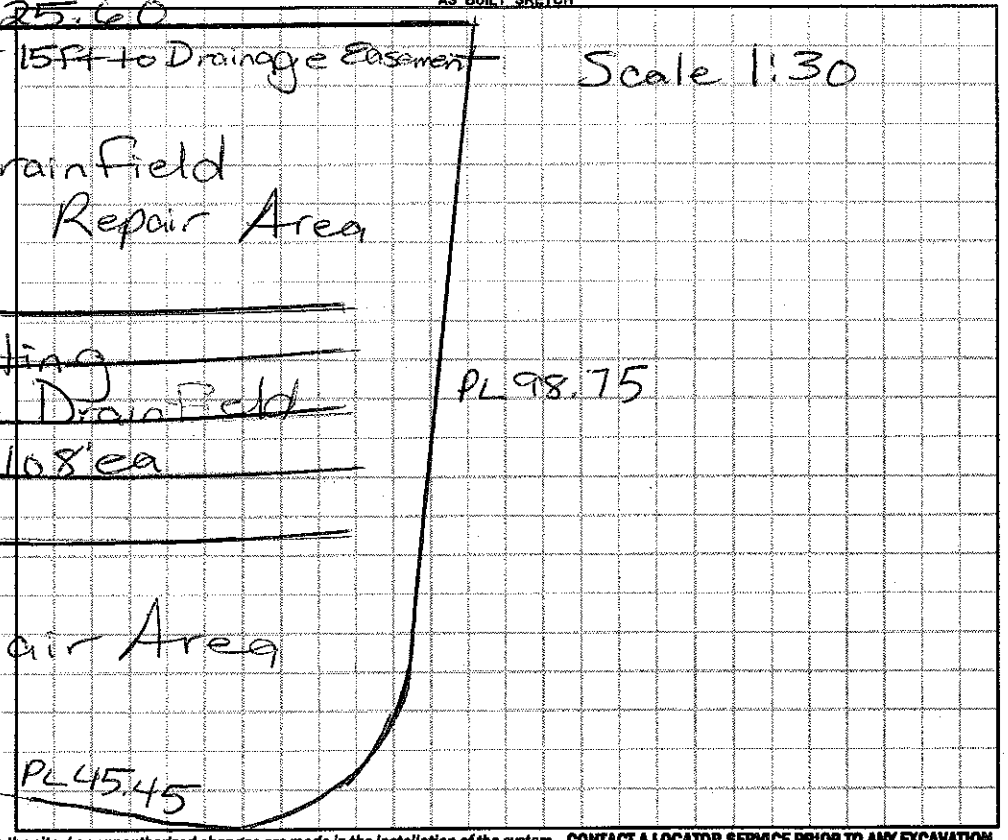

Permit can be suspended or revoked if any false information is supplied toward securing the permit / any unauthorized changes are made to the site / any unauthorized changes are made in the installation of the system. **CONTACT A LOCATOR SERVICE PRIOR TO ANY EXCAVATION**

☐ **IMPROVEMENT PERMIT** *with plat valid without expiration.* ☐ **IMPROVEMENT PERMIT** *with site plan valid for 60 mos.* ☐ **AUTHORIZATION TO CONSTRUCT** *valid for period equal to IMPROVEMENT PERMIT--not to exceed 60 mo.*

Owner / Applicant Signature: Jarrid Lentz Date: 6/18/14 Installed by: Jarrid Lentz RS

IMPROVEMENT PERMIT by: Maria H. Dotson RS Date: 6/16/14 OPERATION PERMIT by: Maria H. Dotson Date: 6/18/14

AUTHORIZATION TO CONSTRUCT by: Maria H. Dotson RS Date: 6/16/14 Existing System Inspected by: Date:

Health Dept. Copy - WHITE Applicant (Final Approval) - YELLOW Applicant (Conditional Approval) - PINK